

MILLED RUMBLE STRIPS
STA. 75+00 TO 80+00, ☐
75+98

STONE FILL, TYPE J
STA. 76+34 TO 76+40, RT

STEEL BEAM GUARDRAIL, GALVANIZED
STA. 76+11.5 TO 76+36.5, LT

STEEL BEAM GUARDRAIL, GALVANIZED
W/8 FEET POSTS
STA. 75+00.0 TO 80+00.0, RT
STA. 76+36.5 TO 80+00.0, LT
80+24.0

ANCHOR FOR STEEL BEAM RAIL
STA. 76+11.5, LT

REMOVAL AND DISPOSAL OF GUARDRAIL
STA. 75+00 TO 80+00, RT
STA. 76+11.5 TO 80+00, LT
80+24


TEMPORARY 4 INCH WHITE LINE, PAINT
DURABLE 4 INCH WHITE LINE (OPTION BID ITEM)
(ALL LINES WILL INCLUDE EDGE LINE BREAKS
AND RADII FOR SIDE ROADS)
STA. 75+00 TO 80+00, SOLID LT & RT

TEMPORARY 4 INCH YELLOW LINE, PAINT
DURABLE 4 INCH YELLOW LINE (OPTION BID ITEM)
(ALL LINES WILL INCLUDE ☐ BREAKS FOR SIDE ROADS)
STA. 75+00 TO 80+00, SOLID LT & RT

GEOTEXTILE UNDER STONE FILL
STA. 76+34 TO 76+40, RT

GRUBBING MATERIAL
STA. 76+34 TO 76+40, RT

REMOVING SIGNS
AS SHOWN - 2

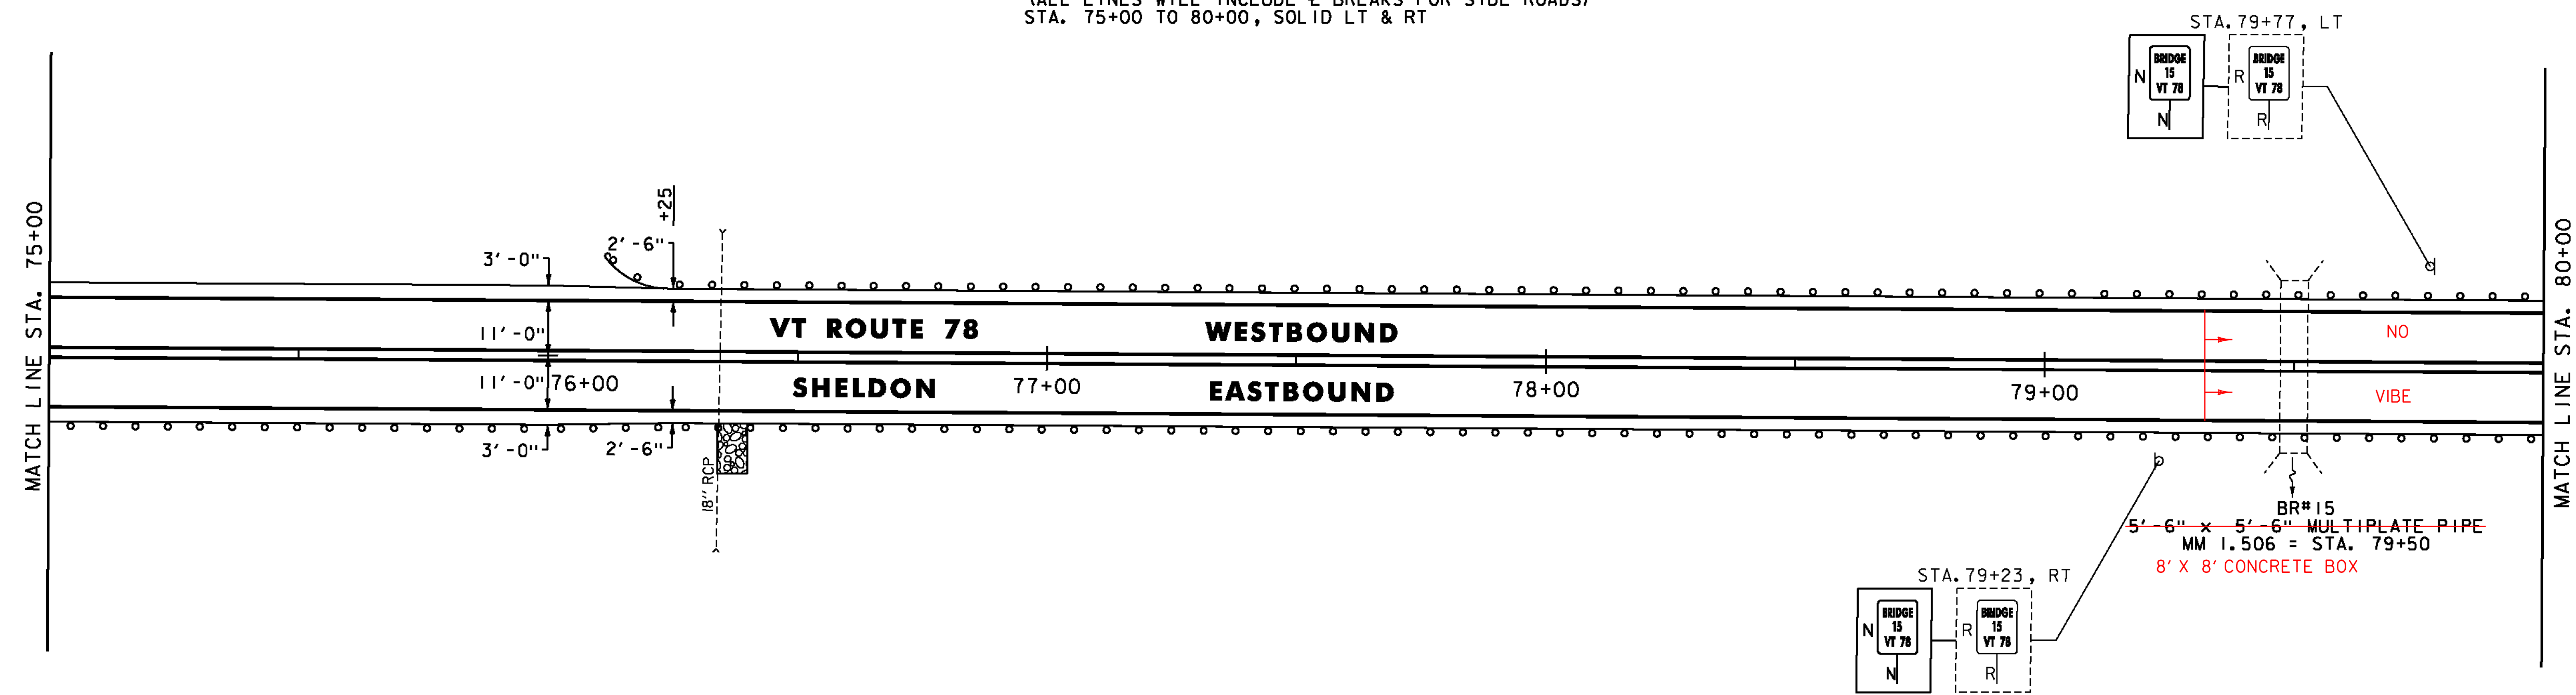

MILLED RUMBLE STRIPS
STA. 80+00 TO 85+00, ☐

STONE FILL, TYPE J
STA. 81+91 TO 82+11, LT

STEEL BEAM GUARDRAIL, GALVANIZED
STA. 81+50.0 TO 81+75.0, RT
STA. 82+31.5 TO 82+56.5, RT

STEEL BEAM GUARDRAIL, GALVANIZED
W/8 FEET POSTS
STA. 80+00.0 TO 81+50.0, RT
STA. 80+00.0 TO 85+00.0, LT
STA. 82+56.5 TO 85+00.0, RT
81+75.0
82+31.5

ANCHOR FOR STEEL BEAM RAIL
STA. 81+75.0, RT
STA. 82+31.5, RT

REMOVAL AND DISPOSAL OF GUARDRAIL
STA. 80+00 TO 81+75, RT
STA. 80+00 TO 85+00, LT
STA. 82+31.5 TO 85+00, RT


TEMPORARY 4 INCH WHITE LINE, PAINT
DURABLE 4 INCH WHITE LINE (OPTION BID ITEM)
(ALL LINES WILL INCLUDE EDGE LINE BREAKS
AND RADII FOR SIDE ROADS)
STA. 80+00 TO 85+00, SOLID LT & RT

TEMPORARY 4 INCH YELLOW LINE, PAINT
DURABLE 4 INCH YELLOW LINE (OPTION BID ITEM)
(ALL LINES WILL INCLUDE ☐ BREAKS FOR SIDE ROADS)
STA. 80+00 TO 85+00, SOLID LT & RT

GEOTEXTILE UNDER STONE FILL
STA. 81+91 TO 82+11, LT

GRUBBING MATERIAL
STA. 81+91 TO 82+11, LT

REMOVING SIGNS
AS SHOWN - 3

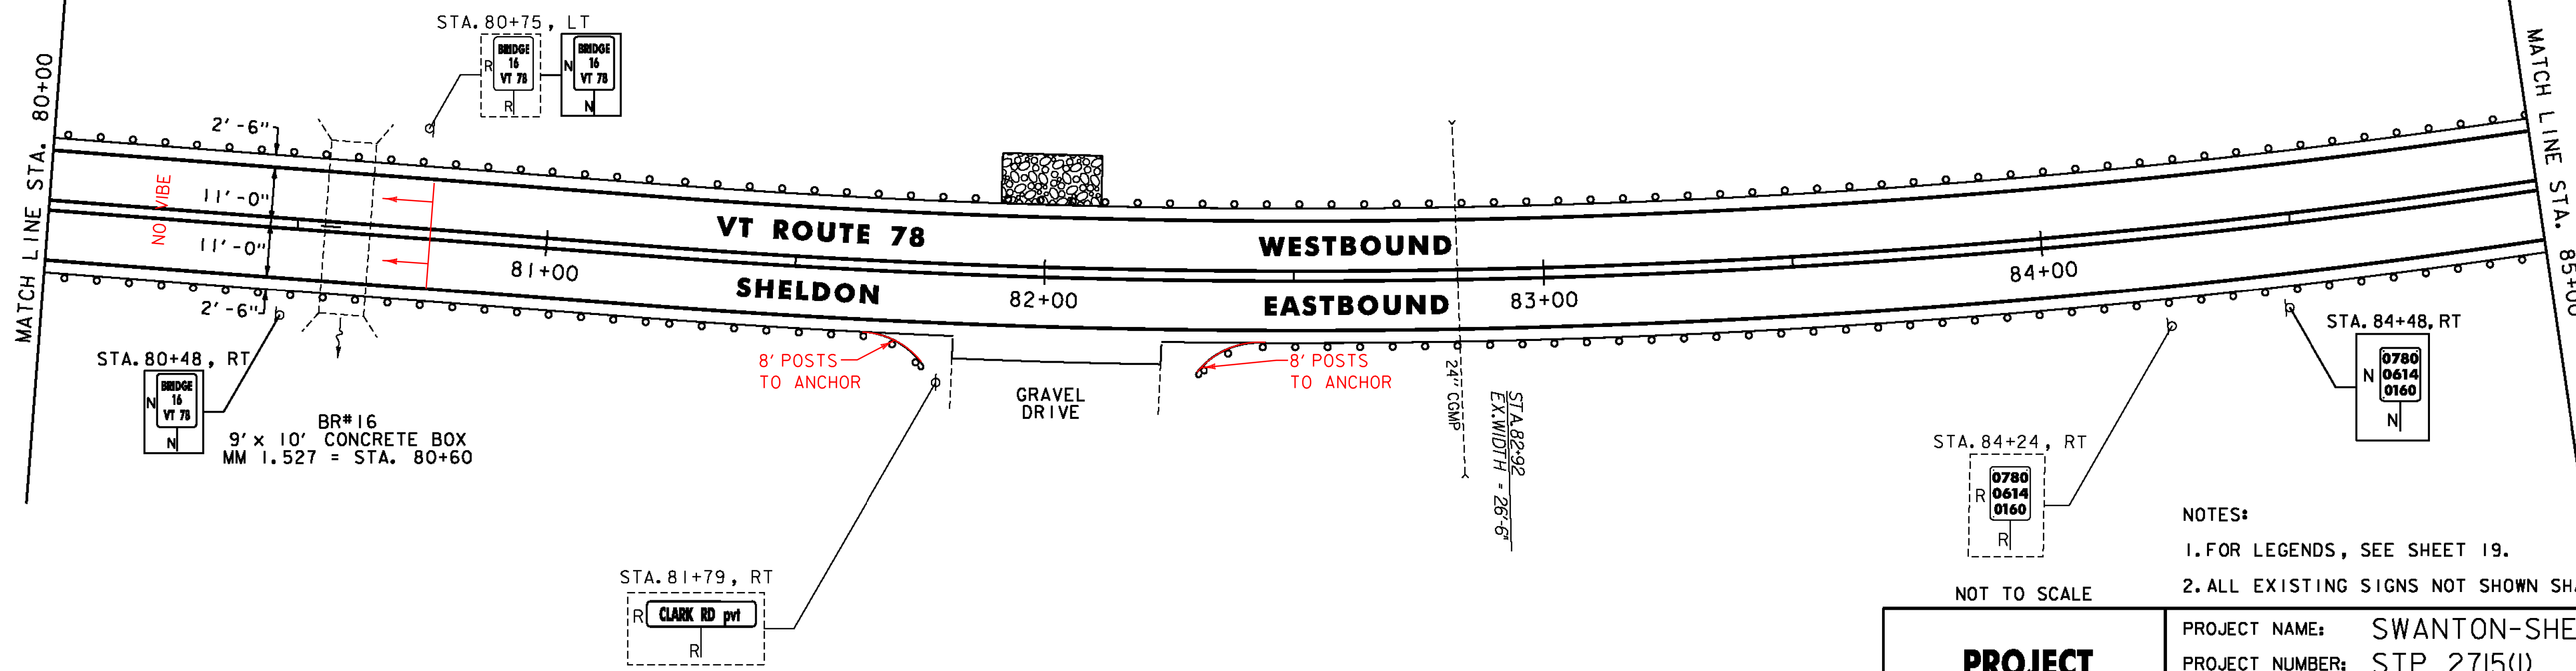

NOTES:
1. FOR LEGENDS, SEE SHEET 19.
2. ALL EXISTING SIGNS NOT SHOWN SHALL BE RETAINED.

NOT TO SCALE

PROJECT LAYOUT SHEET #63

PROJECT NAME: SWANTON-SHELDON
PROJECT NUMBER: STP 2715(I)
FILE NAME: p07cl86.dgn
PROJECT LEADER: G. EDWARDS
DESIGNED BY: G. BARRETT
PLOT DATE: 4/24/2014
DRAWN BY: G. BARRETT
CHECKED BY: M. FOISY
SHEET 81 OF 121

