

REHAB, Dis, CBs OR MHS, CLASS I OR II
 STA. 302+63, RT 304+25 LT
 STA. 303+62, RT
 STA. 305+02, RT
 STA. 305+51, LT
 STA. 306+15, RT

CHANGING ELEVATION OF SEWER MANHOLES
 STA. 303+89, LT
 STA. 305+25, RT

CAST-IN-PLACE CONCRETE CURB, TYPE B
 STA. 303+84 TO 303+96, LT
 STA. 304+18 TO 304+29, LT
 STA. 305+38 TO 305+52, RT
 STA. 306+13 TO 306+27, RT
 STA. 306+39 TO 306+50, RT

REMOVAL OF EXISTING CURB
 STA. 303+92, LT
 STA. 304+24, LT
 STA. 305+45, RT
 STA. 306+20, RT
 STA. 306+45, RT

PORTLAND CEMENT CONCRETE SIDEWALK,
 5 INCH
 STA. 303+84 TO 303+96, LT
 STA. 304+18 TO 304+29, LT
 STA. 305+38 TO 305+52, RT
 STA. 306+13 TO 306+27, RT
 STA. 306+39 TO 306+50, RT

DETECTABLE WARNING SURFACE
 STA. 303+92, LT
 STA. 304+24, LT
 STA. 305+45, RT
 STA. 306+20, RT
 STA. 306+45, RT

ADJUSTING ELEVATION OF VALVE BOX
 STA. 304+16, LT
 STA. 305+17, RT
 STA. 305+39, RT

DURABLE 4 INCH WHITE LINE
 (ALL LINES WILL INCLUDE EDGE LINE BREAKS AND
 RADIUS FOR SIDE ROADS)
 STA. 302+50 TO 306+50, SOLID LT & RT

DURABLE 4 INCH YELLOW LINE
 (ALL LINES WILL INCLUDE C BREAKS FOR SIDE ROADS)
 STA. 302+50 TO 306+50, SOLID LT & RT
 STA. 305+29, DOUBLE SOLID RT (LINCOLN AVE)

DURABLE 8 INCH WHITE LINE
 STA. 304+22 TO 304+34, LT (HYDRANT)
 (SEE DETAIL ON SHEET 14)

DURABLE 24 INCH STOP BAR
 STA. 305+29, RT (LINCOLN AVE)

DURABLE LETTER OR SYMBOL
 STA. 305+29, RT "STOP" (LINCOLN AVE)

DURABLE CROSSWALK MARKING
 STA. 303+92, LT - RT
 STA. 303+98 TO 304+16, LT
 STA. 305+14 TO 305+36, RT
 STA. 306+29 TO 306+41, RT

TEMPORARY 4 INCH WHITE LINE, PAINT
 (ALL LINES WILL INCLUDE EDGE LINE BREAKS AND
 RADIUS FOR SIDE ROADS)
 STA. 302+50 TO 306+50, SOLID LT & RT

TEMPORARY 4 INCH YELLOW LINE, PAINT
 (ALL LINES WILL INCLUDE C BREAKS FOR SIDE ROADS)
 STA. 302+50 TO 306+50, SOLID LT & RT
 STA. 305+29, DOUBLE SOLID RT (LINCOLN AVE)


TEMPORARY 8 INCH WHITE LINE, PAINT
 STA. 304+22 TO 304+34, LT (HYDRANT)
 (SEE DETAIL ON SHEET 14)

TEMPORARY 24 INCH STOP BAR, PAINT
 STA. 305+29, RT (LINCOLN AVE)

TEMPORARY LETTER OR SYMBOL, PAINT
 STA. 305+29, RT "STOP" (LINCOLN AVE)

TEMPORARY CROSSWALK MARKING, PAINT
 STA. 303+92, LT & RT
 STA. 303+98 TO 304+16, LT
 STA. 305+14 TO 305+36, RT
 STA. 306+29 TO 306+41, RT

REMOVING SIGNS
 AS SHOWN - 20

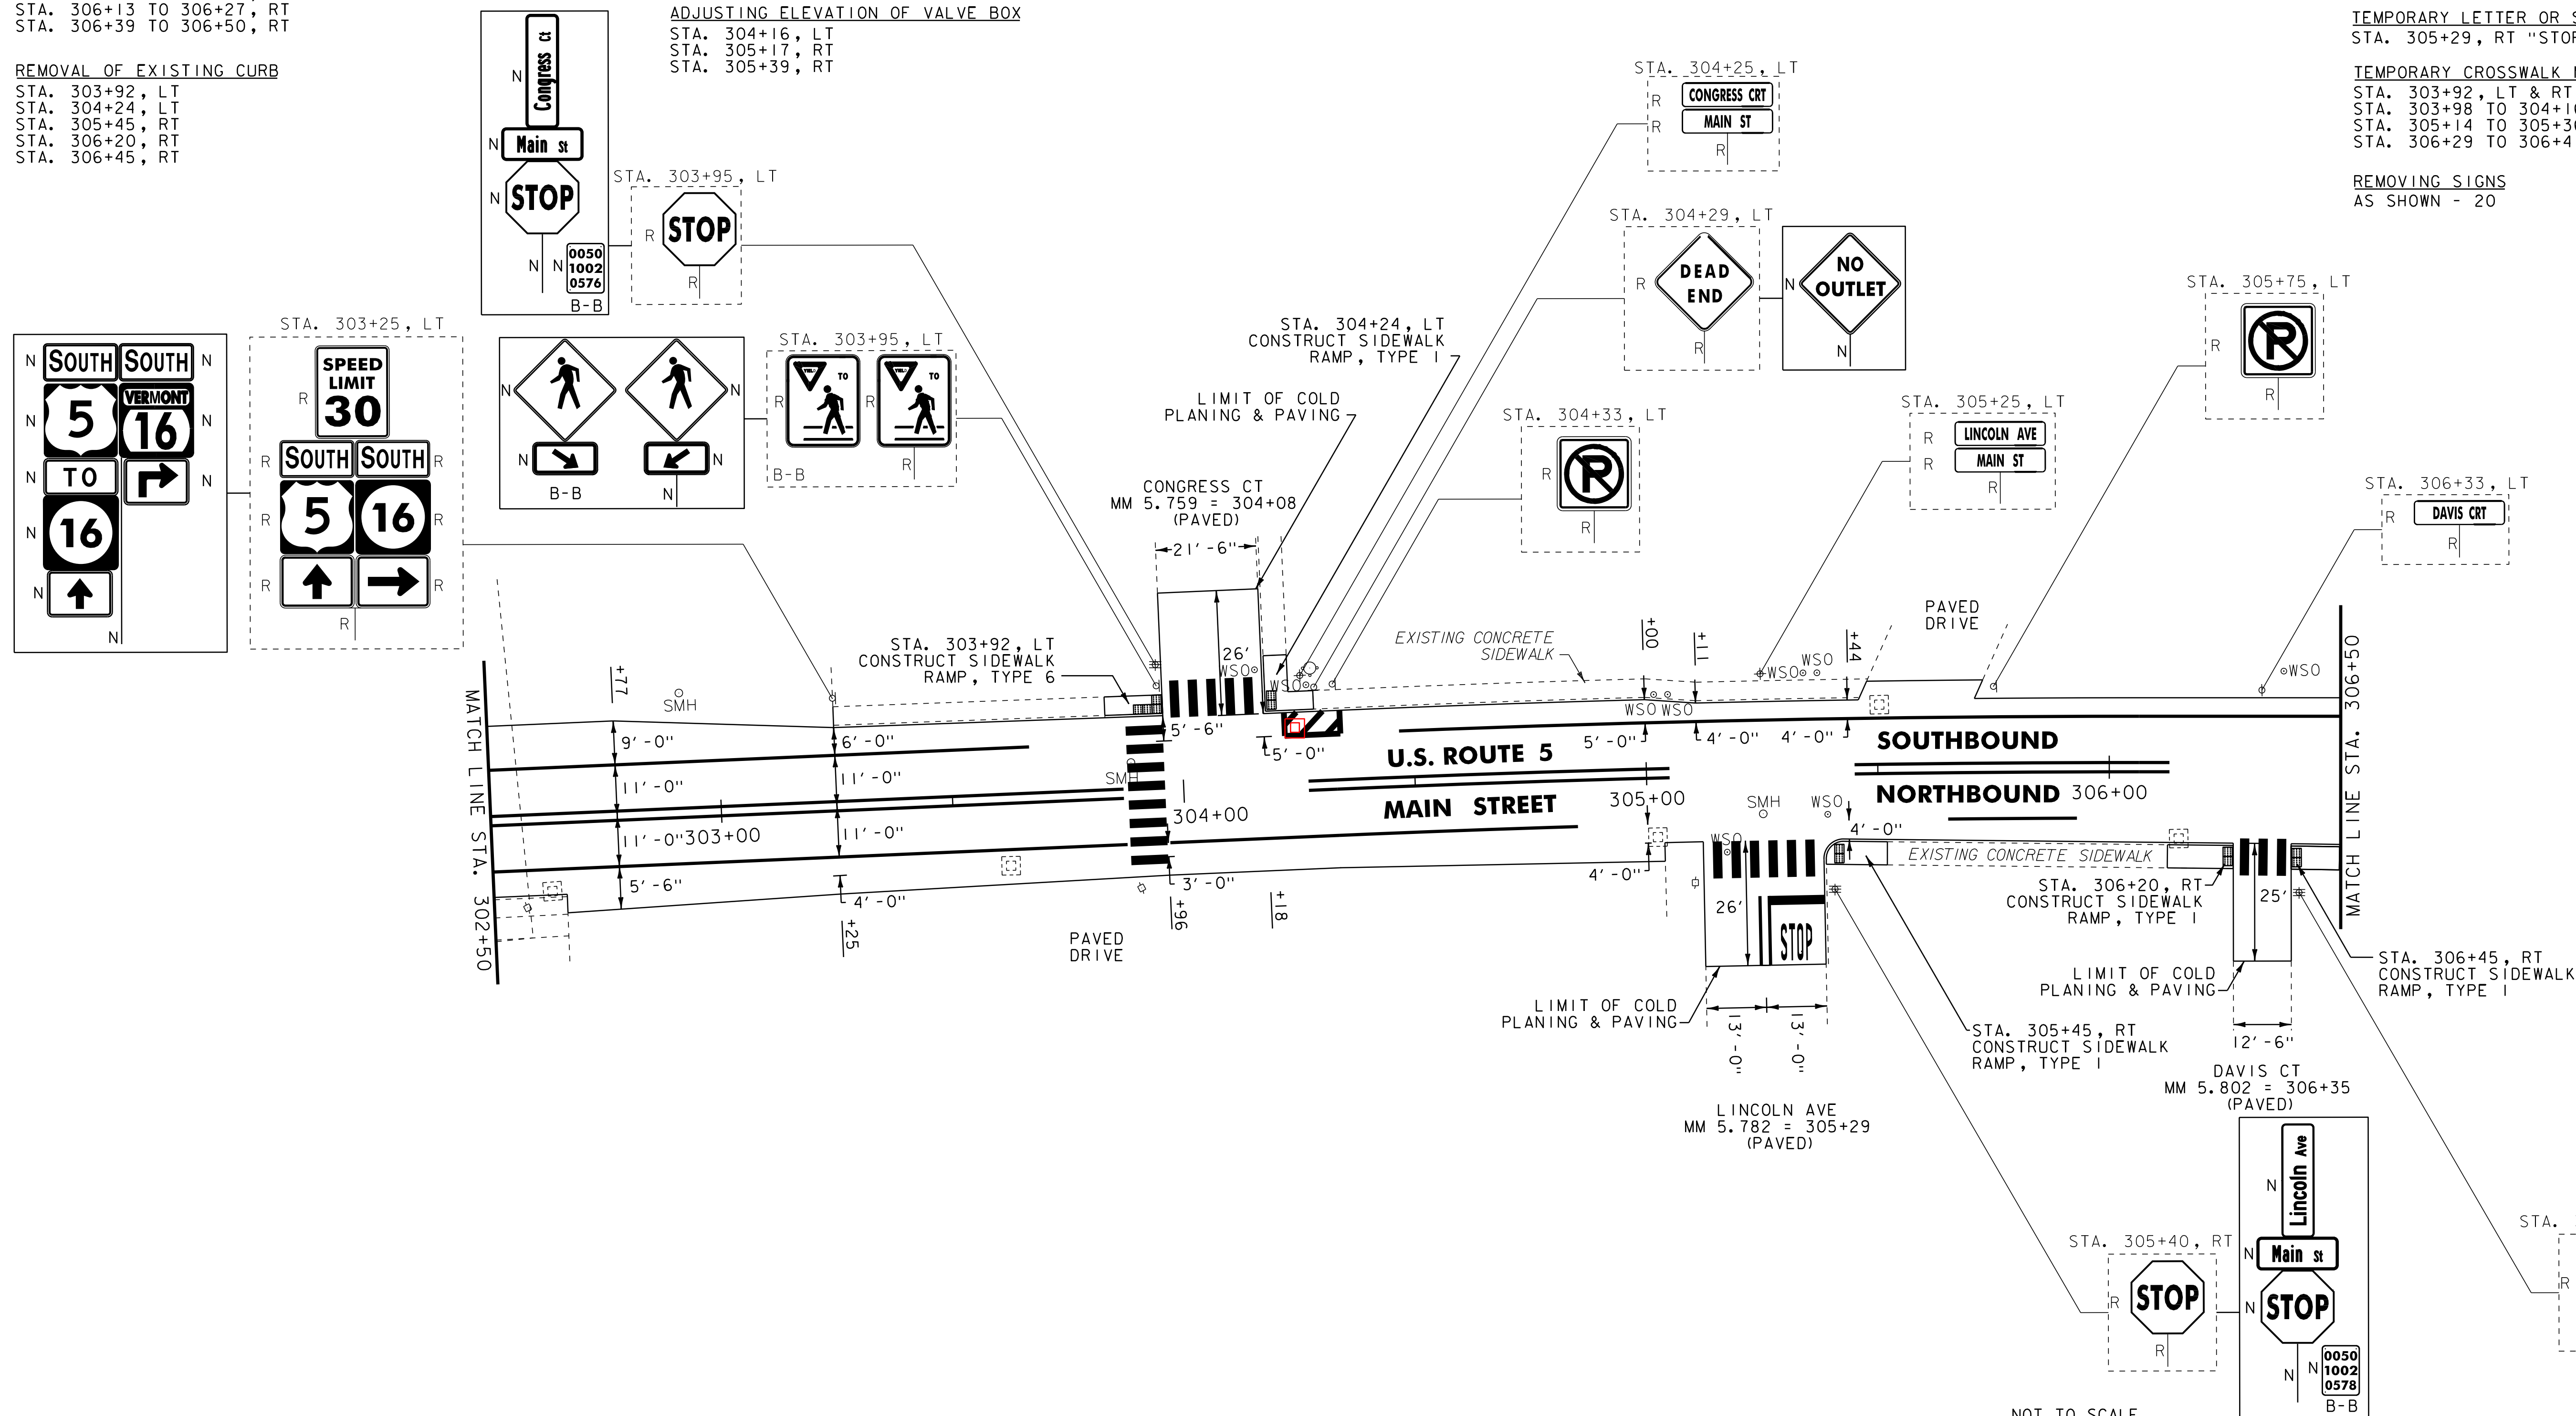

NOT TO SCALE

NOTES:
 1. FOR LEGENDS, SEE SHEET 16.
 2. ALL EXISTING SIGNS NOT SHOWN SHALL BE RETAINED.
 3. DURABLE MARKINGS DETAILED ON THIS SHEET ARE OPTION
 BID ITEMS. SEE SHEETS 5-6.



**PROJECT
 LAYOUT
 SHEET #9**

PROJECT NAME: BARTON
 PROJECT NUMBER: STP 2702(I)
 FILE NAME: p07c192.dgn
 PROJECT LEADER: JLL
 DESIGNED BY: STANTEC
 IPARM FILE: p07c192i09.i
 PLOT DATE: 30-OCT-2013 17:0
 DRAWN BY: STANTEC
 CHECKED BY: STANTEC
 SHEET 25 OF 75