

REHAB. Dis, CBs OR MHS, CLASS I OR II  
STA. 101+83, LT

CHANGING ELEVATION OF SEWER MANHOLES

STA. 101+67, LT  
STA. 102+56, LT

ADJUSTING ELEVATION OF VALVE BOX

STA. 106+34, RT


DURABLE 4 INCH WHITE LINE  
(ALL LINES WILL INCLUDE EDGE LINE BREAKS AND  
RADII FOR SIDE ROADS)  
STA. 101+50 TO 107+50, SOLID LT & RT

DURABLE 4 INCH YELLOW LINE  
(ALL LINES WILL INCLUDE @ BREAKS FOR SIDE ROADS)  
STA. 101+50 TO 107+50, SOLID LT & RT

TEMPORARY 4 INCH WHITE LINE, PAINT  
(ALL LINES WILL INCLUDE EDGE LINE BREAKS AND  
RADII FOR SIDE ROADS)  
STA. 101+50 TO 107+50, SOLID LT & RT

TEMPORARY 4 INCH YELLOW LINE, PAINT  
(ALL LINES WILL INCLUDE @ BREAKS FOR SIDE ROADS)  
STA. 101+50 TO 107+50, SOLID LT & RT

REMOVING SIGNS  
AS SHOWN - 3

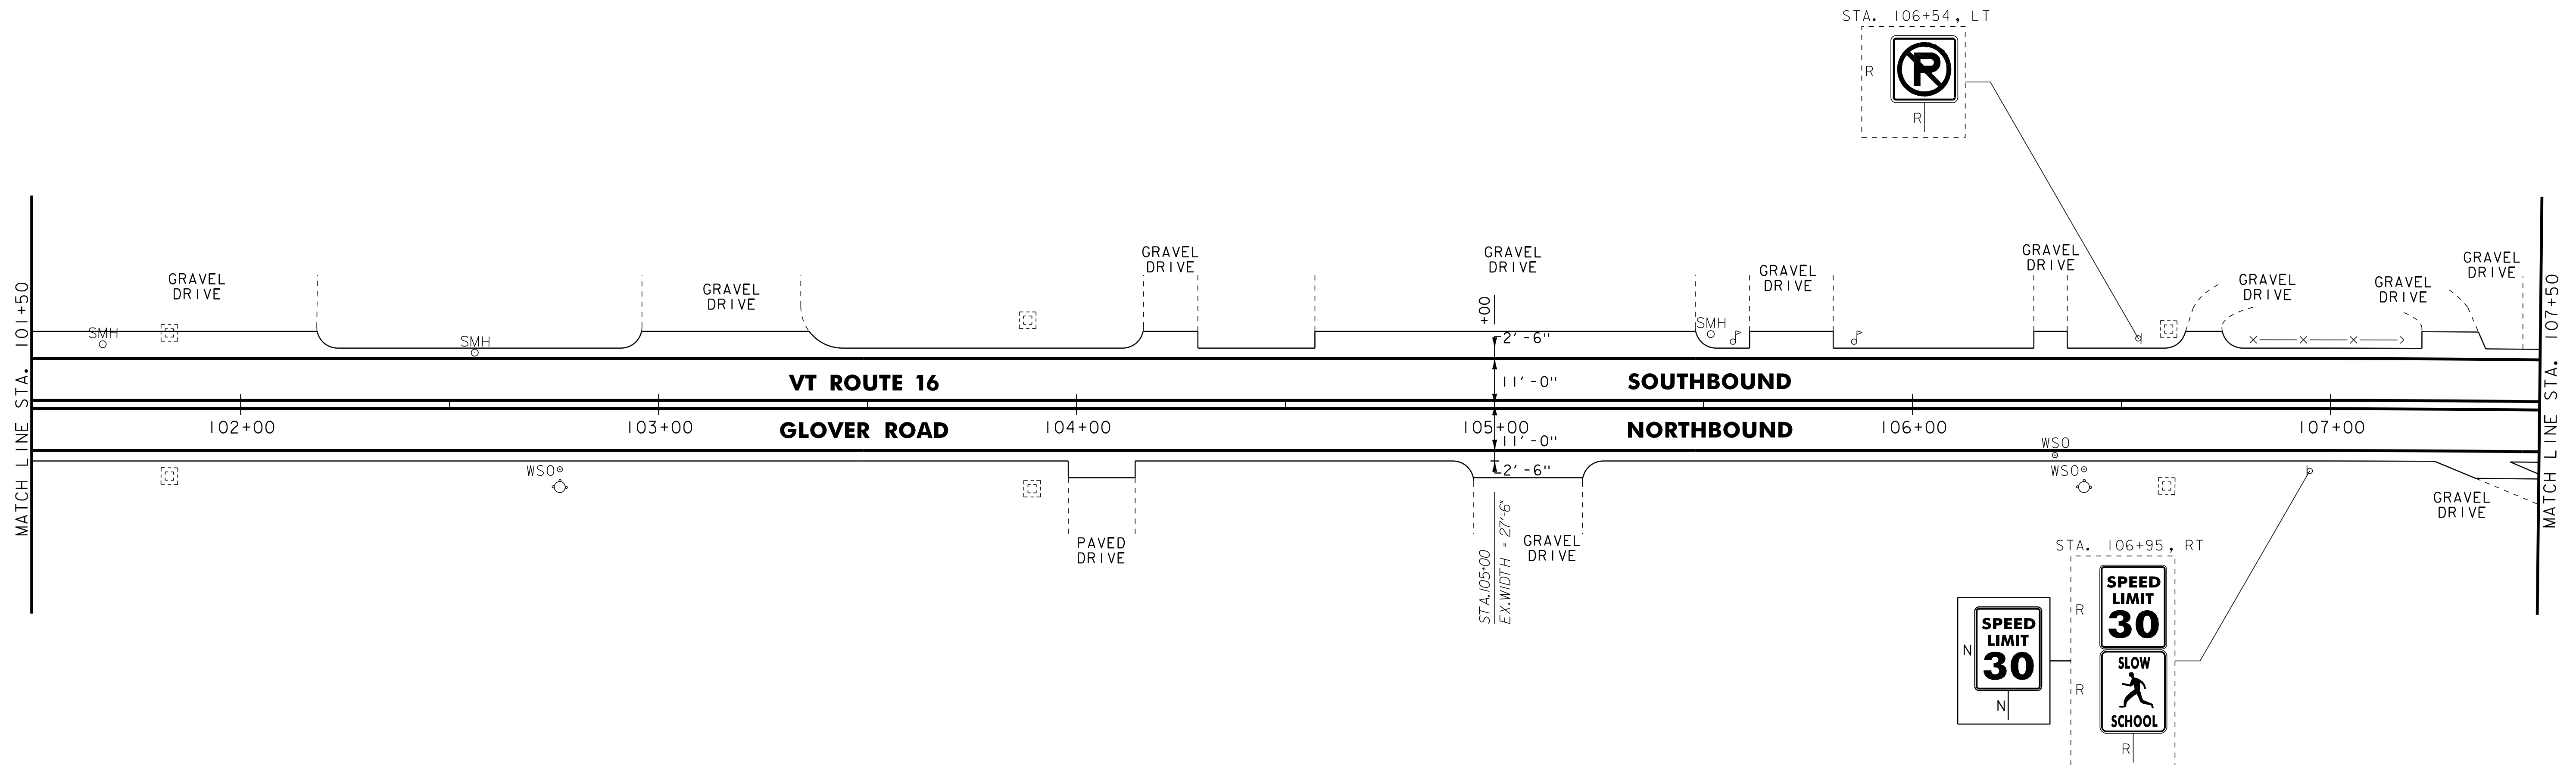

- NOTES:
1. FOR LEGENDS, SEE SHEET 16.
  2. ALL EXISTING SIGNS NOT SHOWN SHALL BE RETAINED.
  3. DURABLE MARKINGS DETAILED ON THIS SHEET ARE OPTION BID ITEMS. SEE SHEETS 5-6.

NOT TO SCALE

<b>PROJECT LAYOUT SHEET #13</b>	PROJECT NAME: BARTON	PLOT DATE: 30-OCT-2013 17:0
	PROJECT NUMBER: STP 2702(I)	DRAWN BY: STANTEC
	FILE NAME: p07c192.dgn	CHECKED BY: STANTEC
	DESIGNED BY: STANTEC	SHEET 29 OF 75
IPARM FILE: p07c192113.i		

