


TYPICAL PLAN VIEW
NOT TO SCALE

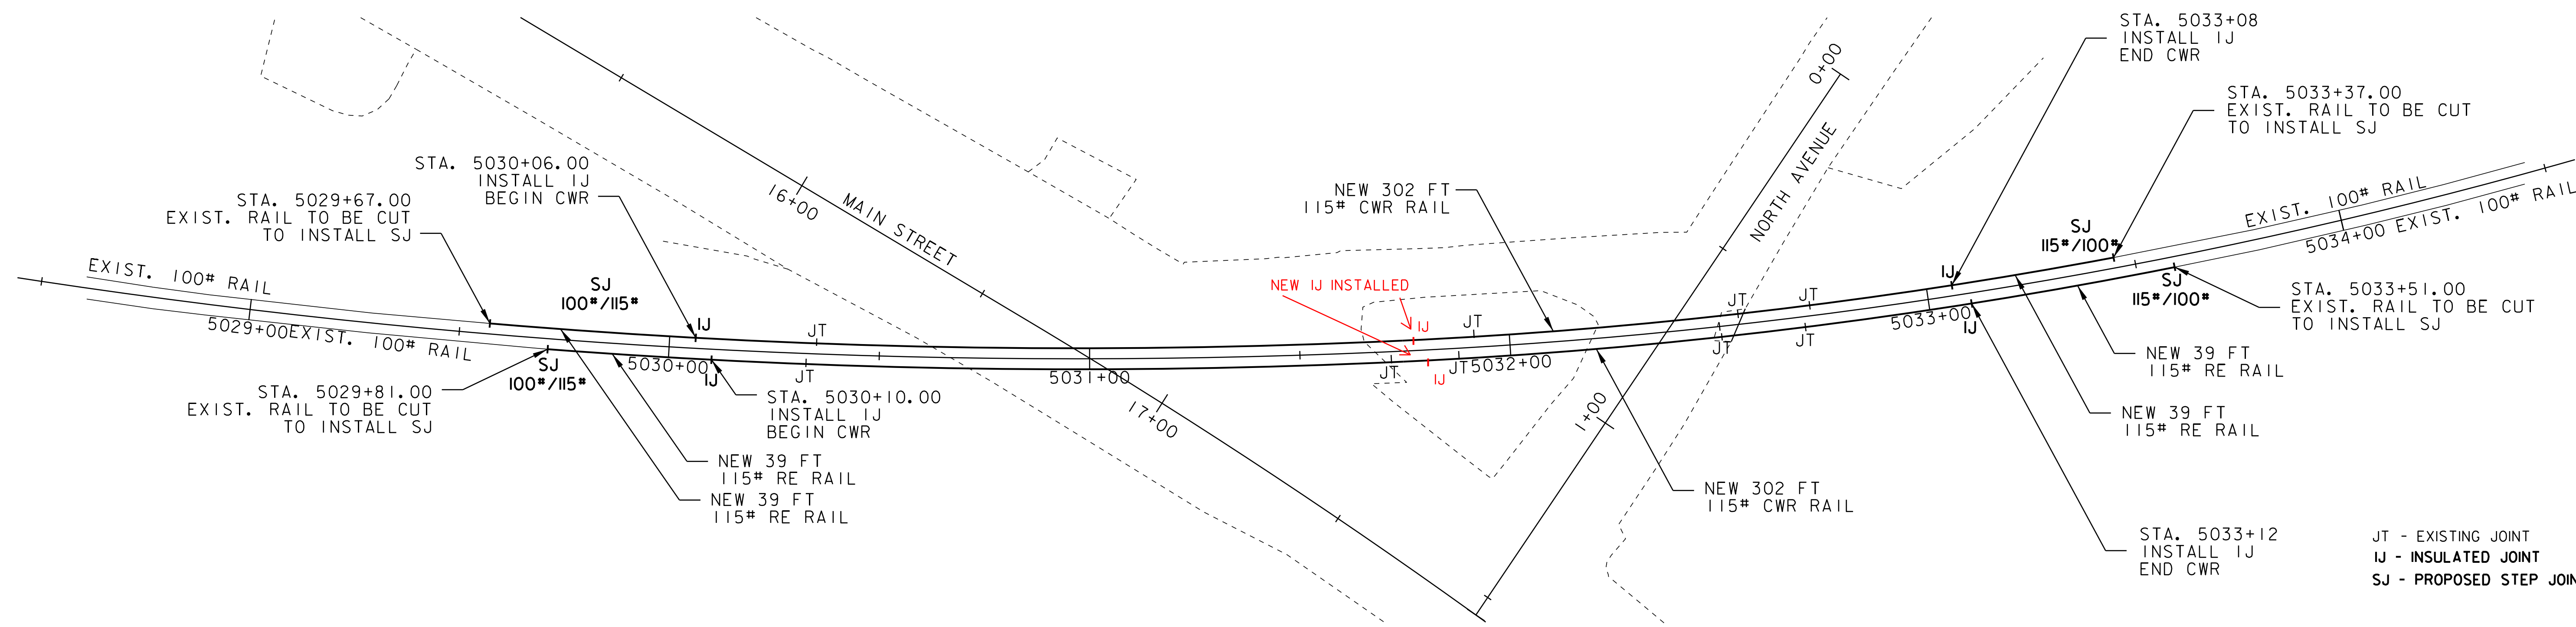

EXISTING AND PROPOSED RAIL JOINT LAYOUT
NOT TO SCALE

NOTE:
THE CONTRACTOR SHALL FIELD VERIFY THE LENGTH OF RAIL SEAL REQUIRED PRIOR TO ORDERING.



**RAILROAD
CROSSING
TYPICAL
SHEET #2**

PROJECT NAME: BARTON
PROJECT NUMBER: STP 2702(I)

FILE NAME: p07c192.dgn
PROJECT LEADER: JLL
DESIGNED BY: STANTEC
IPARM FILE: p07c192rts02.i

PLOT DATE: 30-OCT-2013 17:0
DRAWN BY: STANTEC
CHECKED BY: STANTEC
SHEET 68 OF 75