


NOTES:

- GRADES SHOWN TO THE NEAREST TENTH ARE EXISTING TOP OF RAIL
- GRADES SHOWN TO THE NEAREST HUNDREDTH ARE FINISH GRADE AT TOP OF RAIL

RAILROAD TOP OF RAIL PROFILE

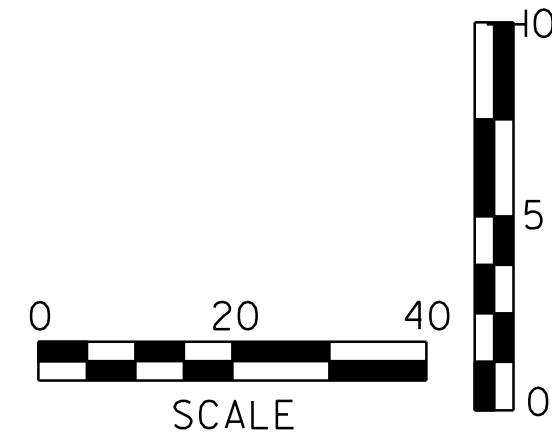

RAILROAD PROFILE SHEET	PROJECT NAME: BARTON	PLOT DATE: 30-OCT-2013 17:0
	PROJECT NUMBER: STP 2702(I)	DRAWN BY: STANTEC
	FILE NAME: p07c192.dgn	DESIGNED BY: STANTEC
	PROJECT LEADER: JLL	CHECKED BY: STANTEC
	IPARM FILE: p07c192rrps.i	SHEET 71 OF 75