

**INDEX OF SHEETS**


SEE SHEET 2 OF 116

STATE OF VERMONT  
AGENCY OF TRANSPORTATION



PROPOSED IMPROVEMENT  
TOWNS OF NORTH TROY AND TROY  
COUNTY OF ORLEANS

**PROJECT LOCATION**  
STP-HES 2718(1)  
STP 2717(1)  
STP 2620(1)  
STP 2621(1)

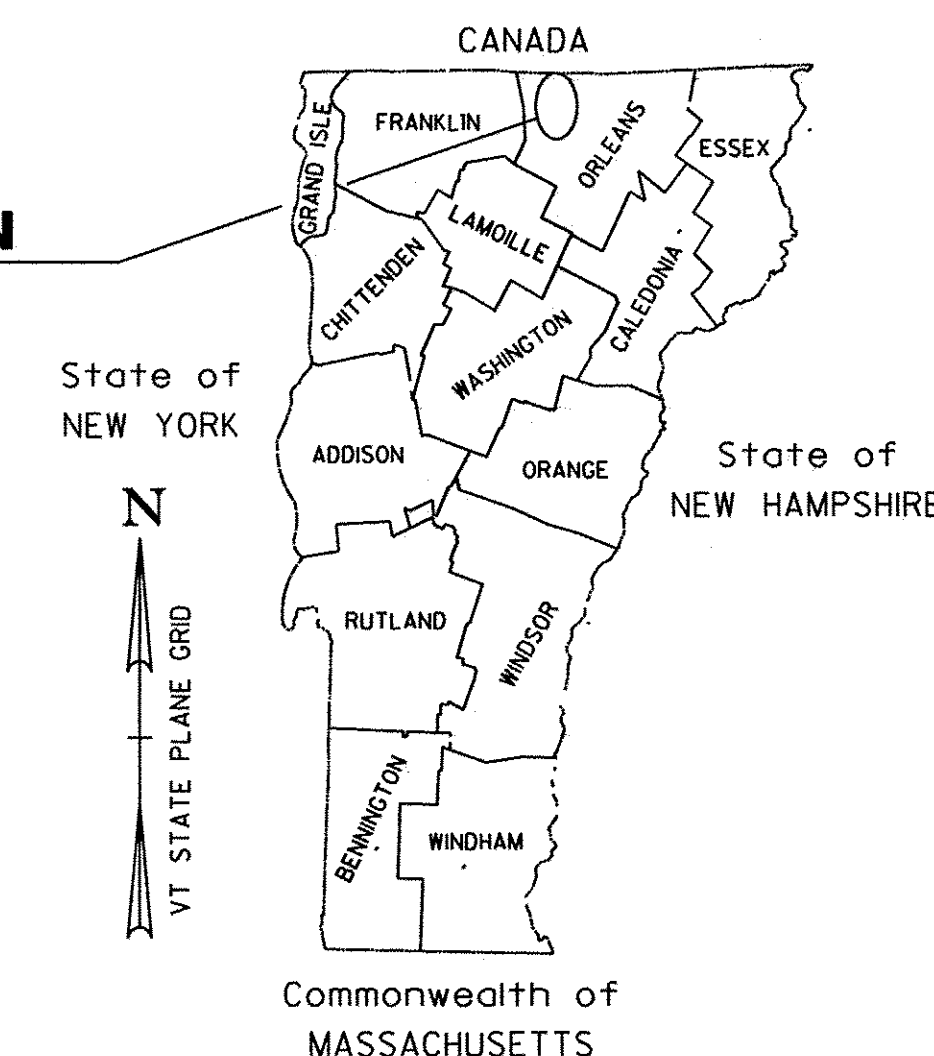

**RECORD PLANS**

CONTRACTOR: PIKE INDUSTRIES, INC. - BERLIN, VT

RESIDENT ENGINEER: KEVIN MCCLURE

CONSTRUCTION BEGAN: JUNE 25, 2009

CONSTRUCTION COMPLETE: JULY 8, 2010

RECORD PLANS BY: KEVIN MCCLURE & C. PIERCE

I HEREBY CERTIFY THAT ALL THE CONSTRUCTION REQUIRED BY THIS SET OF DRAWINGS HAS BEEN ACCOMPLISHED AS INDICATED HEREIN.

BY Kevin McClure RESIDENT ENGINEER

DATE 9-1-11

NOTE: Any further information concerning final quantities, amounts or other details relative to this project may be found at Central Files in the electronic archives.


**TROY**  
STP-HES 2718(1)  
VT ROUTE 101

**TROY**  
STP 2717(1)  
VT ROUTE 105

**NORTH TROY**  
STP 2620(1)  
VT ROUTE 105  
VT ROUTE 243

**TROY**  
STP 2621(1)  
VT ROUTE 243

SEE SHEET 8 OF 116 SEE SHEET 47 OF 116 SEE SHEET 76 OF 116 SEE SHEET 101 OF 116

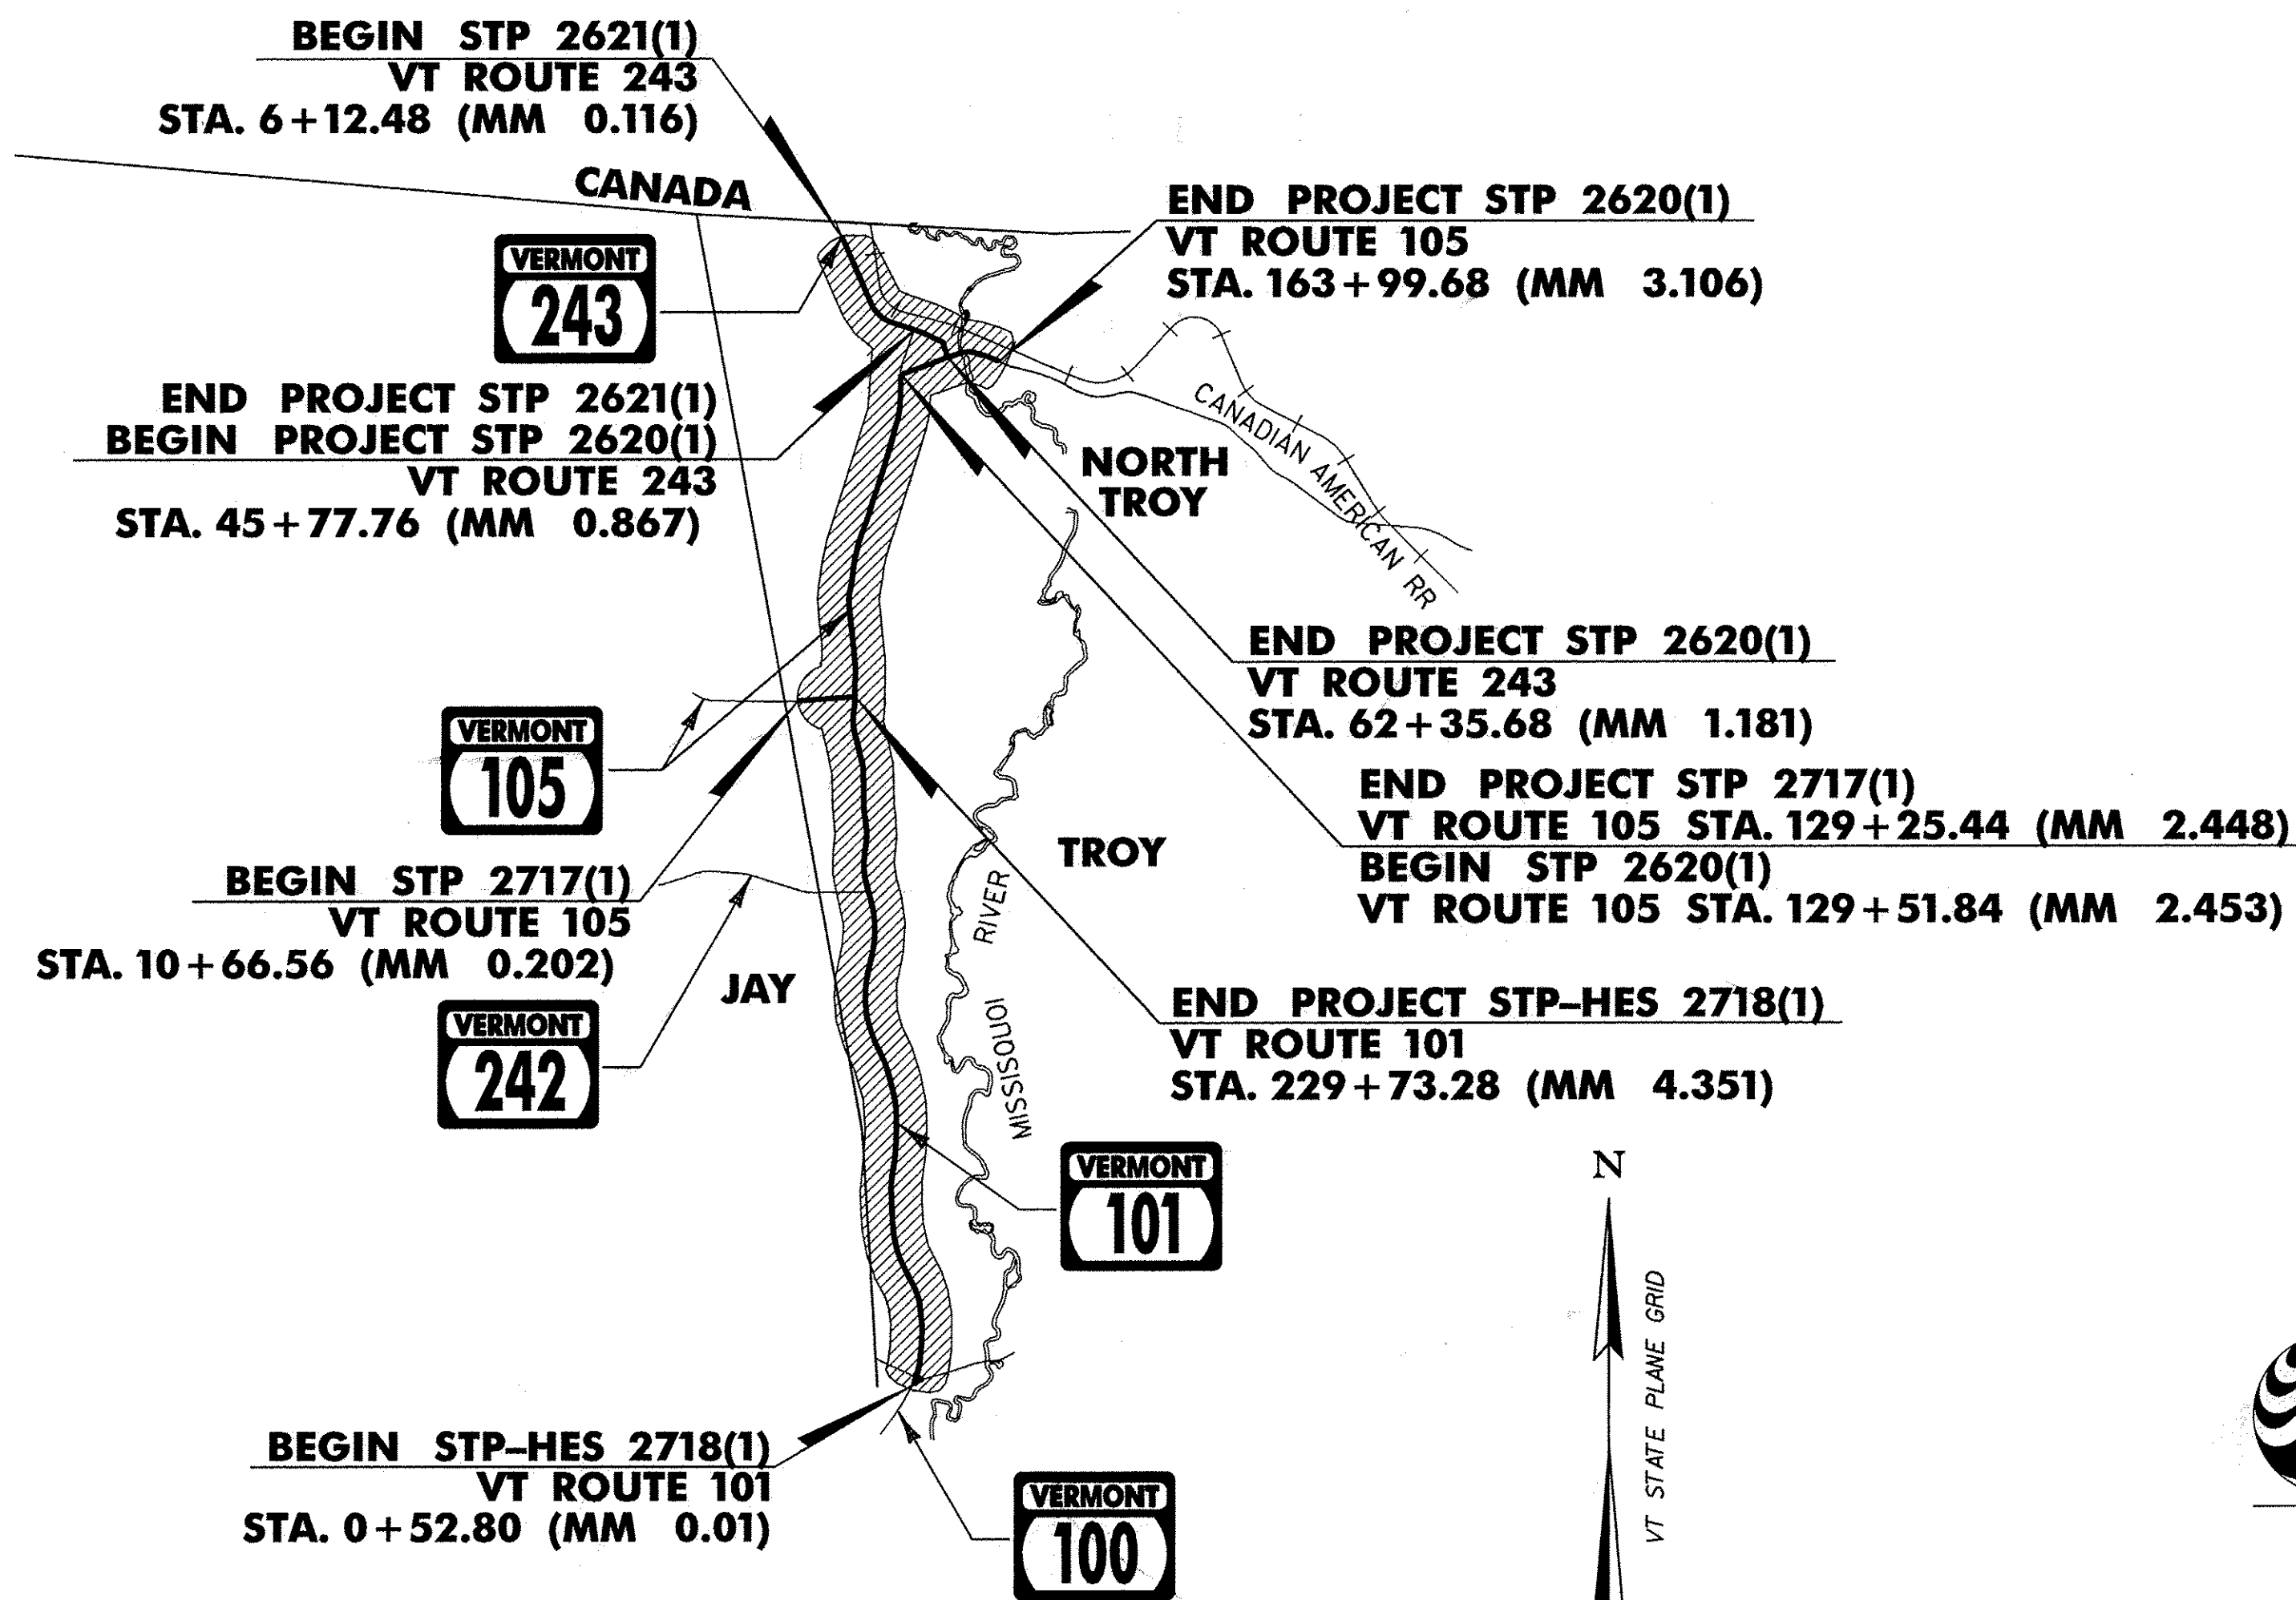

RIGHT-OF-WAY LIMITS, IF APPLICABLE, ARE PROVIDED SOLELY FOR THE CONVENIENCE OF THE STATE AND ITS CONTRACTOR DURING THE COURSE OF THIS PAVING PROJECT. ANY REFERENCES TO OFFSETS ON THESE PLANS ARE APPROXIMATE AND SHOULD NOT BE RELIED UPON FOR ANY PURPOSES.

THESE PLANS ARE SUBJECT TO SUCH ENGINEERING CHANGES AS MAY BE REQUIRED BY THE FEDERAL HIGHWAY ADMINISTRATION OR THE DIRECTOR OF PROGRAM DEVELOPMENT.

CONSTRUCTION IS TO BE CARRIED ON IN ACCORDANCE WITH THESE PLANS AND THE STANDARD SPECIFICATIONS FOR CONSTRUCTION DATED 2006, AS APPROVED BY THE FEDERAL HIGHWAY ADMINISTRATION ON JUNE 15, 2006 FOR USE ON THIS PROJECT, INCLUDING ALL SUBSEQUENT REVISIONS AND SUCH REVISED SPECIFICATIONS AND SPECIAL PROVISIONS AS ARE INCORPORATED IN THESE PLANS.

UNLESS OTHERWISE NOTED, ALL DRAWINGS AND DETAILS ON THESE PLANS ARE DRAWN "NOT TO SCALE".

**CONVENTIONAL SYMBOLS**

COUNTY LINE	
TOWN LINE	
LIMITS OF ACCESS	
POINT OF ACCESS	
FENCE LINE	
STONE WALL	
TRAVELED WAY	
GUARD RAIL	
RAILROAD	
SURVEY LINE	
CULVERT	
POWER POLE	
TELEPHONE POLE	
TREES	
CONTROL OF ACCESS	
PROPERTY LINE	
R.O.W. TAKING LINE	
SLOPE RIGHTS	
TOP OF CUT	
TOE OF SLOPE	

SURVEYED BY : N/A  
SURVEYED DATE : N/A

DATUM  
VERTICAL N/A  
HORIZONTAL N/A



Stantec

p07c200.dgn  
p07c200cts.i

DIRECTOR OF PROGRAM DEVELOPMENT	
APPROVED <u>Rusta Phelan</u> DATE <u>4-13-09</u>	
PROJECT MANAGER : TED DOMEY	
PROJECT NAME : NORTH TROY / TROY	
PROJECT NUMBER : STP-HES 2718(1)/STP 2717(1) STP 2620(1)/ STP 2621(1)	
SHEET 1 OF 116 SHEETS	