


UTILITY LEGEND	
	= EXISTING HYDRANT
	= EXISTING DI
	= EXISTING MANHOLE
	= EXISTING TELEPHONE MANHOLE
	= EXISTING ELECTRIC MANHOLE
	= EXISTING SEWER MANHOLE
	= EXISTING SEWER CLEANOUT
	= EXISTING WATER SHUTOFF
	= EXISTING GAS SHUTOFF
	= EXISTING MAILBOX
SIGN LEGEND	
N	= NEW
R	= REMOVE
R&S	= REMOVE & SALVAGE
S	= SALVAGE SIGN
RET	= RETAIN
B-B	= BACK TO BACK
R <sup>Ⓟ</sup>	= RETURN TO VAOT DISTRICT 9
R <sup>Ⓣ</sup>	= RETURN TO TOWN OF TROY



**BEGIN STP-HES 2718(1) VT ROUTE 101  
TROY STA. 0+52.80 = MM 0.010**

NOTES:  
1. ALL EXISTING SIGNS NOT SHOWN SHALL BE RETAINED.  
2. SEE LAYOUT SHEET #1B FOR PROPOSED WORK

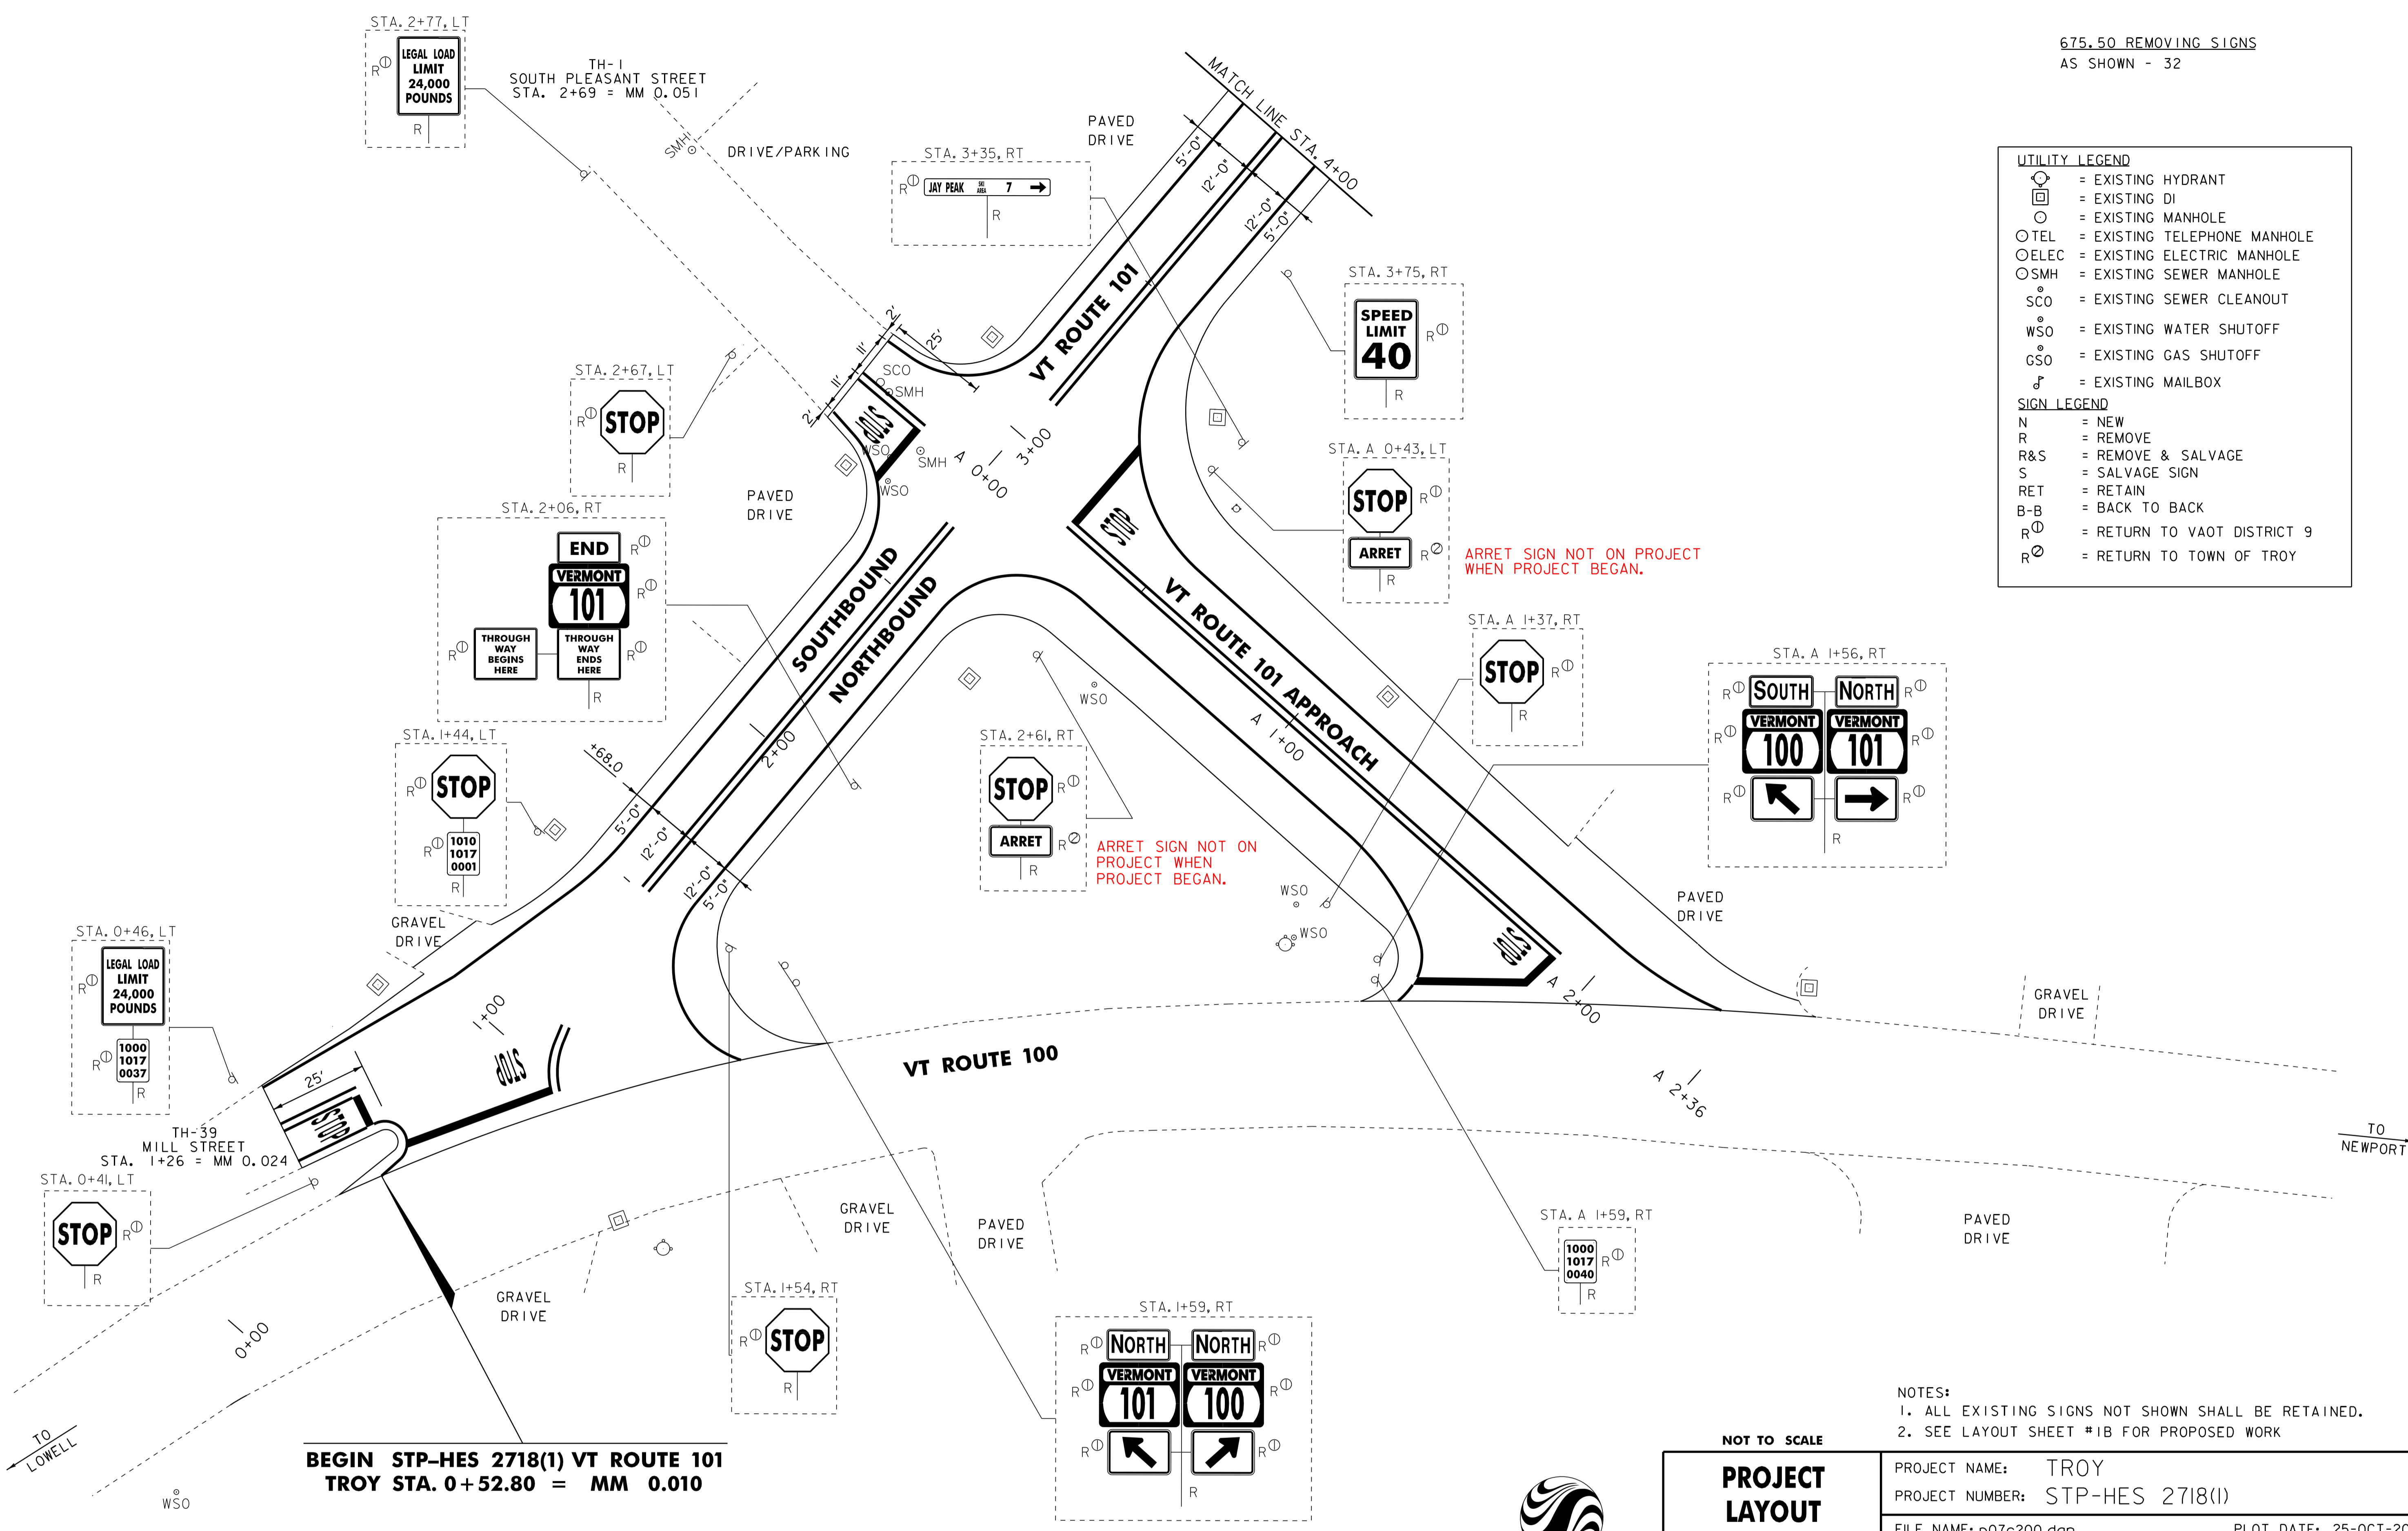

**NOT TO SCALE**  
**PROJECT LAYOUT SHEET #1A**  
**EXISTING SIGNS**

PROJECT NAME: TROY	PLOT DATE: 25-OCT-2011 13:59
PROJECT NUMBER: STP-HES 2718(1)	DRAWN BY: STANTEC
FILE NAME: p07c200.dgn	CHECKED BY: JLL
PROJECT LEADER: JLL	SHEET 16 OF 116
DESIGNED BY: MCF	
IPARM FILE: p07c200i01a.i	