

604.40 CHANGING ELEVATION OF WMH  
~~604.412, 604.415, OR 604.418 REHAB.~~  
 DI'S, CB'S OR MH'S, CLASS 1, II OR III  
 STA. 29+50, RT

646.402 DURABLE 4 INCH WHITE LINE, THERMOPLASTIC  
 STA. 27+50 TO 33+50, SOLID LT & RT


646.602 TEMPORARY 4 INCH WHITE LINE, PAINT  
 STA. 27+50 TO 33+50, SOLID LT & RT

675.50 REMOVING SIGNS  
 AS SHOWN - 2

646.412 DURABLE 4 INCH YELLOW LINE, THERMOPLASTIC  
 STA. 27+50 TO 33+50, SOLID LT & RT

646.612 TEMPORARY 4 INCH YELLOW LINE, PAINT  
 STA. 27+50 TO 33+50, SOLID LT & RT

675.60 ERECTING SALVAGED SIGNS  
 AS SHOWN - 1

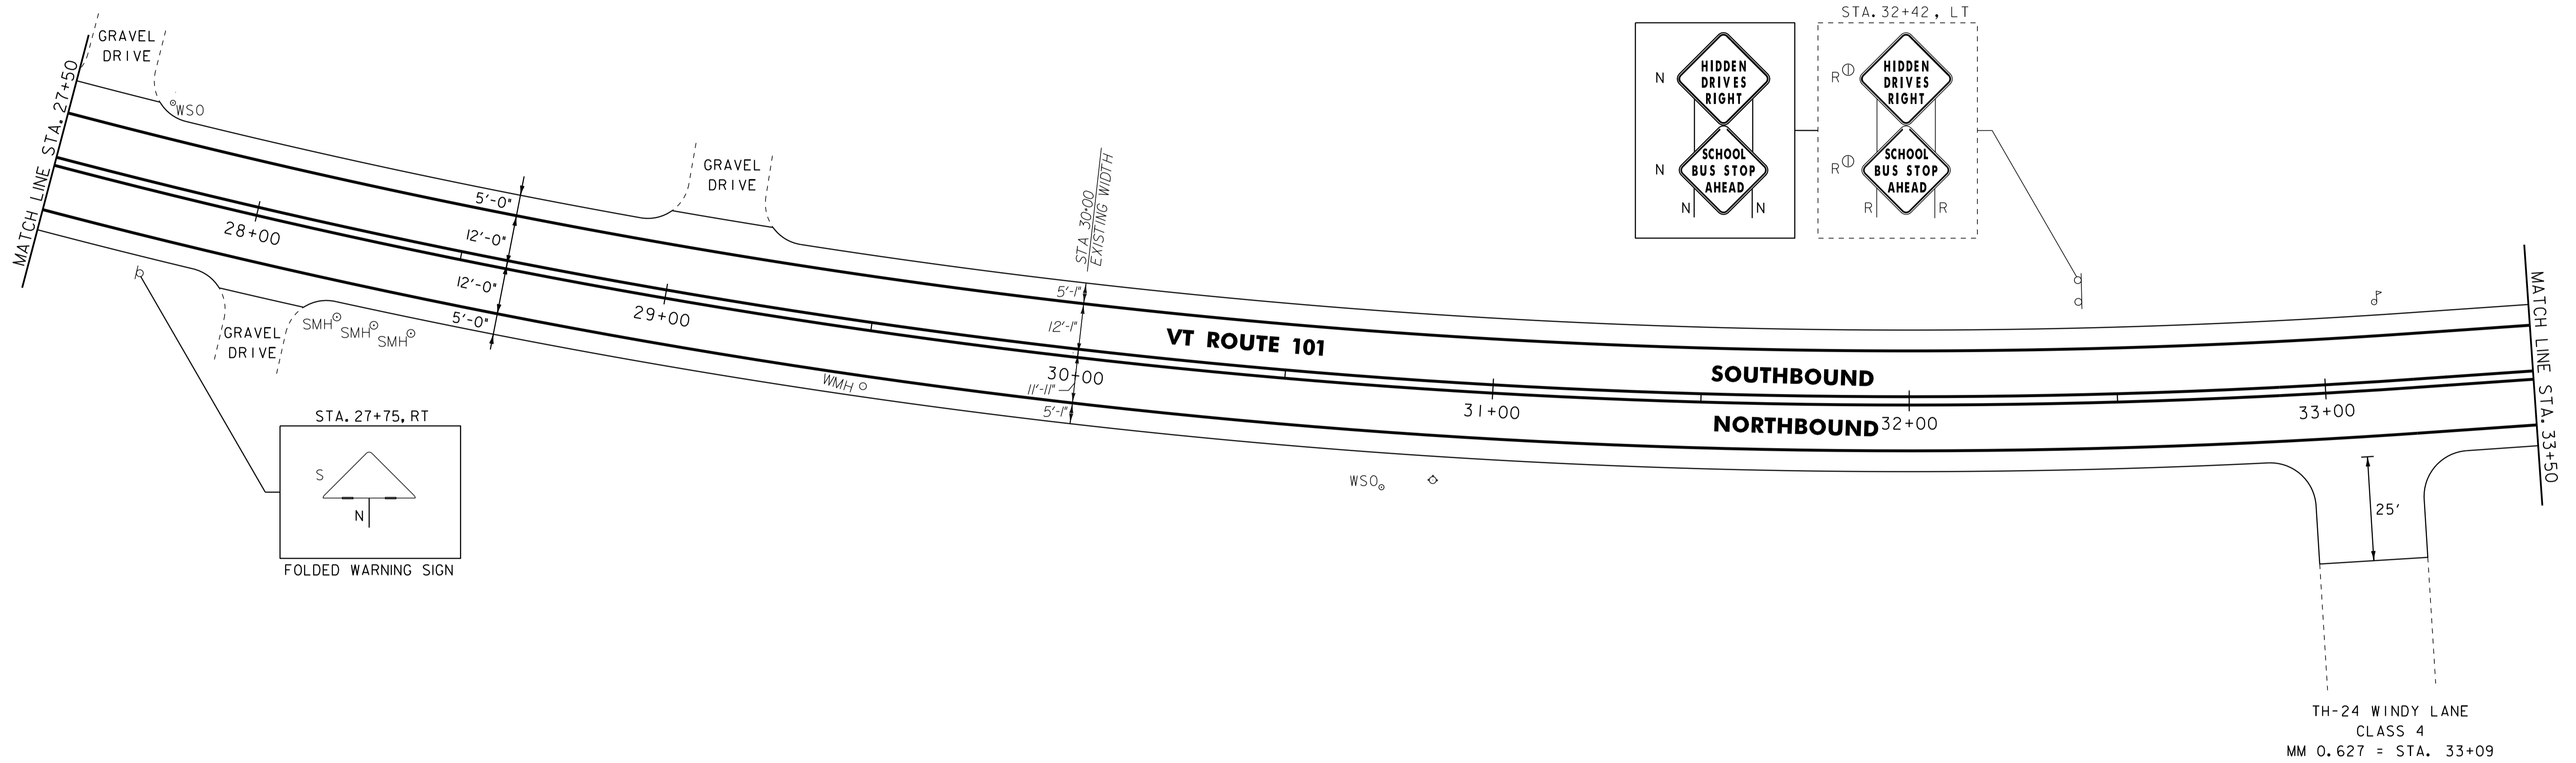

- NOTES:  
 1. ALL EXISTING SIGNS NOT SHOWN SHALL BE RETAINED.  
 2. FOR LEGENDS, SEE LAYOUT SHEET #1A.



NOT TO SCALE

**PROJECT  
 LAYOUT  
 SHEET #4**

PROJECT NAME: TROY	PLOT DATE: 25-OCT-2011 13:59
PROJECT NUMBER: STP-HES 2718(1)	DRAWN BY: STANTEC
FILE NAME: p07c200.dgn	CHECKED BY: JLL
PROJECT LEADER: JLL	SHEET 20 OF 116
DESIGNED BY: MCF	
IPARM FILE: p07c200i04.i	