

604.40 CHANGING ELEVATION OF DI
 604.412, 604.415, OR 604.418 REHAB.
 DI'S, CB'S OR MH'S, CLASS I, II OR III
 STA. 37+49, RT

616.35 TREATED TIMBER CURB
 STA. 37+49 TO 39+50, RT
 44

621.20 STEEL BEAM GUARDRAIL, GALVANIZED
 STA. 35+05 TO 39+50, LT
 STA. 37+30 TO 39+50, RT

621.50 MANUFACTURED TERMINAL SECTION, FLARED
 STA. 34+67.5 TO 35+05, LT
 STA. 36+92.5 TO 37+30, RT

621.80 REMOVAL AND DISPOSAL OF GUARDRAIL
 STA. 34+75 TO 39+50, LT
 STA. 36+97 TO 39+50, RT
 55


646.402 DURABLE 4 INCH WHITE LINE, THERMOPLASTIC
 STA. 33+50 TO 39+50, SOLID LT & RT

646.412 DURABLE 4 INCH YELLOW LINE, THERMOPLASTIC
 STA. 33+50 TO 39+50, SOLID LT & RT

646.602 TEMPORARY 4 INCH WHITE LINE, PAINT
 STA. 33+50 TO 39+50, SOLID LT & RT

646.612 TEMPORARY 4 INCH YELLOW LINE, PAINT
 STA. 33+50 TO 39+50, SOLID LT & RT

675.50 REMOVING SIGNS
 AS SHOWN - 3

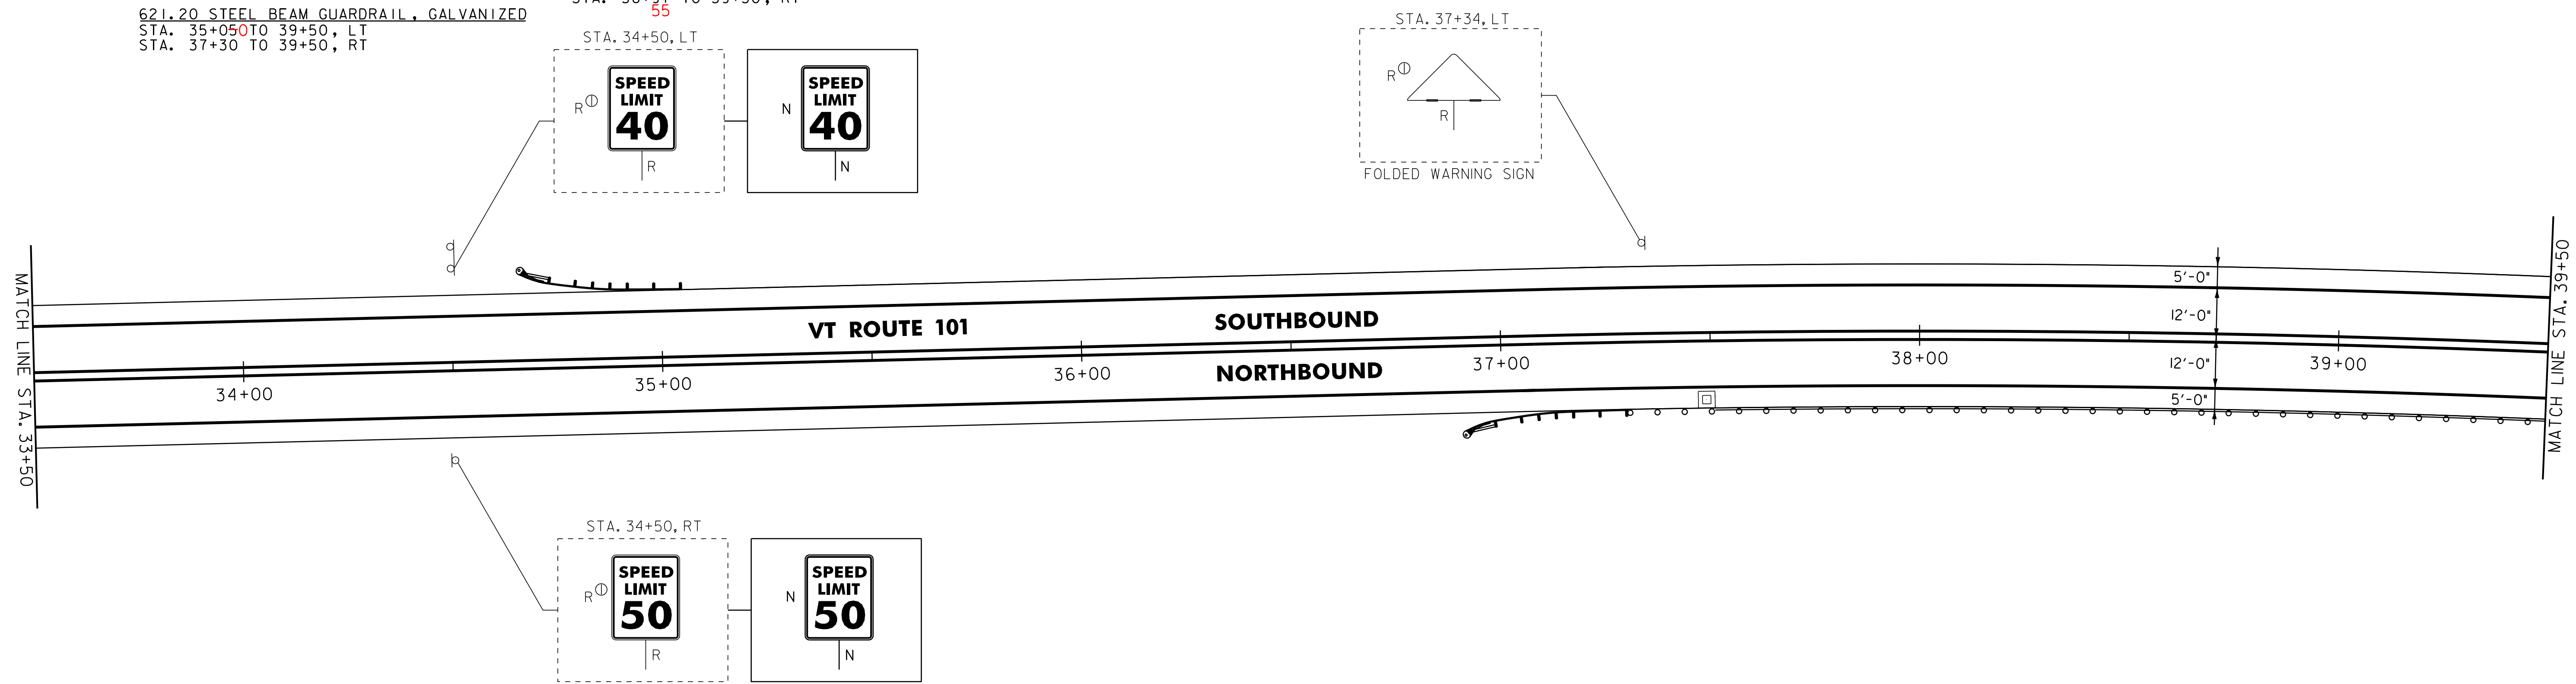

616.35 TREATED TIMBER CURB
 STA. 39+50 TO 40+77, RT
 56.5

621.20 STEEL BEAM GUARDRAIL, GALVANIZED
 STA. 39+50 TO 40+67.5, LT 40+50
 STA. 39+50 TO 40+67.5, RT 40+55
 STA. 43+72.5 TO 45+50, RT
 78

621.50 MANUFACTURED TERMINAL SECTION, FLARED
 STA. 40+67.5 TO 41+05, LT 40+87.5
 STA. 40+67.5 TO 41+05, RT 40+92.5
 STA. 43+35 TO 43+72.5, RT
 40.5 78

621.80 REMOVAL AND DISPOSAL OF GUARDRAIL
 STA. 39+50 TO 40+77, RT 92.5
 STA. 39+50 TO 41+05, LT 40+87.5
 STA. 43+35 TO 45+50, RT
 40

646.402 DURABLE 4 INCH WHITE LINE, THERMOPLASTIC
 STA. 39+50 TO 45+50, SOLID LT & RT


646.412 DURABLE 4 INCH YELLOW LINE, THERMOPLASTIC
 STA. 39+50 TO 45+50, SOLID LT & RT

646.602 TEMPORARY 4 INCH WHITE LINE, PAINT
 STA. 39+50 TO 45+50, SOLID LT & RT

646.612 TEMPORARY 4 INCH YELLOW LINE, PAINT
 STA. 39+50 TO 45+50, SOLID LT & RT

675.50 REMOVING SIGNS
 AS SHOWN - 2

675.60 ERECTING SALVAGED SIGNS
 AS SHOWN - 1

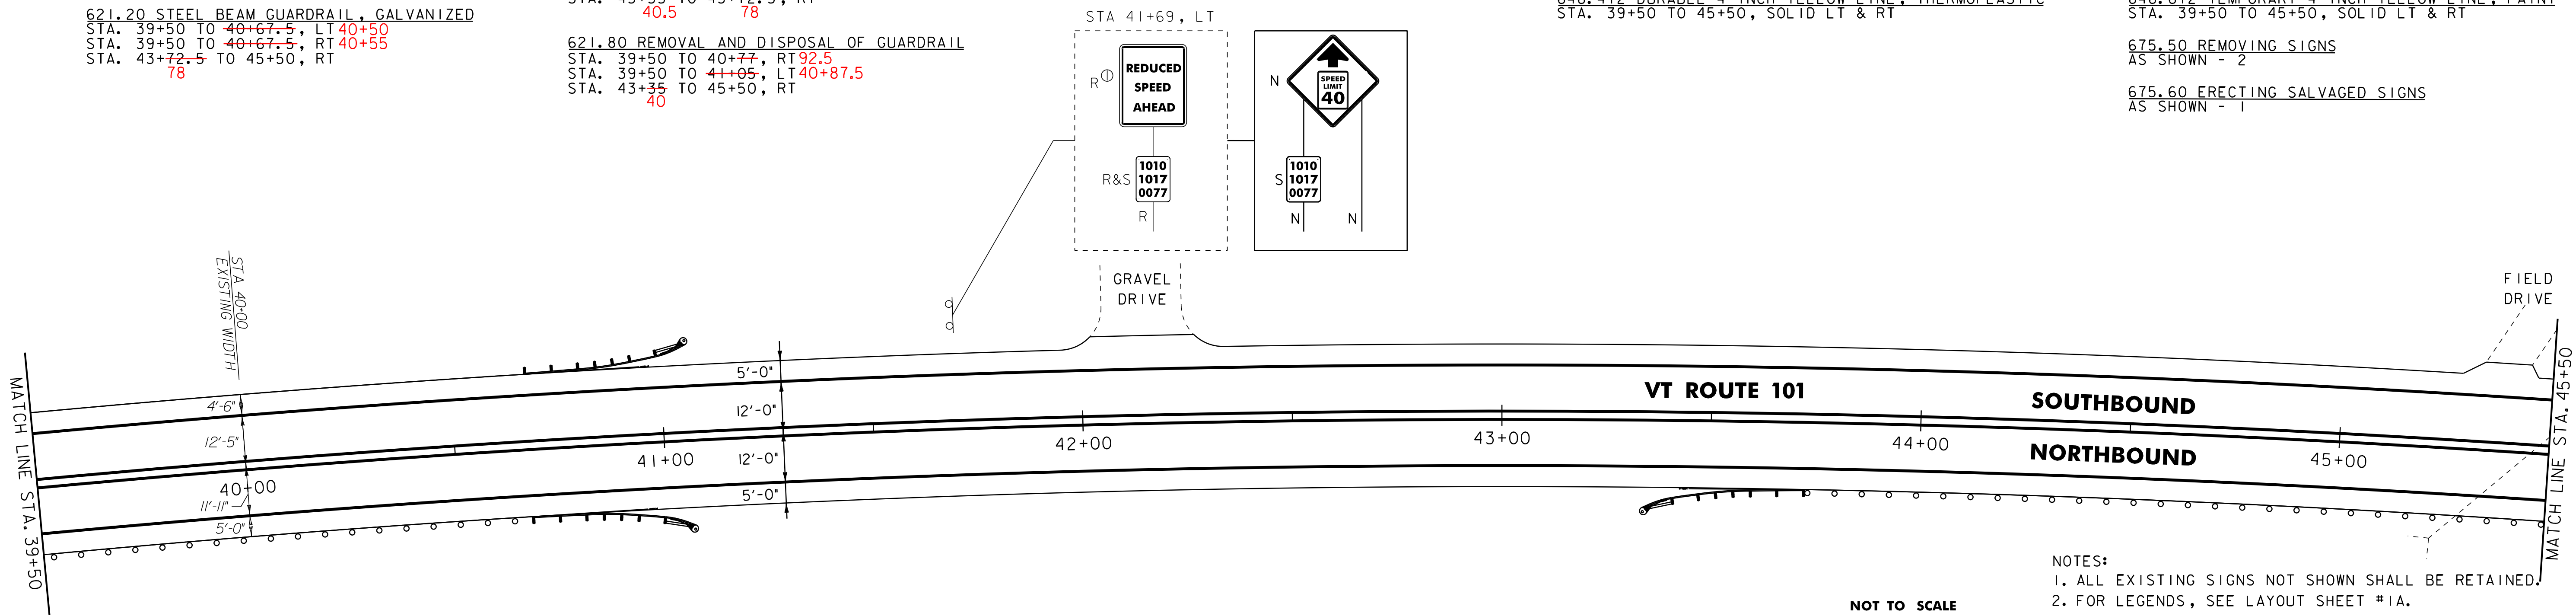

NOTES:
 1. ALL EXISTING SIGNS NOT SHOWN SHALL BE RETAINED.
 2. FOR LEGENDS, SEE LAYOUT SHEET #1A.



NOT TO SCALE

PROJECT LAYOUT SHEET #5

PROJECT NAME: TROY	PLOT DATE: 25-OCT-2011 13:59
PROJECT NUMBER: STP-HES 2718(1)	DRAWN BY: STANTEC
FILE NAME: p07c200.dgn	CHECKED BY: JLL
PROJECT LEADER: JLL	SHEET 21 OF 116
DESIGNED BY: MCF	
IPARM FILE: p07c200i05.i	