

621.20 STEEL BEAM GUARDRAIL, GALVANIZED

STA. 45+50 TO 46+60, RT

46+53

621.50 MANUFACTURED TERMINAL SECTION, FLARED

STA. 46+60 TO 46+97.5, RT

46+52.5 46+90

621.80 REMOVAL AND DISPOSAL OF GUARDRAIL

STA. 45+50 TO 46+90, RT

90

646.402 DURABLE 4 INCH WHITE LINE, THERMOPLASTIC

STA. 45+50 TO 51+50, SOLID LT & RT

646.412 DURABLE 4 INCH YELLOW LINE, THERMOPLASTIC


STA. 45+50 TO 51+50, SOLID LT & RT

646.602 TEMPORARY 4 INCH WHITE LINE, PAINT

STA. 45+50 TO 51+50, SOLID LT & RT

646.612 TEMPORARY 4 INCH YELLOW LINE, PAINT

STA. 45+50 TO 51+50, SOLID LT & RT

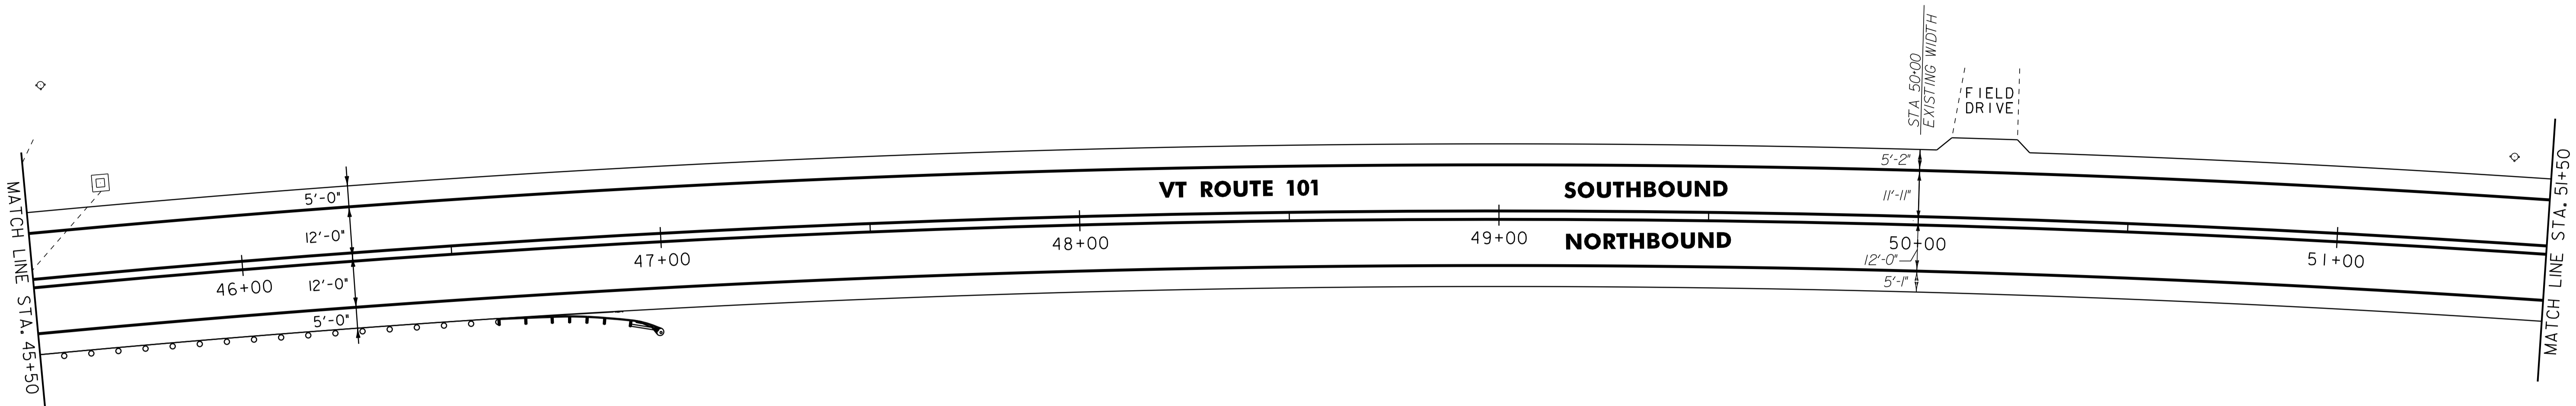

616.35 TREATED TIMBER CURB

STA. 54+73 TO 57+50, RT

75

621.20 STEEL BEAM GUARDRAIL, GALVANIZED

STA. 54+72.5 TO 57+50, RT

65.5

621.50 MANUFACTURED TERMINAL SECTION, FLARED

STA. 54+35 TO 54+72.5, RT

28 65.5

621.80 REMOVAL AND DISPOSAL OF GUARDRAIL

STA. 54+36 TO 57+50, RT

28

646.402 DURABLE 4 INCH WHITE LINE, THERMOPLASTIC

STA. 51+50 TO 57+50, SOLID LT & RT

646.412 DURABLE 4 INCH YELLOW LINE, THERMOPLASTIC

STA. 51+50 TO 52+27, SOLID LT & RT

STA. 52+27 TO 57+50, SOLID LT, DASHED RT


646.602 TEMPORARY 4 INCH WHITE LINE, PAINT

STA. 51+50 TO 57+50, SOLID LT & RT

646.612 TEMPORARY 4 INCH YELLOW LINE, PAINT

STA. 51+50 TO 52+27, SOLID LT & RT

STA. 52+27 TO 57+50, SOLID LT, DASHED RT

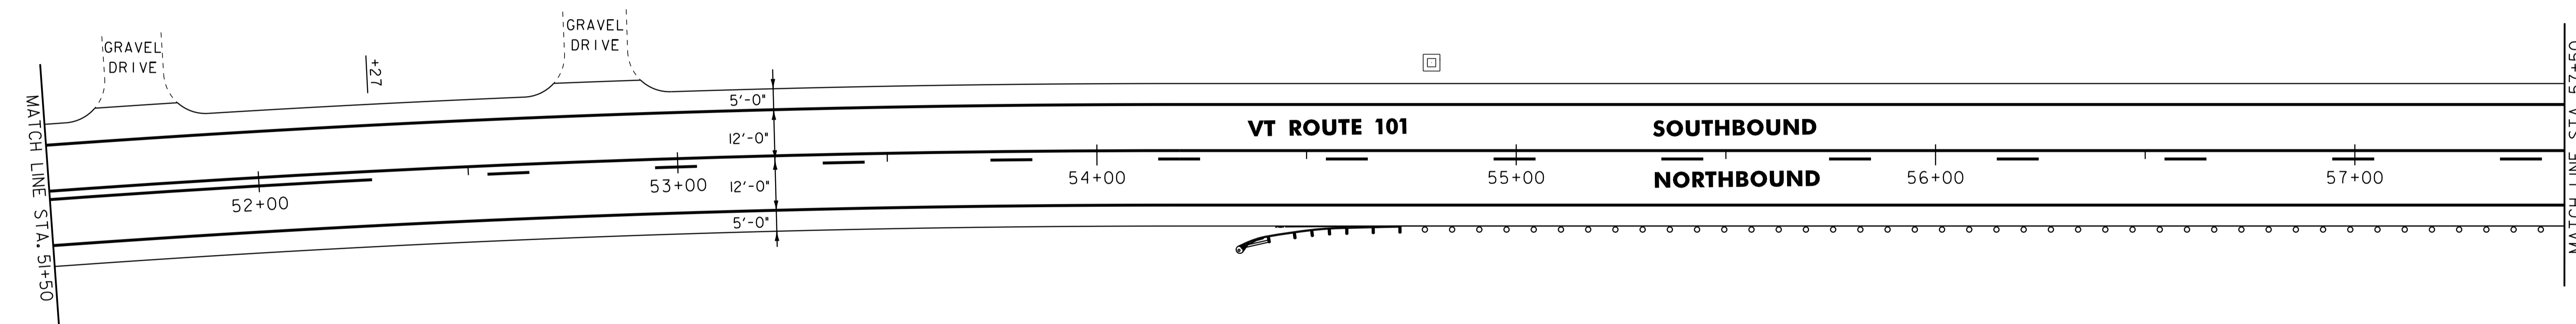

- NOTES:
1. ALL EXISTING SIGNS NOT SHOWN SHALL BE RETAINED.
 2. FOR LEGENDS, SEE LAYOUT SHEET #1A.



NOT TO SCALE

PROJECT LAYOUT SHEET #6

PROJECT NAME: TROY	PLOT DATE: 25-OCT-2011 13:59
PROJECT NUMBER: STP-HES 2718(1)	DRAWN BY: STANTEC
FILE NAME: p07c200.dgn	CHECKED BY: JLL
PROJECT LEADER: JLL	SHEET 22 OF 116
DESIGNED BY: MCF	
IPARM FILE: p07c200i06.i	