

604.412, 604.415, OR 604.418 REHAB.
 D1'S, CB'S OR MH'S, CLASS I, II OR III
 STA. 58+51, RT
 STA. 61+32, RT

621.80 REMOVAL AND DISPOSAL OF GUARDRAIL
 STA. 57+50 TO 63+50, RT

646.402 DURABLE 4 INCH WHITE LINE, THERMOPLASTIC
 STA. 57+50 TO 63+50, SOLID LT & RT

646.602 TEMPORARY 4 INCH WHITE LINE, PAINT
 STA. 57+50 TO 63+50, SOLID LT & RT

616.35 TREATED TIMBER CURB
 STA. 57+50 TO 63+50, RT

646.412 DURABLE 4 INCH YELLOW LINE, THERMOPLASTIC
 STA. 57+50 TO 60+19, SOLID LT, DASHED RT
 STA. 60+19 TO 63+50, DASHED C

646.612 TEMPORARY 4 INCH YELLOW LINE, PAINT
 STA. 57+50 TO 60+19, SOLID LT, DASHED RT
 STA. 60+19 TO 63+50, DASHED C

621.20 STEEL BEAM GUARDRAIL, GALVANIZED
 STA. 57+50 TO 63+50, RT



604.412, 604.415, OR 604.418 REHAB.
 D1'S, CB'S OR MH'S, CLASS I, II OR III
 STA. 63+84, RT

621.50 MANUFACTURED TERMINAL SECTION, FLARED
 STA. 64+22.5 TO 64+60, RT

646.402 DURABLE 4 INCH WHITE LINE, THERMOPLASTIC
 STA. 63+50 TO 69+50, SOLID LT & RT

646.602 TEMPORARY 4 INCH WHITE LINE, PAINT
 STA. 63+50 TO 69+50, SOLID LT & RT


616.35 TREATED TIMBER CURB
 STA. 63+50 TO 64+23, RT
 63+87.5

621.80 REMOVAL AND DISPOSAL OF GUARDRAIL
 STA. 63+50 TO 64+57, RT
 40.5

646.412 DURABLE 4 INCH YELLOW LINE, THERMOPLASTIC
 STA. 63+50 TO 64+15, DASHED C
 STA. 64+15 TO 69+50, DASHED LT, SOLID RT

646.612 TEMPORARY 4 INCH YELLOW LINE, PAINT
 STA. 63+50 TO 64+15, DASHED C
 STA. 64+15 TO 69+50, DASHED LT, SOLID RT

621.20 STEEL BEAM GUARDRAIL, GALVANIZED
 STA. 63+50 TO 64+22.5, RT
 03

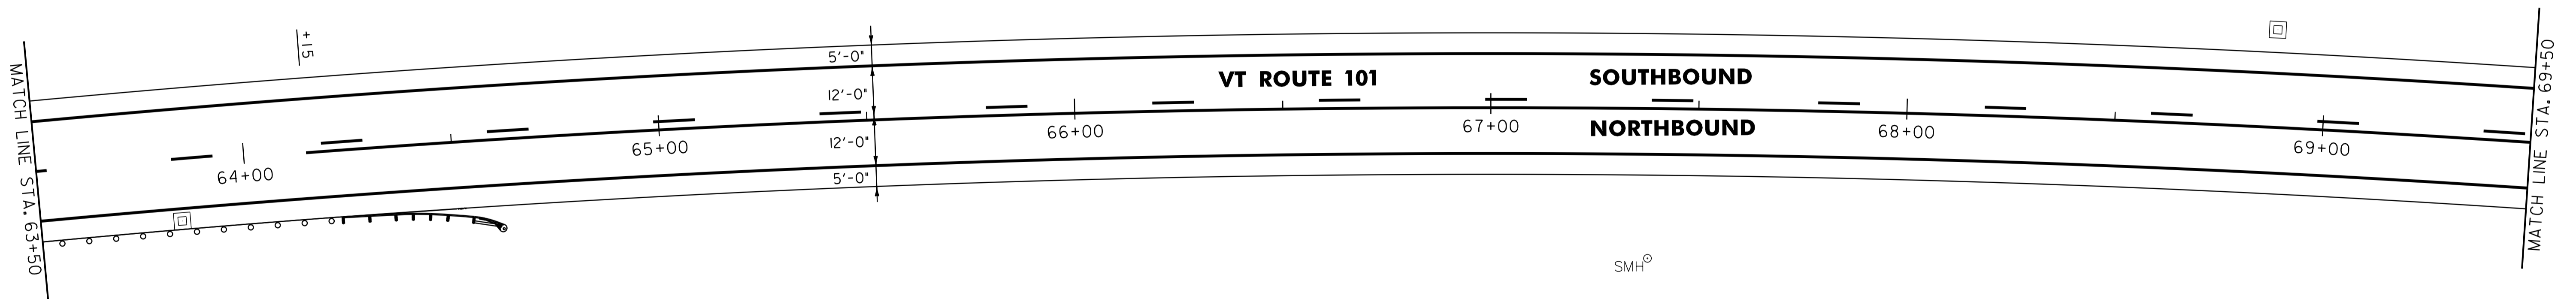

NOTES:
 1. ALL EXISTING SIGNS NOT SHOWN SHALL BE RETAINED.
 2. FOR LEGENDS, SEE LAYOUT SHEET #1A.



NOT TO SCALE

**PROJECT
 LAYOUT
 SHEET #7**

PROJECT NAME: TROY	PLOT DATE: 25-OCT-2011 14:00
PROJECT NUMBER: STP-HES 2718(1)	DRAWN BY: STANTEC
FILE NAME: p07c200.dgn	CHECKED BY: JLL
PROJECT LEADER: JLL	SHEET 23 OF 116
DESIGNED BY: MCF	
IPARM FILE: p07c200i07.i	