


621.20 STEEL BEAM GUARDRAIL, GALVANIZED
 STA. 71+97.5 TO 75+50, RT
 96.5
 621.50 MANUFACTURED TERMINAL SECTION, FLARED
 STA. 71+60 TO 71+97.5
 59 96.5

621.80 REMOVAL AND DISPOSAL OF GUARDRAIL
 STA. 71+59 TO 75+50, RT

646.402 DURABLE 4 INCH WHITE LINE, THERMOPLASTIC
 STA. 69+50 TO 75+50, SOLID LT & RT
 646.412 DURABLE 4 INCH YELLOW LINE, THERMOPLASTIC
 STA. 69+50 TO 72+34, DASHED LT, SOLID RT
 STA. 72+33 TO 74+98, SOLID LT & RT
 STA. 74+98 TO 75+50, SOLID LT, DASHED RT

646.602 TEMPORARY 4 INCH WHITE LINE, PAINT
 STA. 69+50 TO 75+50, SOLID LT & RT
 646.612 TEMPORARY 4 INCH YELLOW LINE, PAINT
 STA. 69+50 TO 72+34, DASHED LT, SOLID RT
 STA. 72+33 TO 74+98, SOLID LT & RT
 STA. 74+98 TO 75+50, SOLID LT, DASHED RT

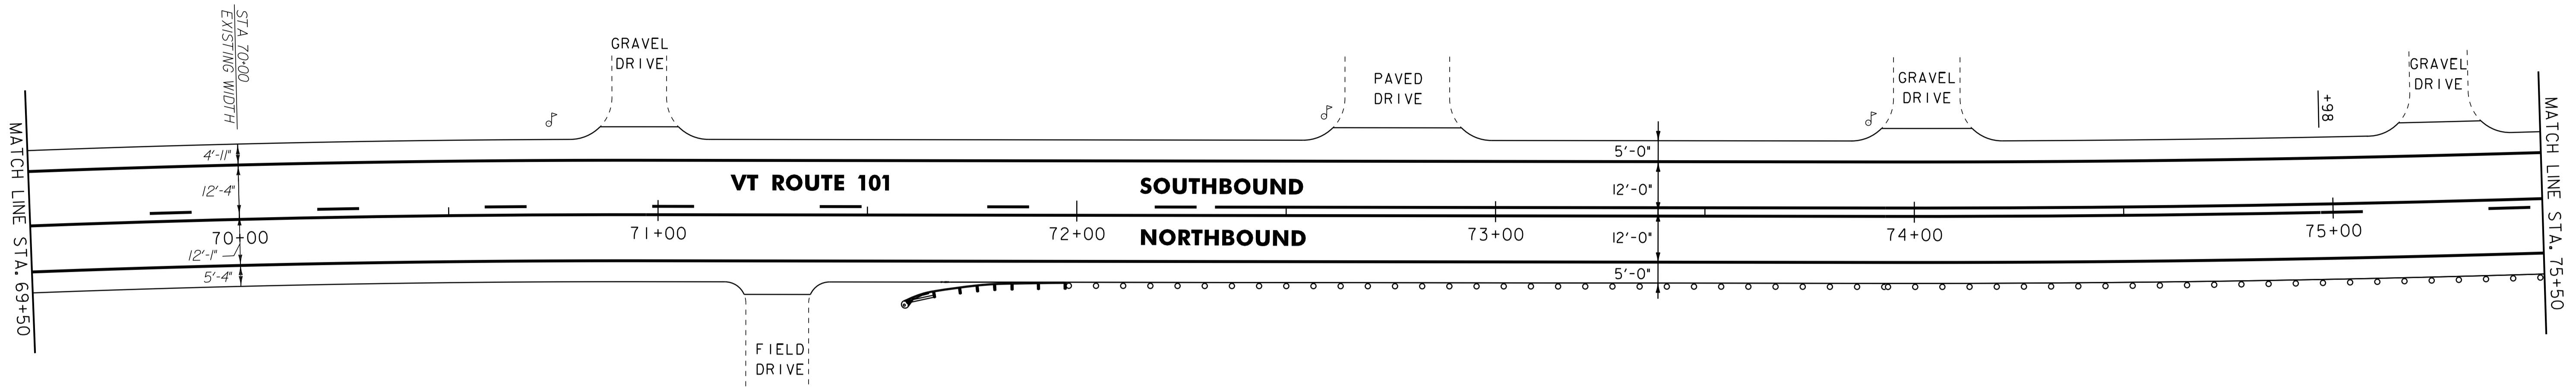


621.20 STEEL BEAM GUARDRAIL, GALVANIZED
 STA. 75+50 TO 76+97.5, RT
 84
 621.50 MANUFACTURED TERMINAL SECTION, FLARED
 STA. 76+97.5 TO 77+35, RT
 84 21

621.80 REMOVAL AND DISPOSAL OF GUARDRAIL
 STA. 75+50 TO 77+29, RT
 12.5

646.402 DURABLE 4 INCH WHITE LINE, THERMOPLASTIC
 STA. 75+50 TO 81+50, SOLID LT & RT
 646.412 DURABLE 4 INCH YELLOW LINE, THERMOPLASTIC
 STA. 75+50 TO 81+50, SOLID LT, DASHED RT

646.602 TEMPORARY 4 INCH WHITE LINE, PAINT
 STA. 75+50 TO 81+50, SOLID LT & RT
 646.612 TEMPORARY 4 INCH YELLOW LINE, PAINT
 STA. 75+50 TO 81+50, SOLID LT, DASHED RT

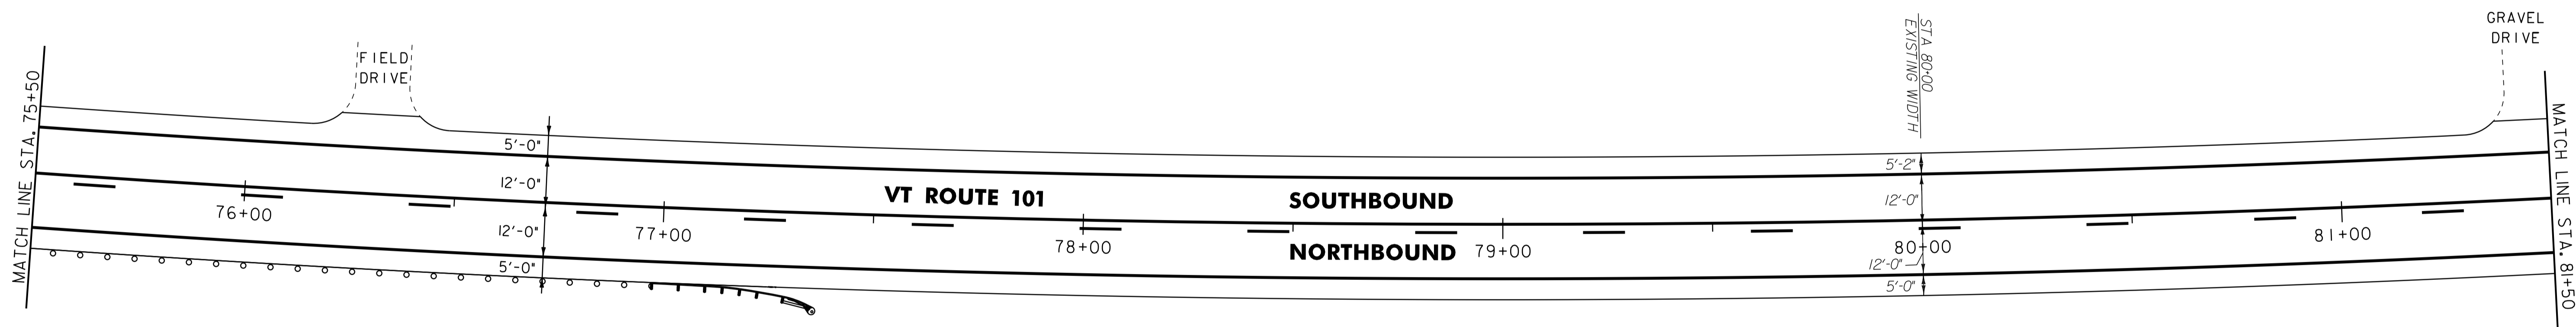

- NOTES:
 1. ALL EXISTING SIGNS NOT SHOWN SHALL BE RETAINED.
 2. FOR LEGENDS, SEE LAYOUT SHEET #1A.



NOT TO SCALE

PROJECT LAYOUT SHEET #8

PROJECT NAME: TROY	FILE NAME: p07c200.dgn	PLOT DATE: 25-OCT-2011 4:00
PROJECT NUMBER: STP-HES 2718(1)	PROJECT LEADER: JLL	DRAWN BY: STANTEC
	DESIGNED BY: MCF	CHECKED BY: JLL
	IPARM FILE: p07c200i08.i	SHEET 24 OF 116