


646.402 DURABLE 4 INCH WHITE LINE, THERMOPLASTIC
STA. 93+50 TO 99+50, SOLID LT & RT

646.602 TEMPORARY 4 INCH WHITE LINE, PAINT
STA. 93+50 TO 99+50, SOLID LT & RT

646.412 DURABLE 4 INCH YELLOW LINE, THERMOPLASTIC
STA. 93+50 TO 96+36, DASHED LT, SOLID RT
STA. 96+36 TO 99+50, SOLID LT & RT

646.612 TEMPORARY 4 INCH YELLOW LINE, PAINT
STA. 93+50 TO 96+36, DASHED LT, SOLID RT
STA. 96+36 TO 99+50, SOLID LT & RT

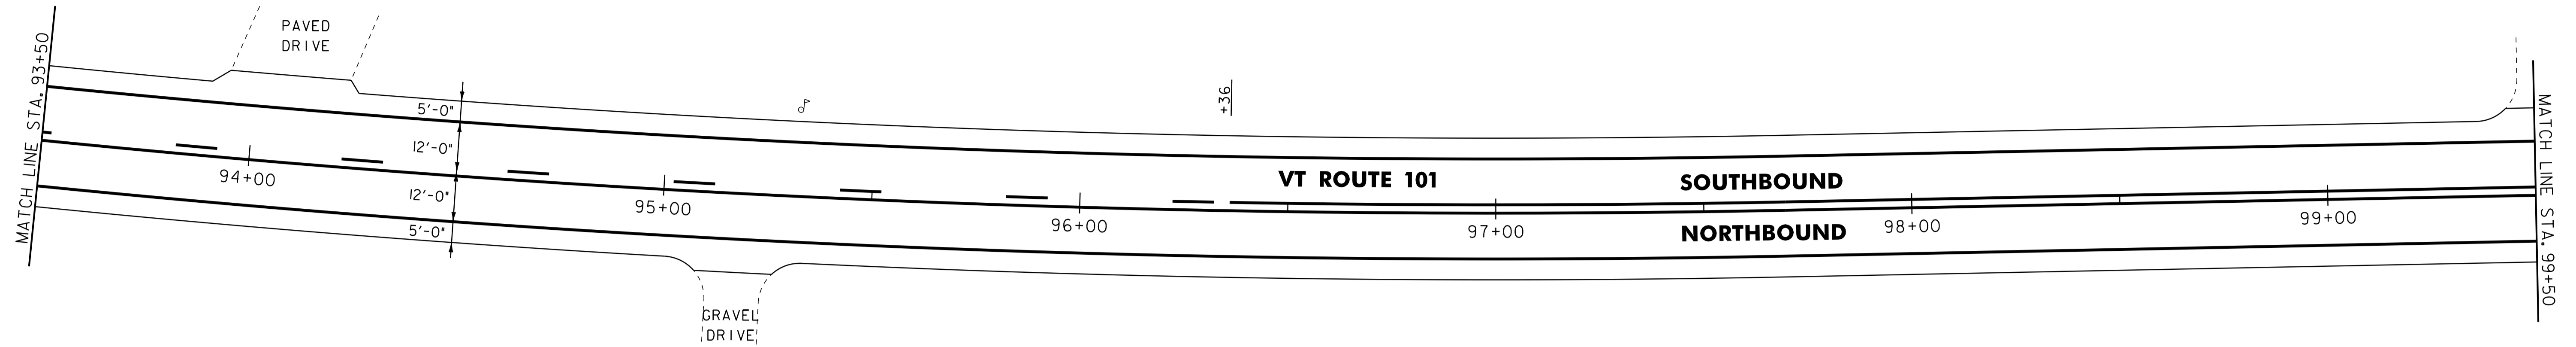


646.402 DURABLE 4 INCH WHITE LINE, THERMOPLASTIC
STA. 99+50 TO 105+50, SOLID LT & RT

646.602 TEMPORARY 4 INCH WHITE LINE, PAINT
STA. 99+50 TO 105+50, SOLID LT & RT

646.412 DURABLE 4 INCH YELLOW LINE, THERMOPLASTIC
STA. 99+50 TO 105+50, SOLID LT & RT

646.612 TEMPORARY 4 INCH YELLOW LINE, PAINT
STA. 99+50 TO 105+50, SOLID LT & RT

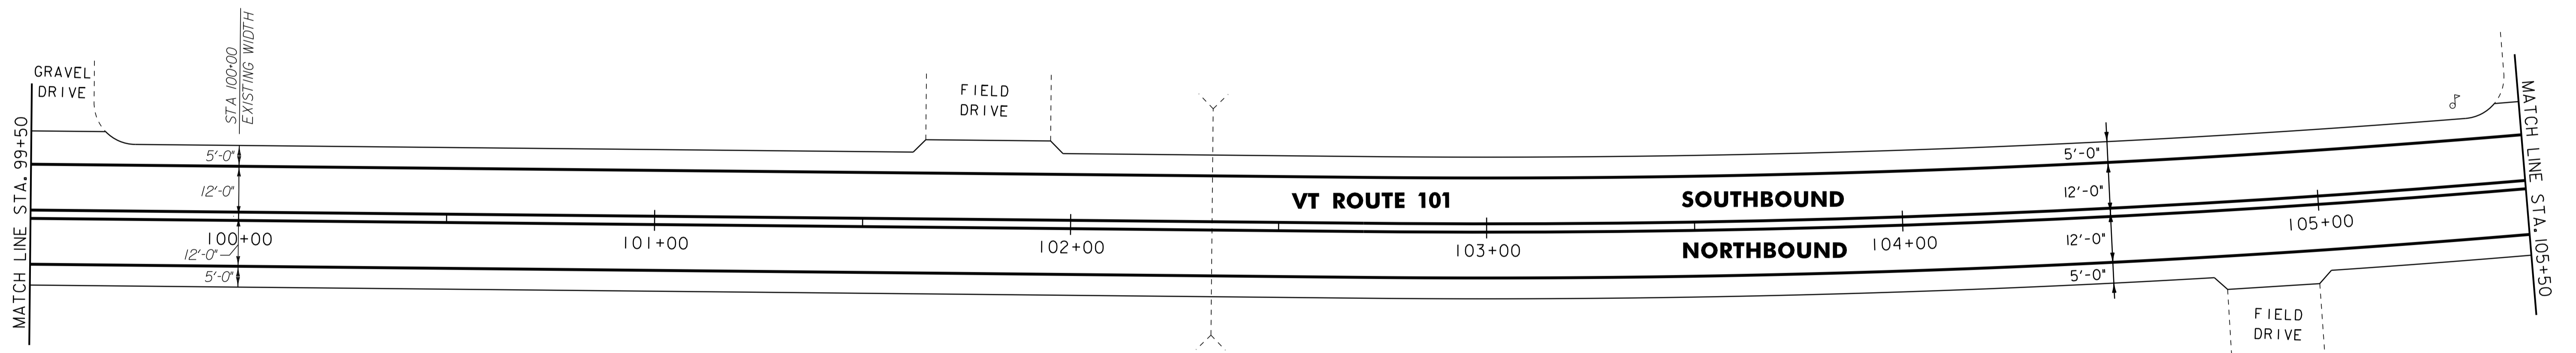

- NOTES:
1. ALL EXISTING SIGNS NOT SHOWN SHALL BE RETAINED.
 2. FOR LEGENDS, SEE LAYOUT SHEET #1A.



NOT TO SCALE

**PROJECT
LAYOUT
SHEET #10**

PROJECT NAME: TROY
PROJECT NUMBER: STP-HES 2718(1)

FILE NAME: p07c200.dgn
PROJECT LEADER: JLL
DESIGNED BY: MCF
IPARM FILE: p07c200i10.i

PLOT DATE: 25-OCT-2011 4:00
DRAWN BY: STANTEC
CHECKED BY: JLL
SHEET 26 OF 116