


646.402 DURABLE 4 INCH WHITE LINE, THERMOPLASTIC  
 STA. 117+50 TO 123+50, SOLID LT & RT

646.602 TEMPORARY 4 INCH WHITE LINE, PAINT  
 STA. 117+50 TO 123+50, SOLID LT & RT

646.412 DURABLE 4 INCH YELLOW LINE, THERMOPLASTIC  
 STA. 117+50 TO 119+59, SOLID LT & RT  
 STA. 119+59 TO 123+50, SOLID LT, DASHED RT

646.612 TEMPORARY 4 INCH YELLOW LINE, PAINT  
 STA. 117+50 TO 119+59, SOLID LT & RT  
 STA. 119+59 TO 123+50, SOLID LT, DASHED RT

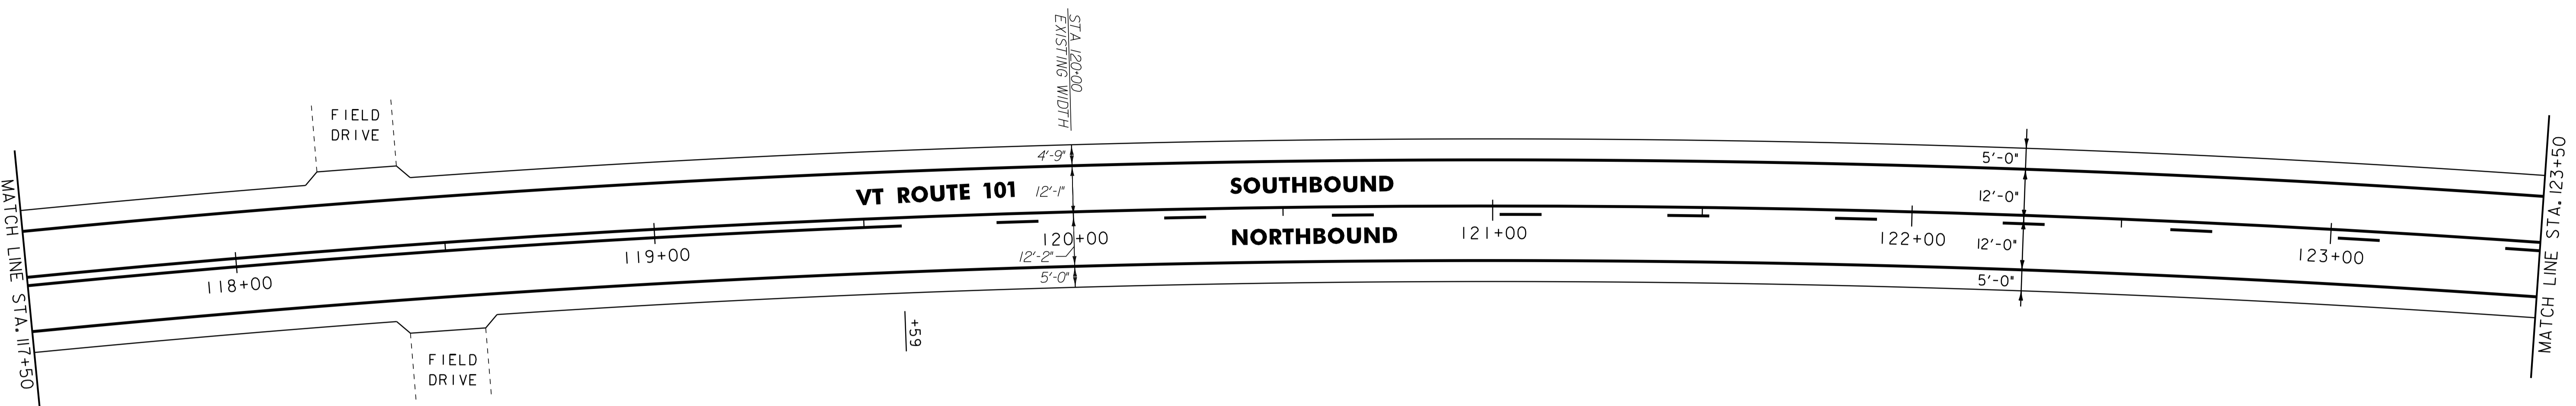

621.20 STEEL BEAM GUARDRAIL, GALVANIZED  
 STA. ~~127+35.5~~ TO 129+50, LT  
 STA. ~~128+62.5~~ TO 129+50, RT  
 25.5

621.80 REMOVAL AND DISPOSAL OF GUARDRAIL  
 STA. 127+78 TO 129+50, LT  
 STA. 128+27 TO 129+50, RT

646.402 DURABLE 4 INCH WHITE LINE, THERMOPLASTIC  
 STA. 123+50 TO 129+50, SOLID LT & RT


646.602 TEMPORARY 4 INCH WHITE LINE, PAINT  
 STA. 123+50 TO 129+50, SOLID LT & RT

621.50 MANUFACTURED TERMINAL SECTION, FLARED  
 STA. ~~126+98~~ TO ~~127+35.5~~, LT  
 STA. ~~126+85.5~~ TO 127+23  
 STA. ~~128+25~~ TO ~~128+62.5~~, RT

646.412 DURABLE 4 INCH YELLOW LINE, THERMOPLASTIC  
 STA. 123+50 TO 126+72, SOLID LT, DASHED RT  
 STA. 126+72 TO 129+10, DASHED LT  
 STA. 129+10 TO 129+50, DASHED LT, SOLID RT

646.612 TEMPORARY 4 INCH YELLOW LINE, PAINT  
 STA. 123+50 TO 126+72, SOLID LT, DASHED RT  
 STA. 126+72 TO 129+10, DASHED LT  
 STA. 129+10 TO 129+50, DASHED LT, SOLID RT

621.60 ANCHOR FOR STEEL BEAM RAIL  
 STA. 128+40 RT  
 STA. 128+52.5 RT

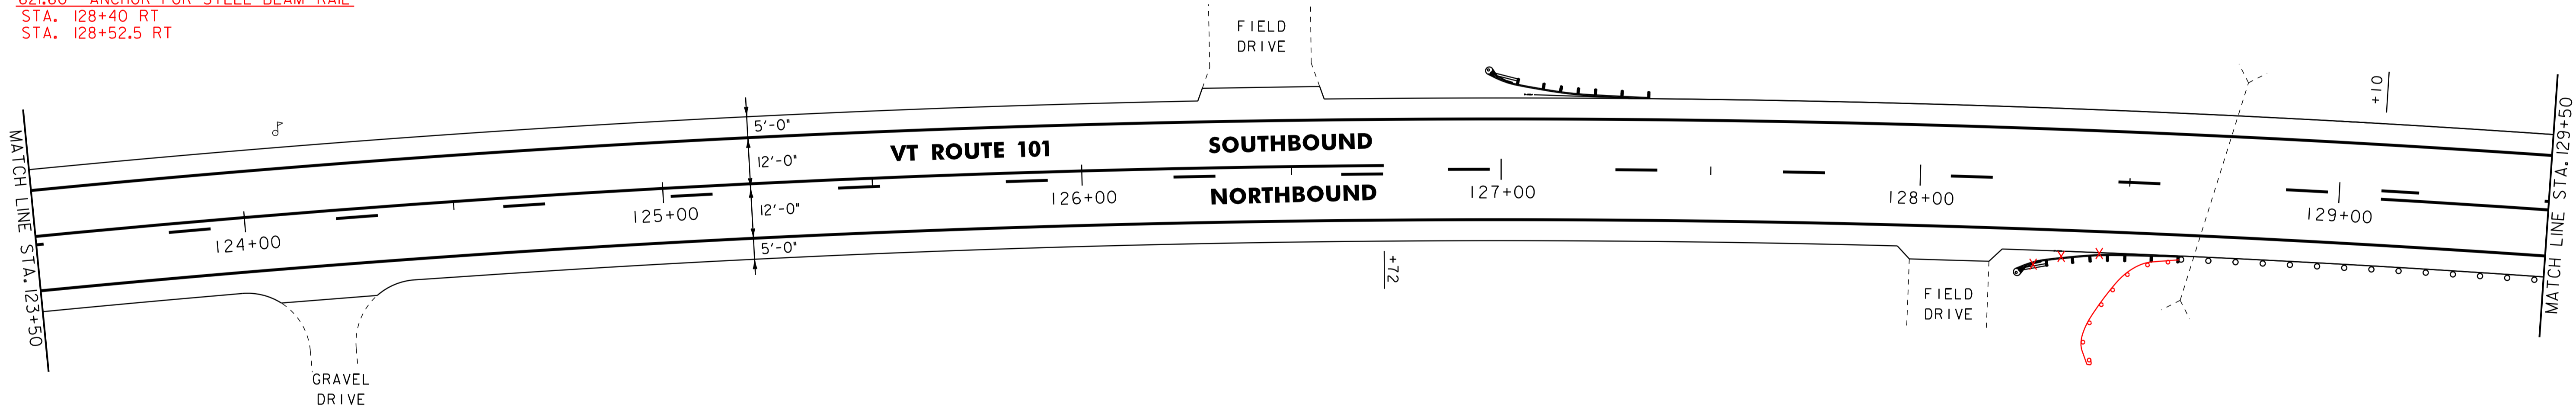

NOTES:  
 1. ALL EXISTING SIGNS NOT SHOWN SHALL BE RETAINED.  
 2. FOR LEGENDS, SEE LAYOUT SHEET #1A.



<b>NOT TO SCALE</b>	
<b>PROJECT LAYOUT SHEET #12</b>	
PROJECT NAME: TROY	PLOT DATE: 25-OCT-2011 14:00
PROJECT NUMBER: STP-HES 2718(1)	DRAWN BY: STANTEC
FILE NAME: p07c200.dgn	CHECKED BY: JLL
PROJECT LEADER: JLL	SHEET 28 OF 116
DESIGNED BY: MCF	
IPARM FILE: p07c200i12.i	