

621.20 STEEL BEAM GUARDRAIL, GALVANIZED

STA. 129+50 TO 130+00, RT 130+02.5
STA. 129+50 TO 131+23, LT
130+73

621.80 REMOVAL AND DISPOSAL OF GUARDRAIL

STA. 129+50 TO 130+07, LT
05
STA. 129+50 TO 130+40 RT

646.402 DURABLE 4 INCH WHITE LINE, THERMOPLASTIC

STA. 129+50 TO 135+50, SOLID LT & RT

646.602 TEMPORARY 4 INCH WHITE LINE, PAINT

STA. 129+50 TO 135+50, SOLID LT & RT

621.50 MANUFACTURED TERMINAL SECTION, FLARED


STA. 130+00 TO 130+37.5, RT 130+02.5 TO 130+40 RT
STA. 131+23 TO 131+60.5, LT
130+73 131+10.5

646.412 DURABLE 4 INCH YELLOW LINE, THERMOPLASTIC

STA. 129+50 TO 135+50, DASHED LT, SOLID RT

646.612 TEMPORARY 4 INCH YELLOW LINE, PAINT

STA. 129+50 TO 135+50, DASHED LT, SOLID RT

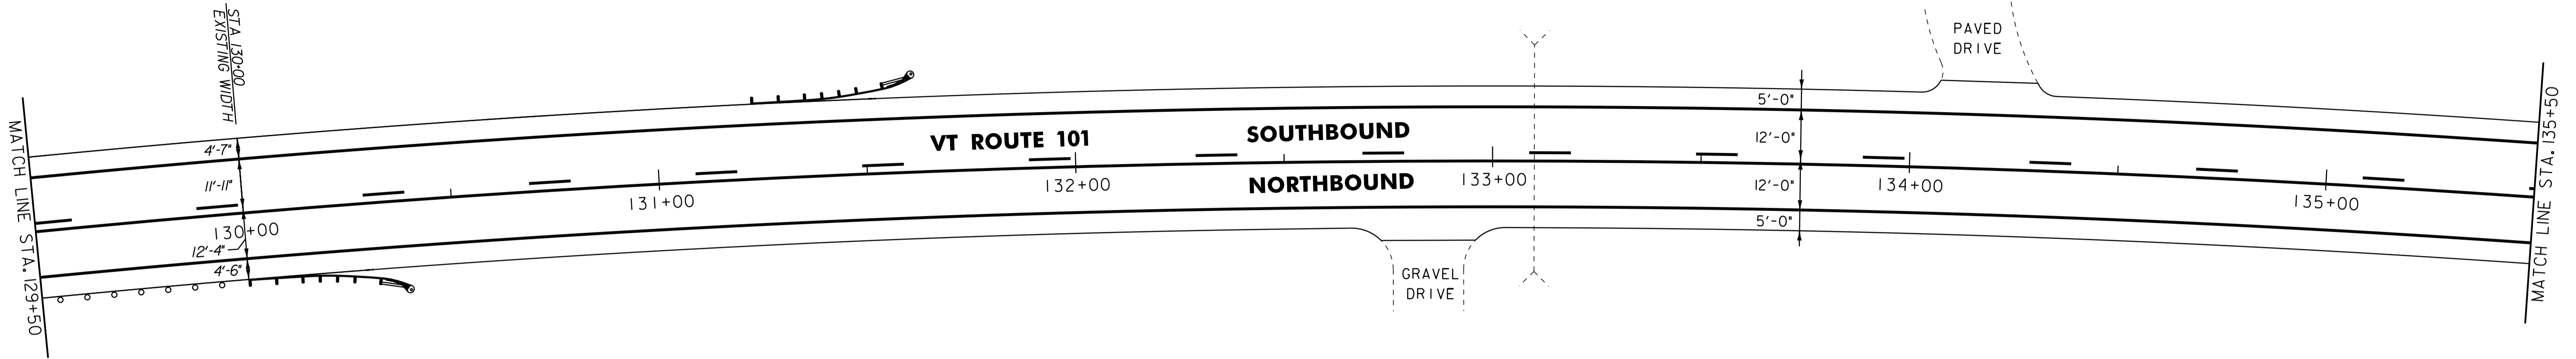

646.402 DURABLE 4 INCH WHITE LINE, THERMOPLASTIC

STA. 135+50 TO 141+50, SOLID LT & RT

646.602 TEMPORARY 4 INCH WHITE LINE, PAINT


STA. 135+50 TO 141+50, SOLID LT & RT

646.412 DURABLE 4 INCH YELLOW LINE, THERMOPLASTIC

STA. 135+50 TO 136+22, DASHED LT, SOLID RT
STA. 136+22 TO 141+50, SOLID LT & RT

646.612 TEMPORARY 4 INCH YELLOW LINE, PAINT

STA. 135+50 TO 136+22, DASHED LT, SOLID RT
STA. 136+22 TO 141+50, SOLID LT & RT

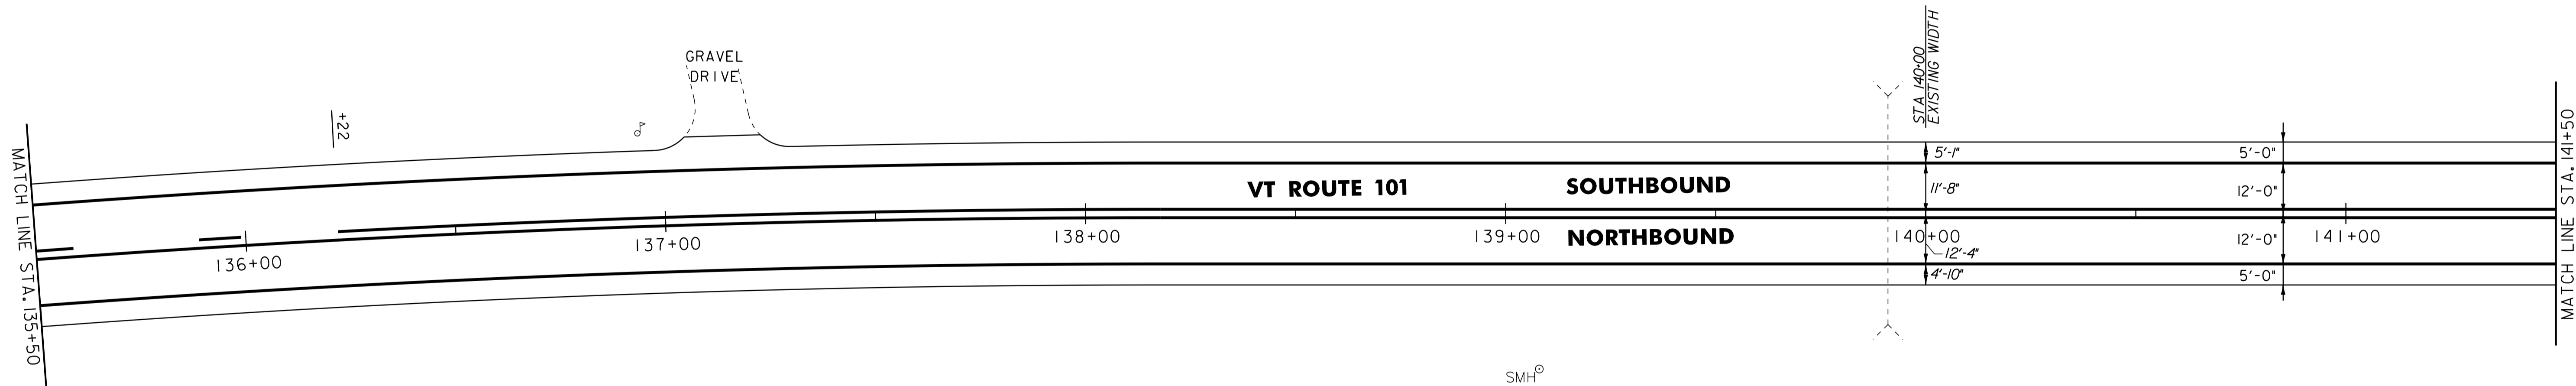

- NOTES:
1. ALL EXISTING SIGNS NOT SHOWN SHALL BE RETAINED.
 2. FOR LEGENDS, SEE LAYOUT SHEET #1A.

NOT TO SCALE



**PROJECT
LAYOUT
SHEET #13**

PROJECT NAME: TROY	PLOT DATE: 25-OCT-2011 14:00
PROJECT NUMBER: STP-HES 2718(1)	DRAWN BY: STANTEC
FILE NAME: p07c200.dgn	CHECKED BY: JLL
PROJECT LEADER: JLL	SHEET 29 OF 116
DESIGNED BY: MCF	
IPARM FILE: p07c200i13.i	