


646.402 DURABLE 4 INCH WHITE LINE, THERMOPLASTIC  
 STA. 153+50 TO 159+50, SOLID LT & RT

646.412 DURABLE 4 INCH YELLOW LINE, THERMOPLASTIC  
 STA. 153+50 TO 159+50, SOLID LT & RT

646.602 TEMPORARY 4 INCH WHITE LINE, PAINT  
 STA. 153+50 TO 159+50, SOLID LT & RT


646.612 TEMPORARY 4 INCH YELLOW LINE, PAINT  
 STA. 153+50 TO 159+50, SOLID LT & RT

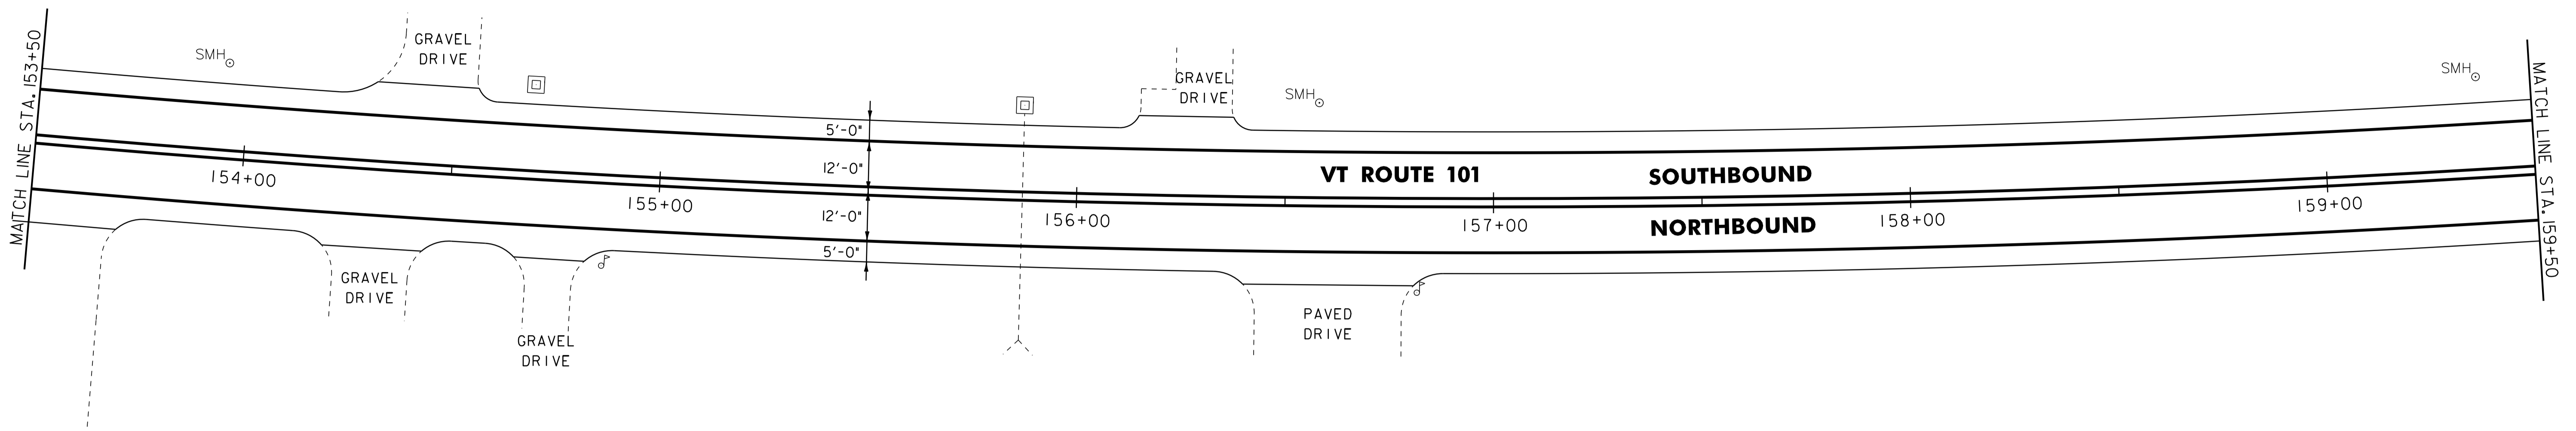

621.20 STEEL BEAM GUARDRAIL, GALVANIZED  
 STA. 163+55 TO 164+50, RT  
 48.5

621.50 MANUFACTURED TERMINAL SECTION, FLARED  
 STA. 163+17.5 TO 163+55, RT  
 11 48.5

621.80 REMOVAL AND DISPOSAL OF GUARDRAIL  
 STA. 163+28 TO 164+50, RT  
 11

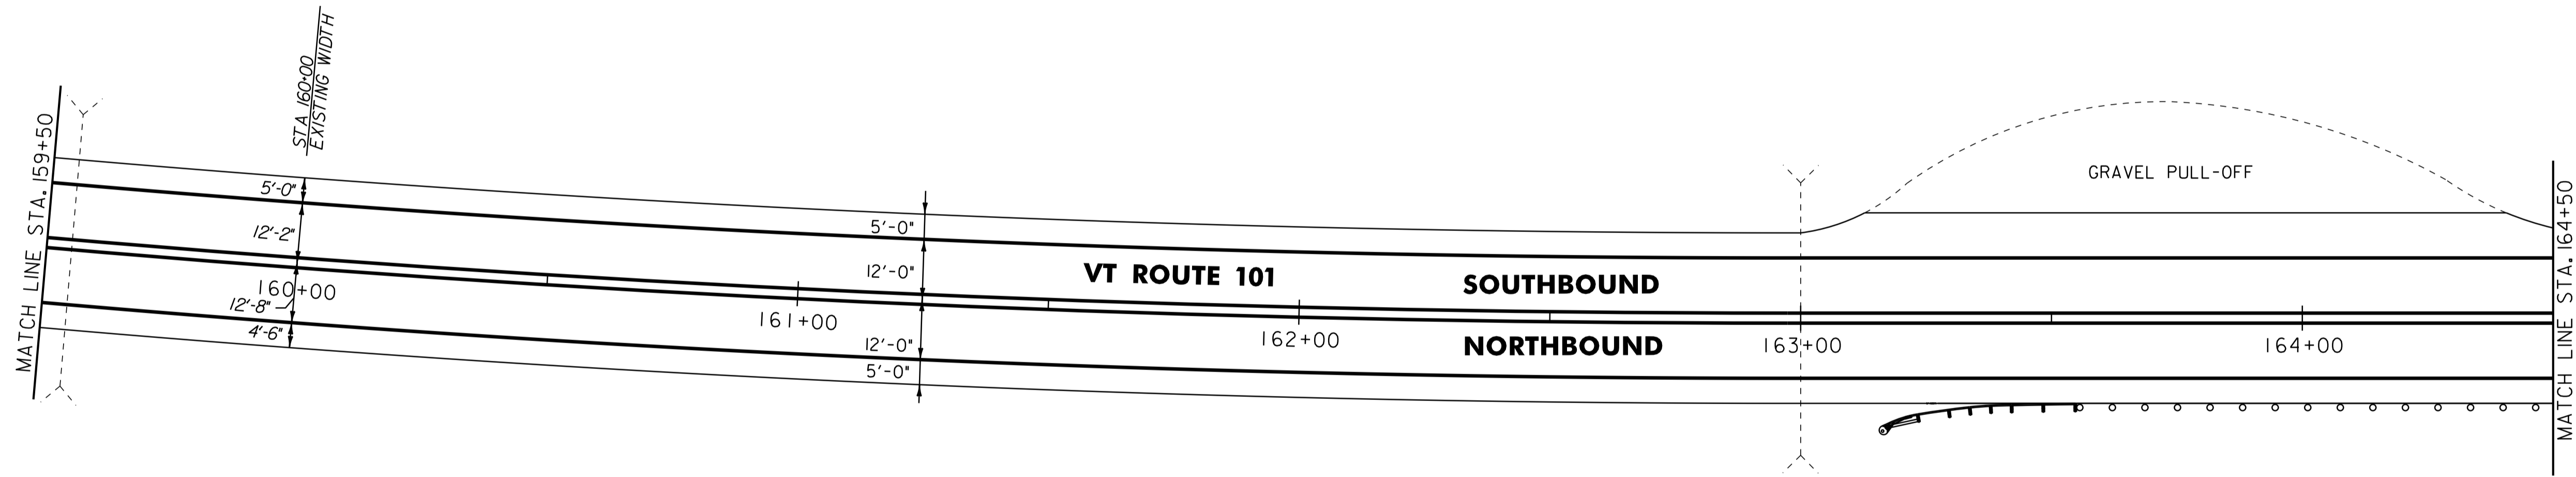

NOTES:  
 1. ALL EXISTING SIGNS NOT SHOWN SHALL BE RETAINED.  
 2. FOR LEGENDS, SEE LAYOUT SHEET #1A.

646.402 DURABLE 4 INCH WHITE LINE, THERMOPLASTIC  
 STA. 159+50 TO 164+50, SOLID LT & RT

646.412 DURABLE 4 INCH YELLOW LINE, THERMOPLASTIC  
 STA. 159+50 TO 164+50, SOLID LT & RT

646.602 TEMPORARY 4 INCH WHITE LINE, PAINT  
 STA. 159+50 TO 164+50, SOLID LT & RT

646.612 TEMPORARY 4 INCH YELLOW LINE, PAINT  
 STA. 159+50 TO 164+50, SOLID LT & RT



NOT TO SCALE

**PROJECT  
 LAYOUT  
 SHEET #15**

PROJECT NAME: TROY	PLOT DATE: 25-OCT-2011 14:00
PROJECT NUMBER: STP-HES 2718(1)	DRAWN BY: STANTEC
FILE NAME: p07c200.dgn	CHECKED BY: JLL
PROJECT LEADER: JLL	SHEET 31 OF 116
DESIGNED BY: MCF	
IPARM FILE: p07c200i15.i	