

621.20 STEEL BEAM GUARDRAIL, GALVANIZED
 STA. 164+50 TO +69+17.5, RT
 168+98.5

621.80 REMOVAL AND DISPOSAL OF GUARDRAIL
 STA. 164+50 TO 169+57, RT
 36

646.402 DURABLE 4 INCH WHITE LINE, THERMOPLASTIC
 STA. 164+50 TO 170+50, SOLID LT & RT
 (ALL LINES WILL INCLUDE EDGE LINE RADIUS FOR
 SIDE ROADS)

646.482 DURABLE 24 INCH STOP BAR, THERMOPLASTIC
 STA. 165+88, LT (VT ROUTE 242)

646.602 TEMPORARY 4 INCH WHITE LINE, PAINT
 STA. 164+50 TO 170+50, SOLID LT & RT
 (ALL LINES WILL INCLUDE EDGE LINE RADIUS FOR
 SIDE ROADS)

621.50 MANUFACTURED TERMINAL SECTION, FLARED
 STA. +69+17.5 TO +69+55, RT
 168+98.5 169+36


646.412 DURABLE 4 INCH YELLOW LINE, THERMOPLASTIC
 STA. 164+50 TO 170+50, SOLID LT & RT
 (ALL LINES WILL INCLUDE @ BREAKS FOR SIDE ROADS)
 STA. 165+88, DOUBLE SOLID LT (VT ROUTE 242)

646.492 DURABLE LETTER OR SYMBOL, THERMOPLASTIC
 STA. 165+88, LT - "STOP"

646.612 TEMPORARY 4 INCH YELLOW LINE, PAINT
 STA. 164+50 TO 170+50, SOLID LT & RT
 (ALL LINES WILL INCLUDE @ BREAKS FOR SIDE ROADS)
 STA. 165+88, DOUBLE SOLID LT (VT ROUTE 242)

646.682 TEMPORARY 24 INCH STOP BAR, PAINT
 STA. 165+88, LT (VT ROUTE 242)

646.692 TEMPORARY LETTER OR SYMBOL, PAINT
 STA. 165+88, LT - "STOP"

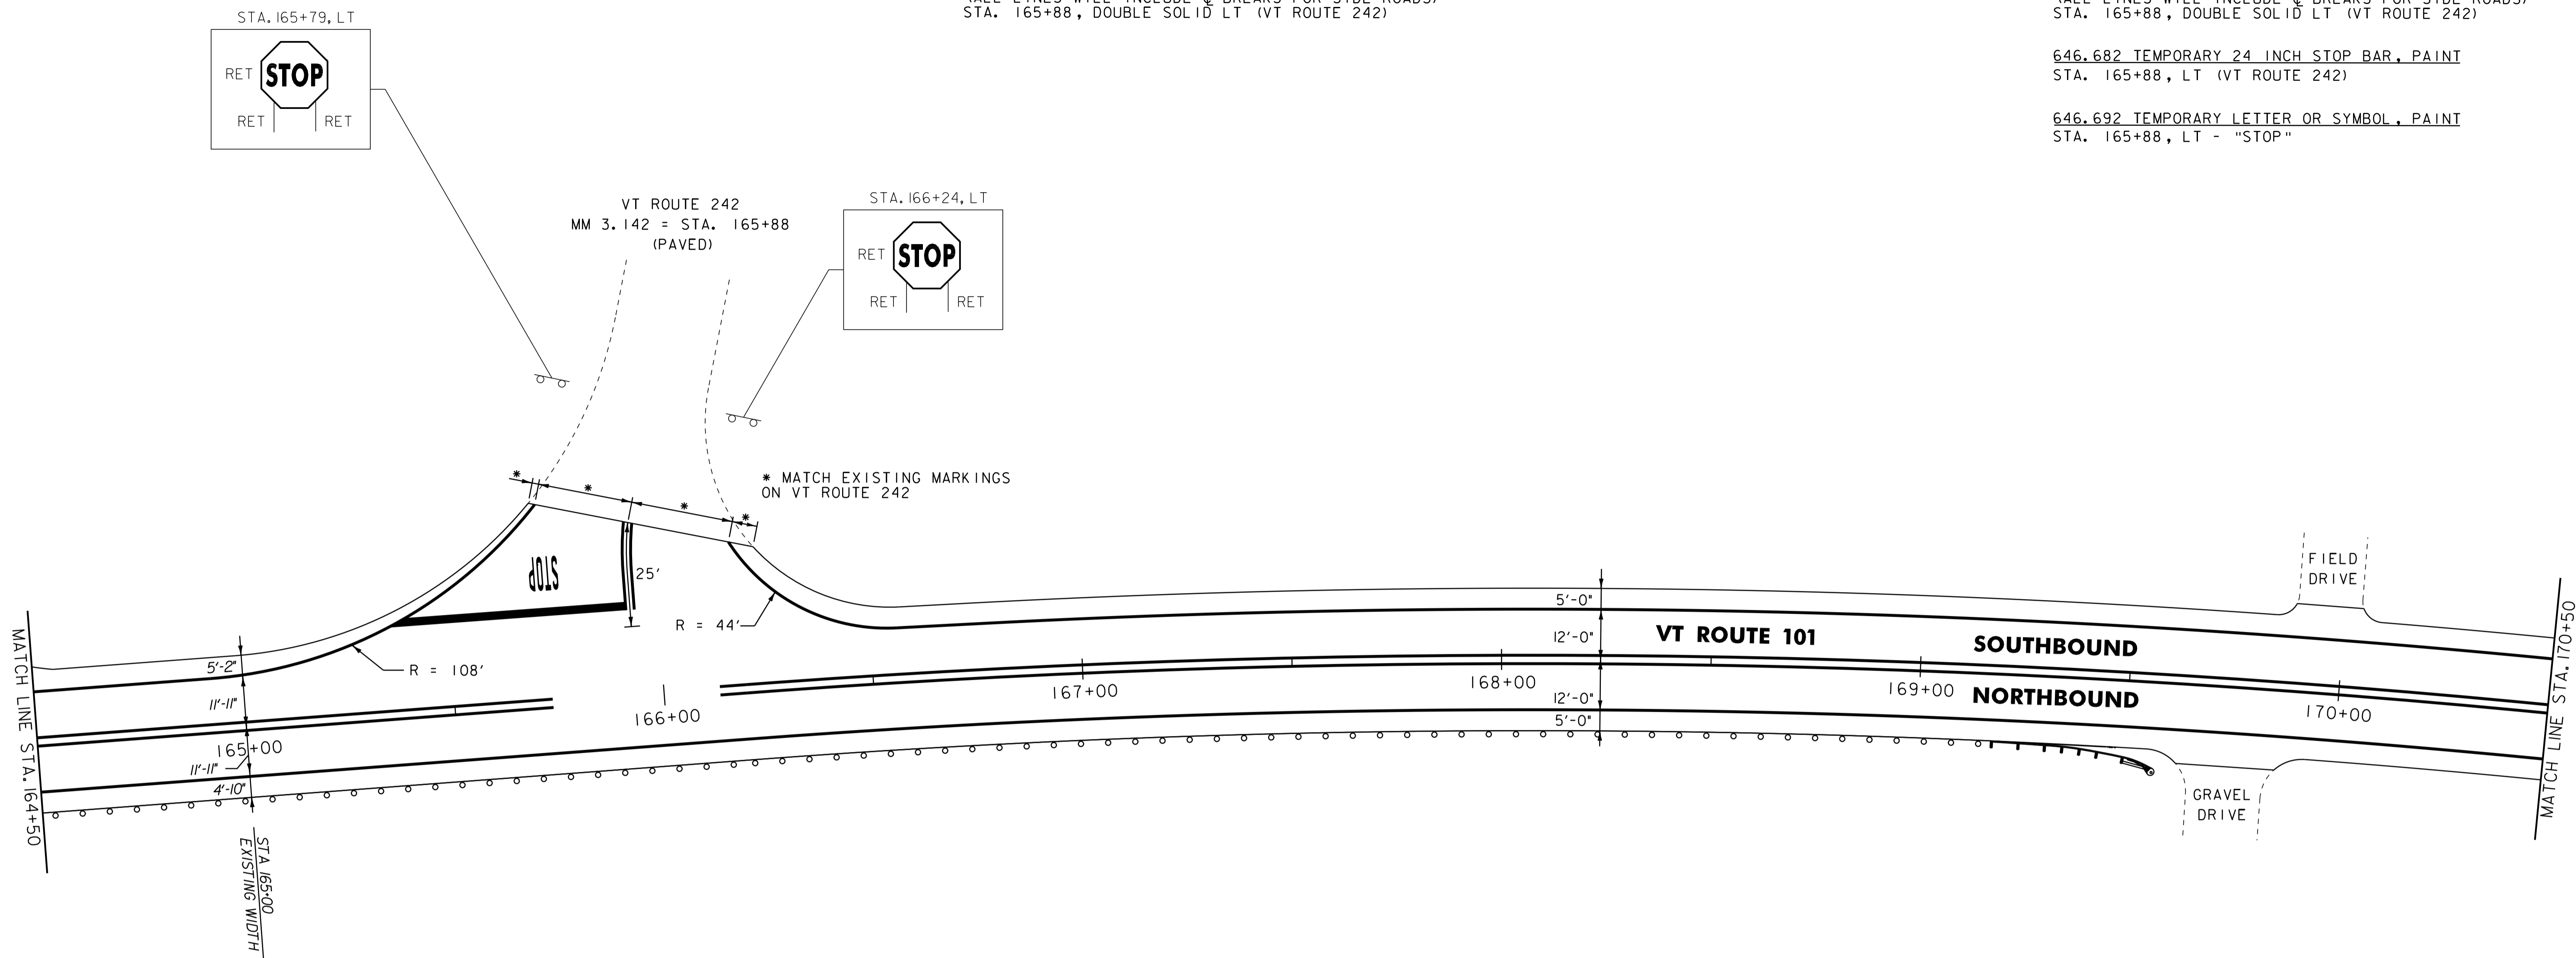

NOTES:
 1. ALL EXISTING SIGNS NOT SHOWN SHALL BE RETAINED.
 2. FOR LEGENDS, SEE LAYOUT SHEET #1A.

NOT TO SCALE



**PROJECT
 LAYOUT
 SHEET #16**

PROJECT NAME: TROY	PLOT DATE: 25-OCT-2011 4:00
PROJECT NUMBER: STP-HES 2718(1)	DRAWN BY: STANTEC
FILE NAME: p07c200.dgn	CHECKED BY: JLL
PROJECT LEADER: JLL	SHEET 32 OF 116
DESIGNED BY: MCF	
IPARM FILE: p07c200i16.i	