

617.10 RELOCATE MAILBOX, SINGLE SUPPORT  
STA. 26+69, LT

621.20 STEEL BEAM GUARDRAIL, GALVANIZED  
STA. ~~26+68~~ TO ~~27+18~~, RT ~~27+47.5~~ - ~~27+97.5~~ LT  
STA. ~~27+43~~ TO ~~27+55.5~~, RT ~~26+68~~ - ~~27+55~~ RT  
(SEE GUARDRAIL DETAIL SHEET)

~~621.206 STEEL BEAM GUARDRAIL, GALVANIZED/NESTED~~  
~~STA. 27+18 TO 27+43, RT~~  
~~(SEE GUARDRAIL DETAIL SHEET)~~

~~621.216 HD STEEL BEAM GUARDRAIL, GALVANIZED/NESTED~~  
~~STA. 27+11 TO 27+86, LT~~  
~~(SEE GUARDRAIL DETAIL SHEET)~~

621.50 MANUFACTURED TERMINAL SECTION, FLARED  
STA. 26+30.5 TO 26+68, RT  
STA. ~~26+73.5~~ TO ~~27+11~~, LT ~~27+10~~ - ~~27+47.5~~ LT  
STA. 27+55.5 TO 27+93, RT  
STA. ~~27+86~~ TO ~~28+23.5~~, LT ~~27+97.5~~ - ~~28+35~~ LT


621.80 REMOVAL AND DISPOSAL OF GUARDRAIL  
STA. 26+31 TO 27+93, RT  
STA. 27+16 TO 28+06, LT

646.402 DURABLE 4 INCH WHITE LINE, THERMOPLASTIC  
STA. 25+50 TO 31+50, SOLID LT & RT

646.412 DURABLE 4 INCH YELLOW LINE, THERMOPLASTIC  
STA. 25+50 TO 30+36, SOLID LT & RT  
STA. 30+36 TO 31+50, SOLID LT, DASHED RT

646.602 TEMPORARY 4 INCH WHITE LINE, PAINT  
STA. 25+50 TO 31+50, SOLID LT & RT

646.612 TEMPORARY 4 INCH YELLOW LINE, PAINT  
STA. 25+50 TO 30+36, SOLID LT & RT  
STA. 30+36 TO 31+50, SOLID LT, DASHED RT

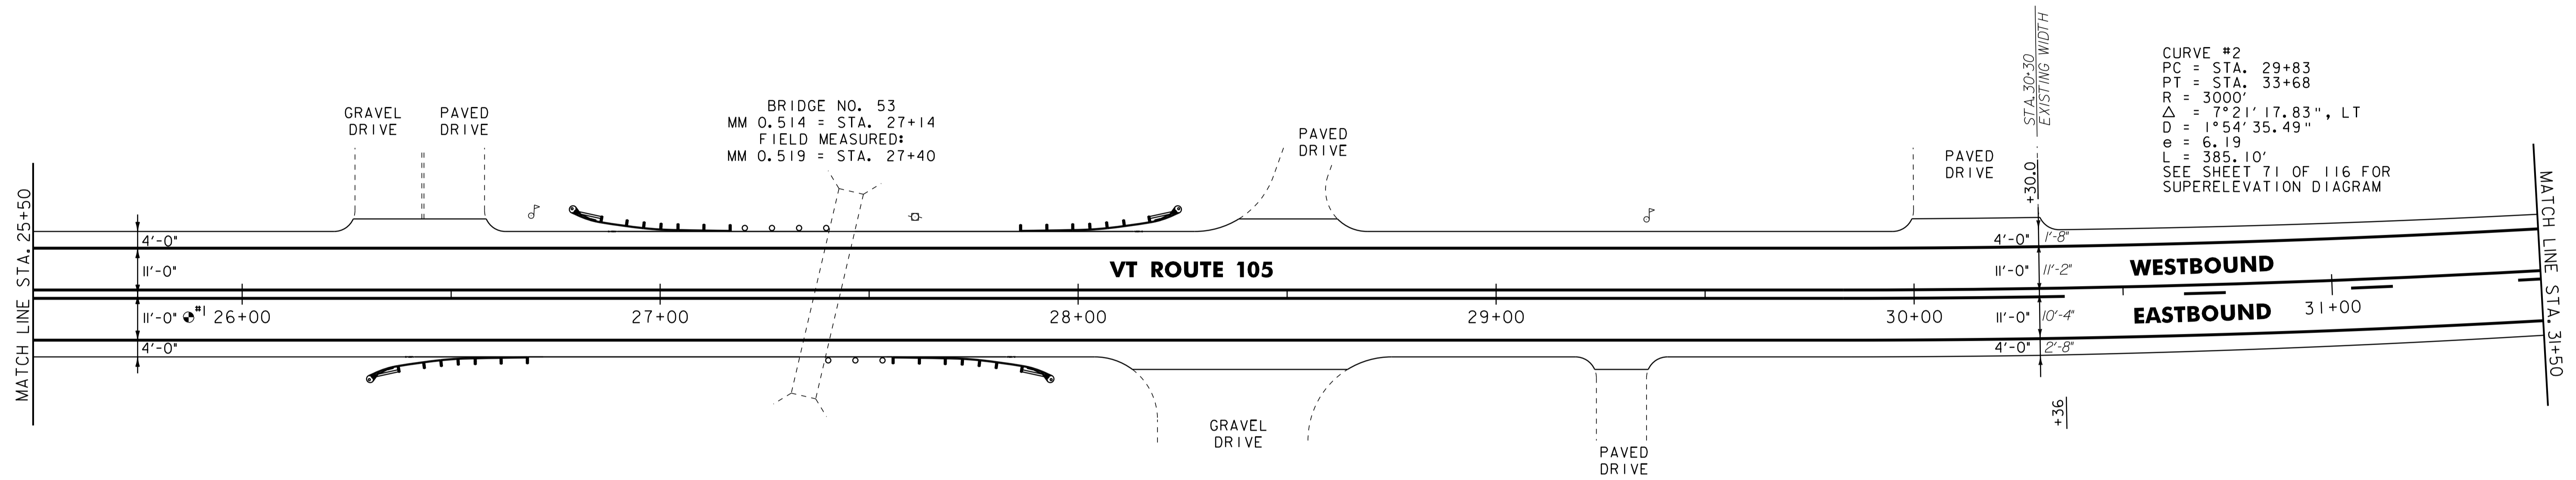

- NOTES:  
1. ALL EXISTING SIGNS NOT SHOWN SHALL BE RETAINED.  
2. FOR LEGENDS, SEE LAYOUT SHEET #1

PAVEMENT CORES =  $\odot$

#	TOTAL DEPTH (INCH)	PCC	COMMENTS
1	8	NO	RECENTLY LEVELED



NOT TO SCALE

**PROJECT LAYOUT SHEET #4**

PROJECT NAME: TROY	PLOT DATE: 25-OCT-2011 4:01
PROJECT NUMBER: STP 2717(1)	DRAWN BY: STANTEC
FILE NAME: p07b198.dgn	CHECKED BY: JLL
PROJECT LEADER: JLL	SHEET 59 OF 116
DESIGNED BY: STANTEC	
IPARM FILE: p07b198i04.i	