


646.402 DURABLE 4 INCH WHITE LINE, THERMOPLASTIC
 STA. 55+50 TO 61+50, SOLID LT & RT

646.412 DURABLE 4 INCH YELLOW LINE, THERMOPLASTIC
 STA. 55+50 TO 61+50, SOLID LT & RT

646.602 TEMPORARY 4 INCH WHITE LINE, PAINT
 STA. 55+50 TO 61+50, SOLID LT & RT

646.612 TEMPORARY 4 INCH YELLOW LINE, PAINT
 STA. 55+50 TO 61+50, SOLID LT & RT

CURVE #5
 PC = STA. 58+29
 PT = STA. 61+11
 R = 3200'
 $\Delta = 5^{\circ}02'40.00"$, LT
 D = 1^{\circ}47'25.78"
 e = 3.10
 L = 281.73'
 SEE SHEET 72 OF 116 FOR
 SUPERELEVATION DIAGRAM

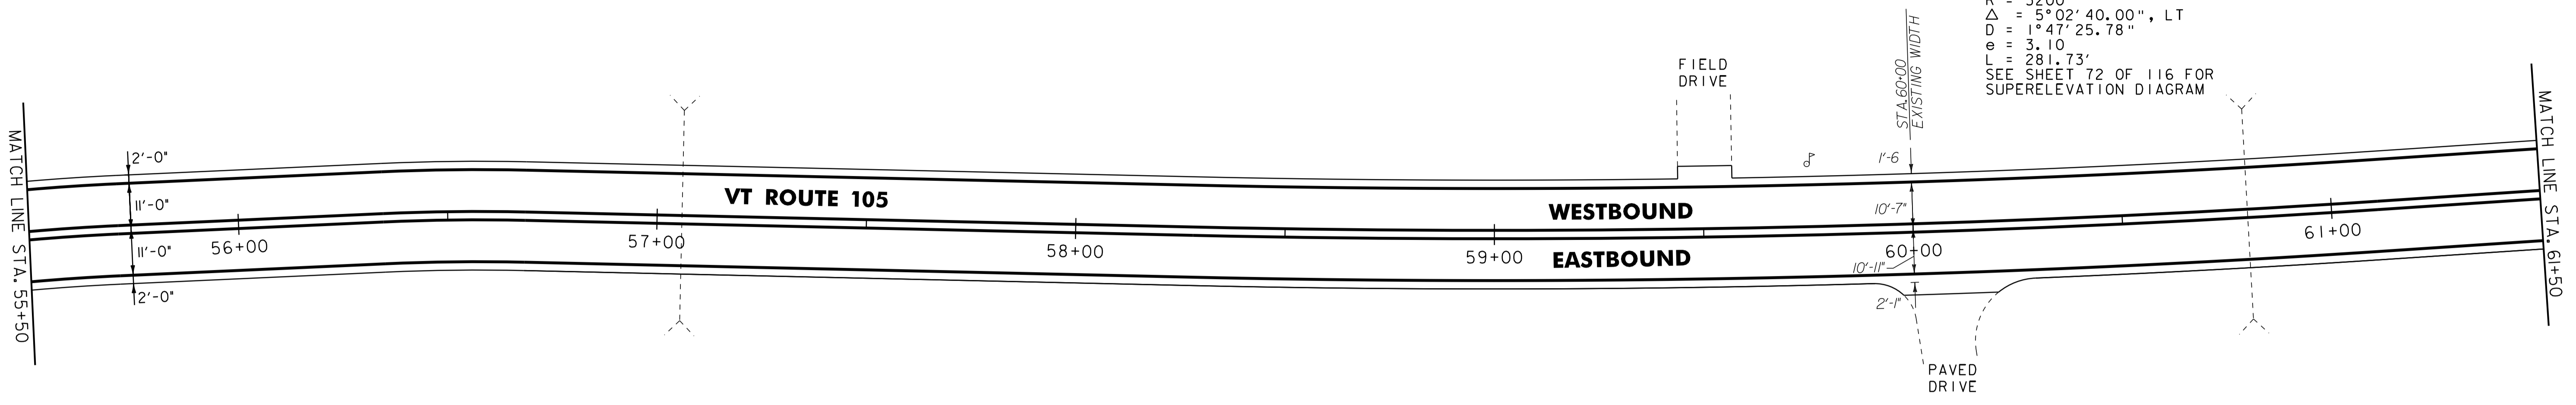


646.402 DURABLE 4 INCH WHITE LINE, THERMOPLASTIC
 STA. 61+50 TO 67+50, SOLID LT & RT

646.412 DURABLE 4 INCH YELLOW LINE, THERMOPLASTIC
 STA. 61+50 TO 66+79, SOLID LT & RT
 STA. 66+79 TO 67+50, SOLID LT, DASHED RT

646.602 TEMPORARY 4 INCH WHITE LINE, PAINT
 STA. 61+50 TO 67+50, SOLID LT & RT

646.612 TEMPORARY 4 INCH YELLOW LINE, PAINT
 STA. 61+50 TO 66+79, SOLID LT & RT
 STA. 66+79 TO 67+50, SOLID LT, DASHED RT

CURVE #6
 PC = STA. 66+34
 PT = STA. 67+97
 R = 1500'
 $\Delta = 6^{\circ}13'17.44"$, RT
 D = 3^{\circ}49'10.99"
 e = 2.21
 L = 162.88'
 SEE SHEET 73 OF 116 FOR
 SUPERELEVATION DIAGRAM

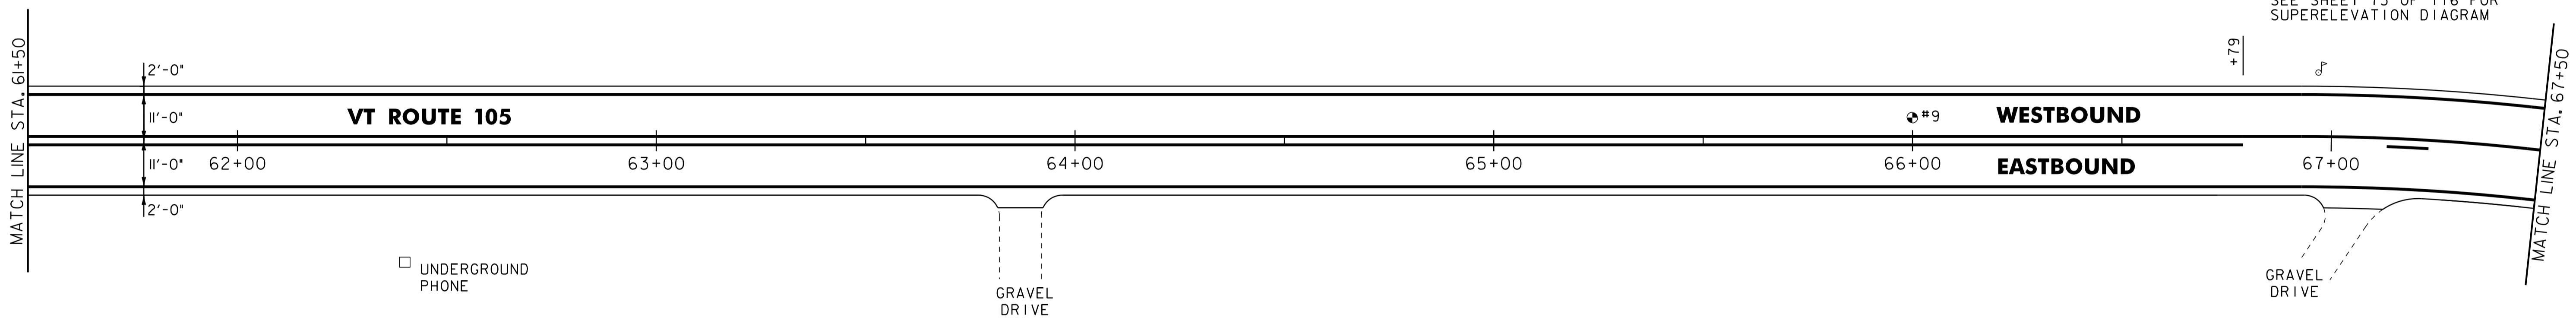

- NOTES:
 1. ALL EXISTING SIGNS NOT SHOWN SHALL BE RETAINED.
 2. FOR LEGENDS, SEE LAYOUT SHEET #1

PAVEMENT CORES = \odot

#	TOTAL DEPTH (INCH)	PCC	COMMENTS
9	8 1/2"	NO	TOP 7" SOLID



NOT TO SCALE

PROJECT LAYOUT SHEET #7

PROJECT NAME: TROY	PLOT DATE: 25-OCT-2011 4:02
PROJECT NUMBER: STP 2717(I)	DRAWN BY: STANTEC
FILE NAME: p07b198.dgn	CHECKED BY: JLL
PROJECT LEADER: JLL	SHEET 62 OF 116
DESIGNED BY: STANTEC	
IPARM FILE: p07b198i07.i	