


646.402 DURABLE 4 INCH WHITE LINE, THERMOPLASTIC  
STA. 91+50 TO 97+50, SOLID LT & RT

646.602 TEMPORARY 4 INCH WHITE LINE, PAINT  
STA. 91+50 TO 97+50, SOLID LT & RT

646.412 DURABLE 4 INCH YELLOW LINE, THERMOPLASTIC  
STA. 91+50 TO 91+87, SOLID LT, DASHED RT  
STA. 91+87 TO 93+19, DASHED C  
STA. 93+19 TO 97+50, DASHED LT, SOLID RT

646.612 TEMPORARY 4 INCH YELLOW LINE, PAINT  
STA. 91+50 TO 91+87, SOLID LT, DASHED RT  
STA. 91+87 TO 93+19, DASHED C  
STA. 93+19 TO 97+50, DASHED LT, SOLID RT

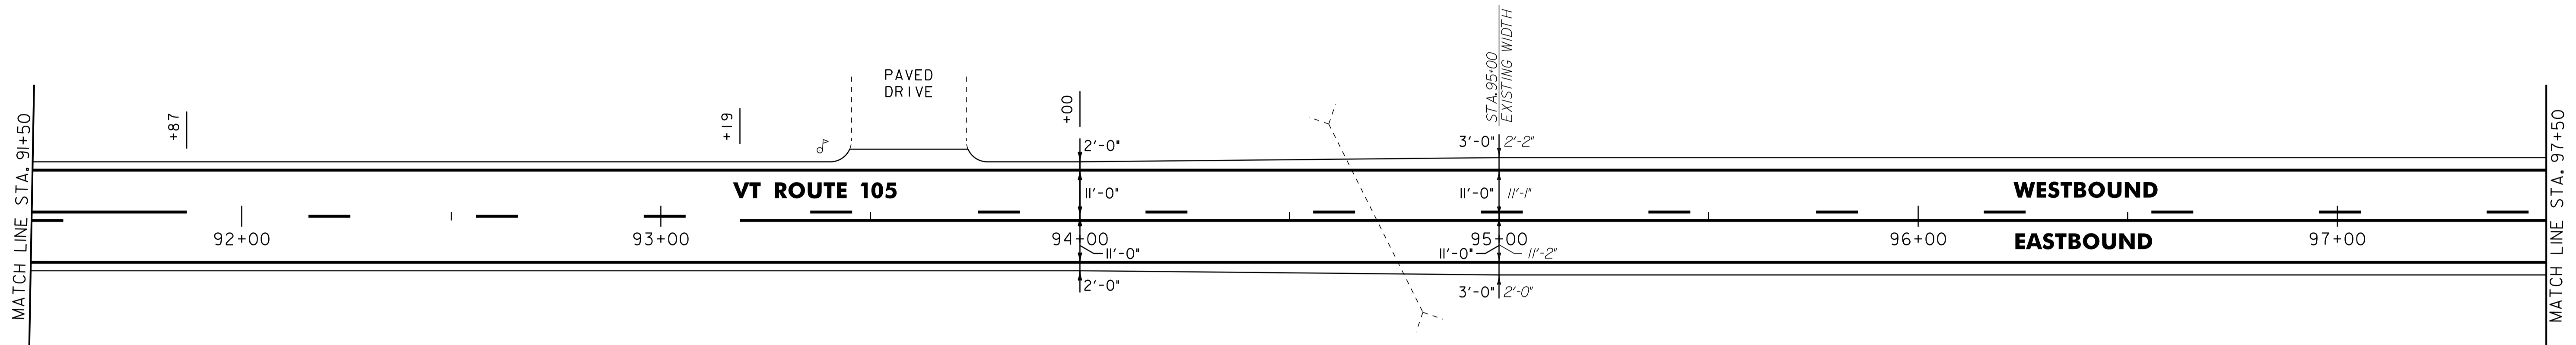

NOTES:  
1. ALL EXISTING SIGNS NOT SHOWN SHALL BE RETAINED.  
2. FOR LEGENDS, SEE LAYOUT SHEET #1

NOT TO SCALE



**PROJECT  
LAYOUT  
SHEET #10**

PROJECT NAME: TROY	PLOT DATE: 25-OCT-2011 4:02
PROJECT NUMBER: STP 2717(1)	DRAWN BY: STANTEC
FILE NAME: p07b198.dgn	CHECKED BY: JLL
PROJECT LEADER: JLL	SHEET 65 OF 116
DESIGNED BY: STANTEC	
<b>IPARM FILE: p07b198I10.i</b>	