


646.402 DURABLE 4 INCH WHITE LINE, THERMOPLASTIC
STA. 103+50 TO 109+50, SOLID LT & RT

646.602 TEMPORARY 4 INCH WHITE LINE, PAINT
STA. 103+50 TO 109+50, SOLID LT & RT

675.50 REMOVING SIGNS
AS SHOWN - 1



646.412 DURABLE 4 INCH YELLOW LINE, THERMOPLASTIC
STA. 103+50 TO 109+50, SOLID LT & RT

646.612 TEMPORARY 4 INCH YELLOW LINE, PAINT
STA. 103+50 TO 109+50, SOLID LT & RT

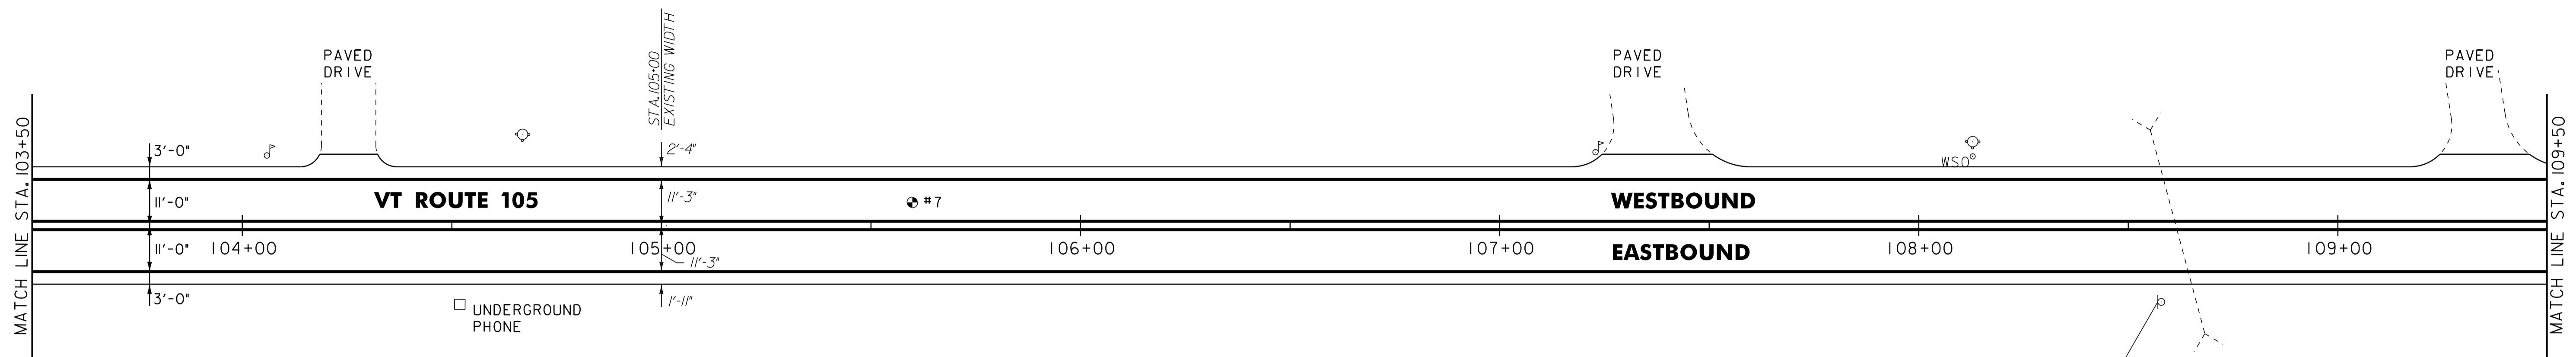

PAVEMENT CORES =

#	TOTAL DEPTH (INCH)	PCC	COMMENTS
7	9 1/2"	NO	

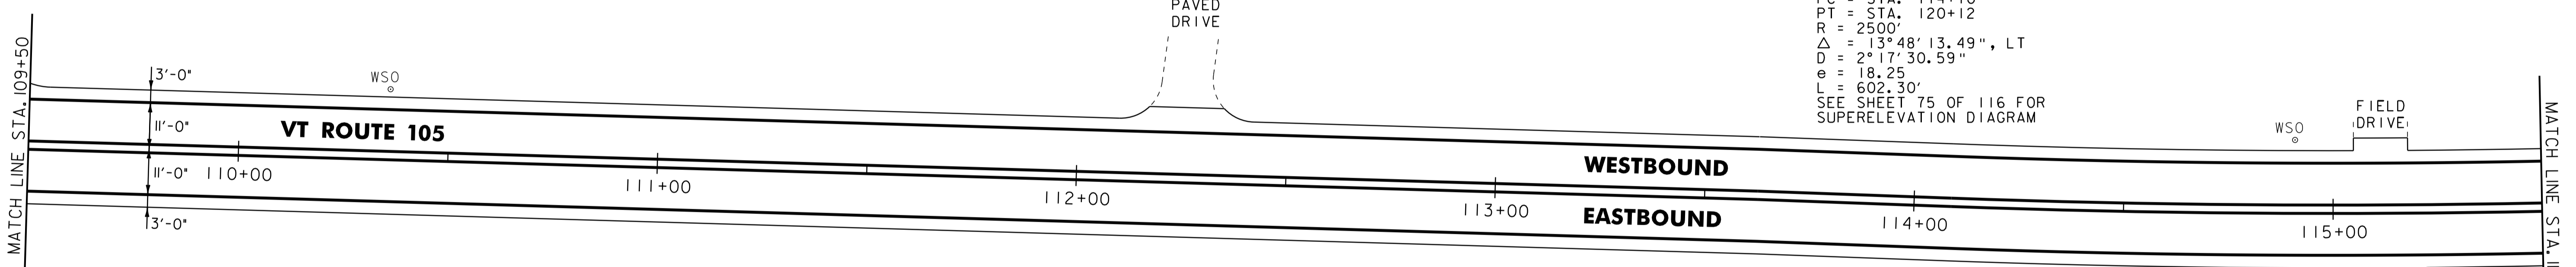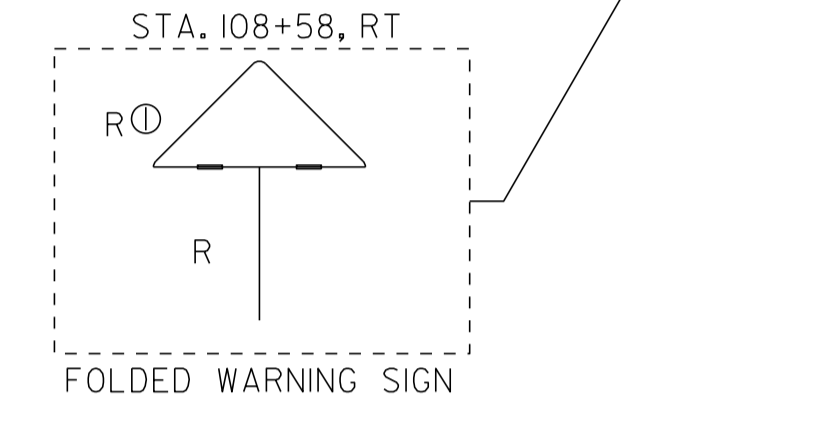

CURVE #12
PC = STA. 114+10
PT = STA. 120+12
R = 2500'
 $\Delta = 13^\circ 48' 13.49"$, LT
D = $2^\circ 17' 30.59"$
e = 18.25'
L = 602.30'
SEE SHEET 75 OF 116 FOR SUPERELEVATION DIAGRAM

646.402 DURABLE 4 INCH WHITE LINE, THERMOPLASTIC
STA. 109+50 TO 115+50, SOLID LT & RT

646.602 TEMPORARY 4 INCH WHITE LINE, PAINT
STA. 109+50 TO 115+50, SOLID LT & RT

646.412 DURABLE 4 INCH YELLOW LINE, THERMOPLASTIC
STA. 109+50 TO 115+50, SOLID LT & RT

646.612 TEMPORARY 4 INCH YELLOW LINE, PAINT
STA. 109+50 TO 115+50, SOLID LT & RT

- NOTES:
1. ALL EXISTING SIGNS NOT SHOWN SHALL BE RETAINED.
 2. FOR LEGENDS, SEE LAYOUT SHEET #1



NOT TO SCALE

PROJECT LAYOUT SHEET #12

PROJECT NAME: TROY	PLOT DATE: 25-OCT-2011 4:02
PROJECT NUMBER: STP 2717(1)	DRAWN BY: STANTEC
FILE NAME: p07b198.dgn	CHECKED BY: JLL
PROJECT LEADER: JLL	SHEET 67 OF 116
DESIGNED BY: STANTEC	
IPARM FILE: p07b198I12.i	