

604.412, 604.415 OR 604.418 REHAB,
Dis. CBS OR MHS, CLASS I, II OR III
STA. 139+85, LT & RT
STA. 141+83, LT & RT

604.42 CHANGING ELEVATION OF SEWER MANHOLES
STA. 140+10, LT
STA. 143+20, LT

629.20 ADJUST ELEVATION OF VALVE BOX
STA. 139+95, RT
STA. 142+30, RT

646.402 DURABLE 4 INCH WHITE LINE, THERMOPLASTIC
(ALL LINES WILL INCLUDE EDGE LINE AND LANE LINE
BREAKS AND RADII FOR SIDE ROADS)
STA. 138+00 TO 143+50, SOLID LT & RT

646.412 DURABLE 4 INCH YELLOW LINE, THERMOPLASTIC
(ALL LINES WILL INCLUDE C BREAKS FOR SIDE ROADS)
STA. 138+00 TO 143+50, SOLID LT & RT


646.502 DURABLE CROSSWALK MARKING, THERMOPLASTIC
STA. 142+20 TO 142+50, LT

646.602 TEMPORARY 4 INCH WHITE LINE, PAINT
(ALL LINES WILL INCLUDE EDGE LINE AND LANE LINE
BREAKS AND RADII FOR SIDE ROADS)
STA. 138+00 TO 143+50, SOLID LT & RT

646.612 TEMPORARY 4 INCH YELLOW LINE, PAINT
(ALL LINES WILL INCLUDE C BREAKS FOR SIDE ROADS)
STA. 138+00 TO 143+50, SOLID LT & RT

646.702 TEMPORARY CROSSWALK MARKING, PAINT
STA. 142+20 TO 142+50, LT

675.50 REMOVING SIGNS
AS SHOWN - 5

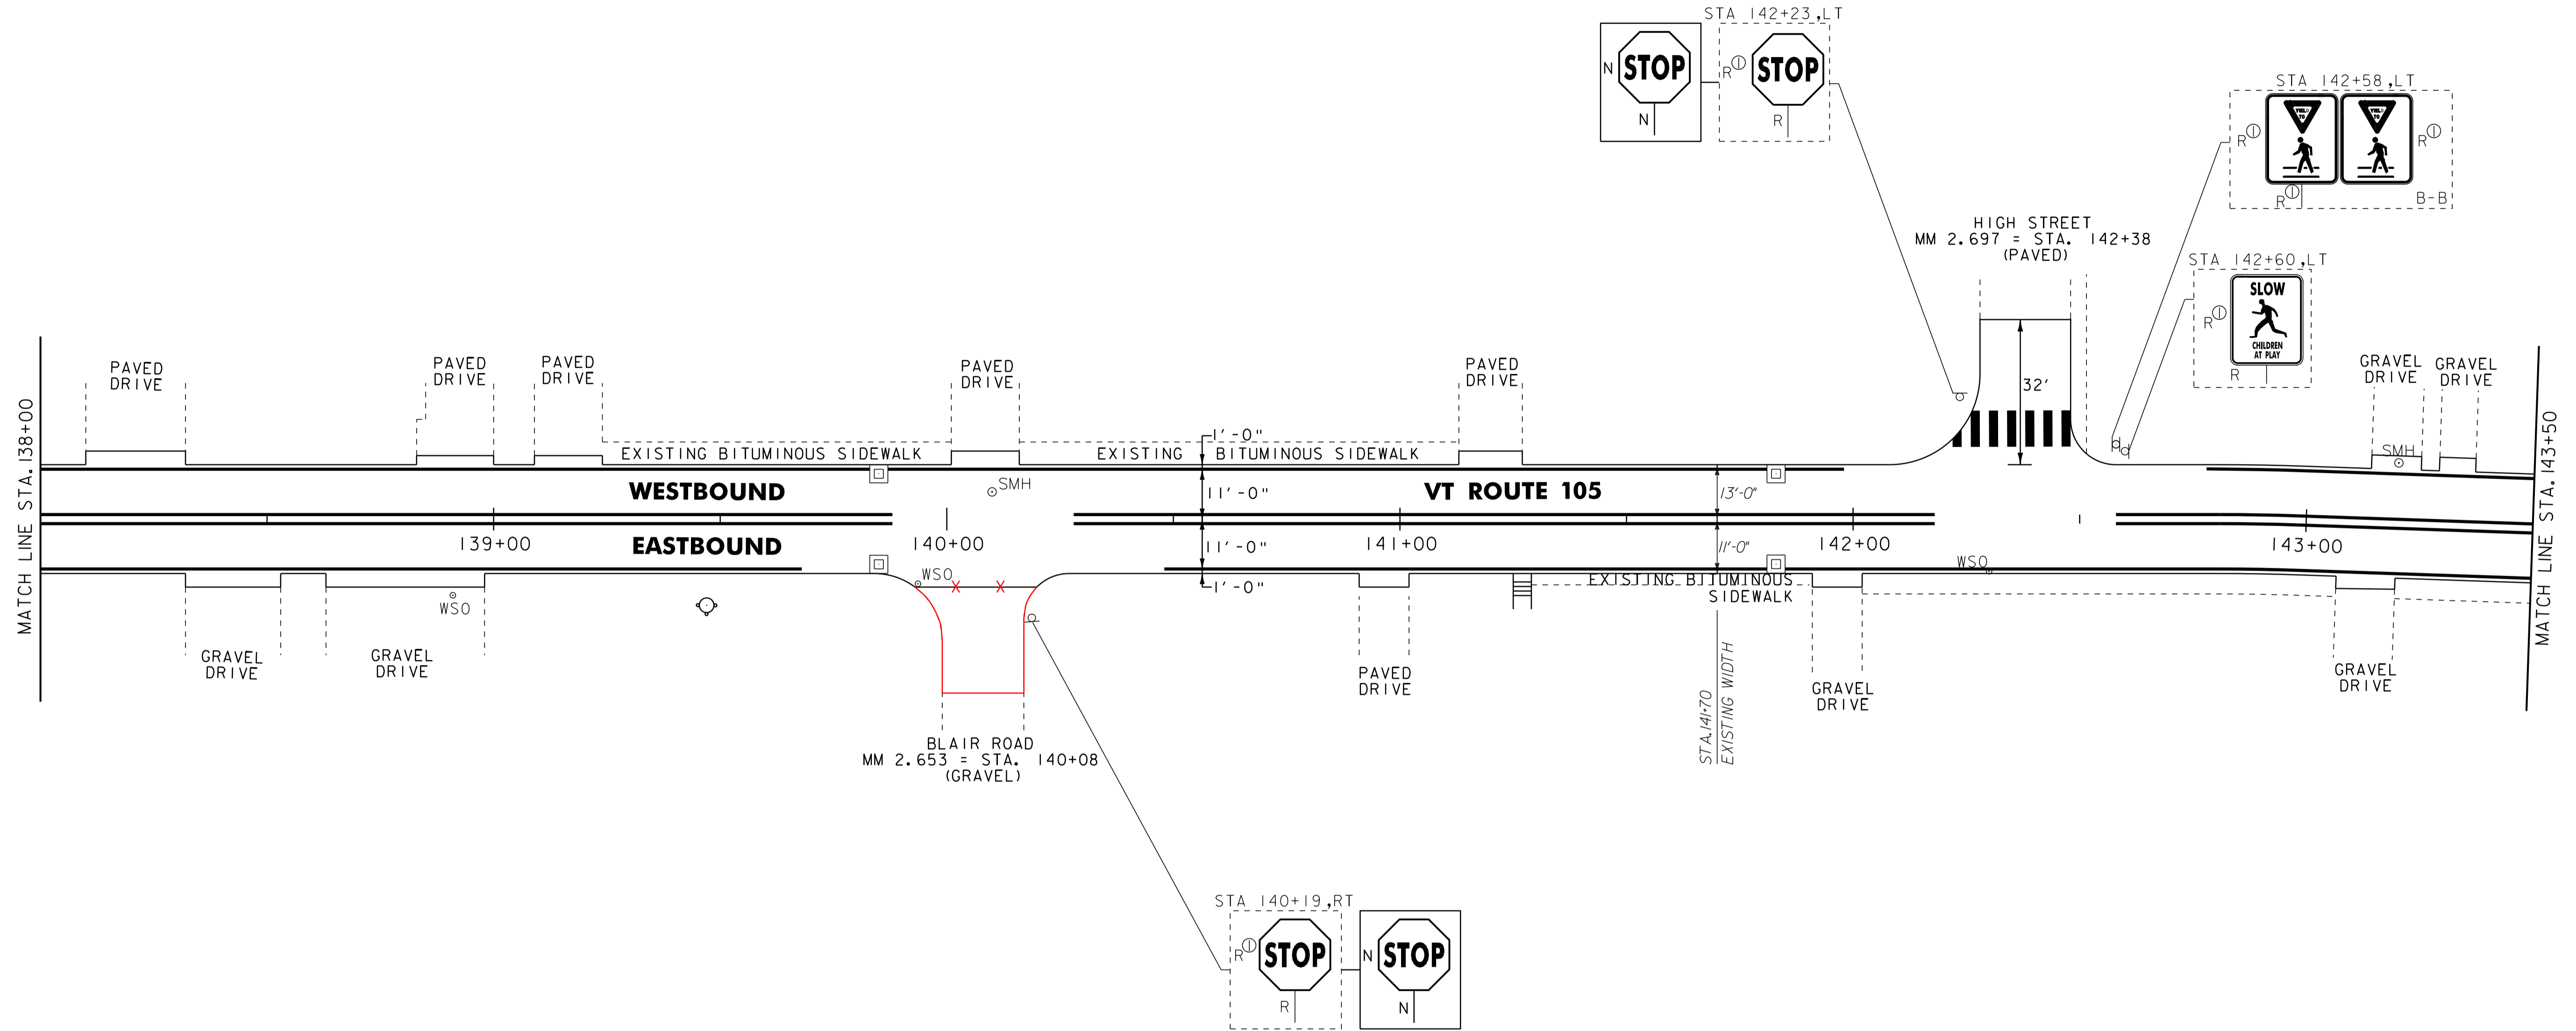

- NOTES:
 1. ALL EXISTING SIGNS NOT SHOWN SHALL BE RETAINED.
 2. FOR LEGENDS, SEE LAYOUT SHEET #1.



NOT TO SCALE

**PROJECT
LAYOUT
SHEET #3**

PROJECT NAME: NORTH TROY	PLOT DATE: 25-OCT-2011 14:03
PROJECT NUMBER: STP 2620(1)	DRAWN BY: STANTEC
FILE NAME: p06b208.dgn	CHECKED BY: JLL
PROJECT LEADER: JLL	SHEET 87 OF 116
DESIGNED BY: MCF	
IPARM FILE: p06b208103.i	