

629.20 ADJUST ELEVATION OF VALVE BOX  
 STA. 156+32, RT  
 STA. 156+33, RT  
 STA. 157+74, RT


646.402 DURABLE 4 INCH WHITE LINE, THERMOPLASTIC  
 (ALL LINES WILL INCLUDE EDGE LINE AND LANE LINE  
 BREAKS AND RADII FOR SIDE ROADS)  
 STA. 154+00 TO 159+00, SOLID LT & RT

646.602 TEMPORARY 4 INCH WHITE LINE, PAINT  
 (ALL LINES WILL INCLUDE EDGE LINE AND LANE LINE  
 BREAKS AND RADII FOR SIDE ROADS)  
 STA. 154+00 TO 159+00, SOLID LT & RT

675.50 REMOVING SIGNS  
 AS SHOWN - 1

646.412 DURABLE 4 INCH YELLOW LINE, THERMOPLASTIC  
 (ALL LINES WILL INCLUDE  $\odot$  BREAKS FOR SIDE ROADS)  
 STA. 154+00 TO 159+00, SOLID LT & RT

646.612 TEMPORARY 4 INCH YELLOW LINE, PAINT  
 (ALL LINES WILL INCLUDE  $\odot$  BREAKS FOR SIDE ROADS)  
 STA. 154+00 TO 159+00, SOLID LT & RT

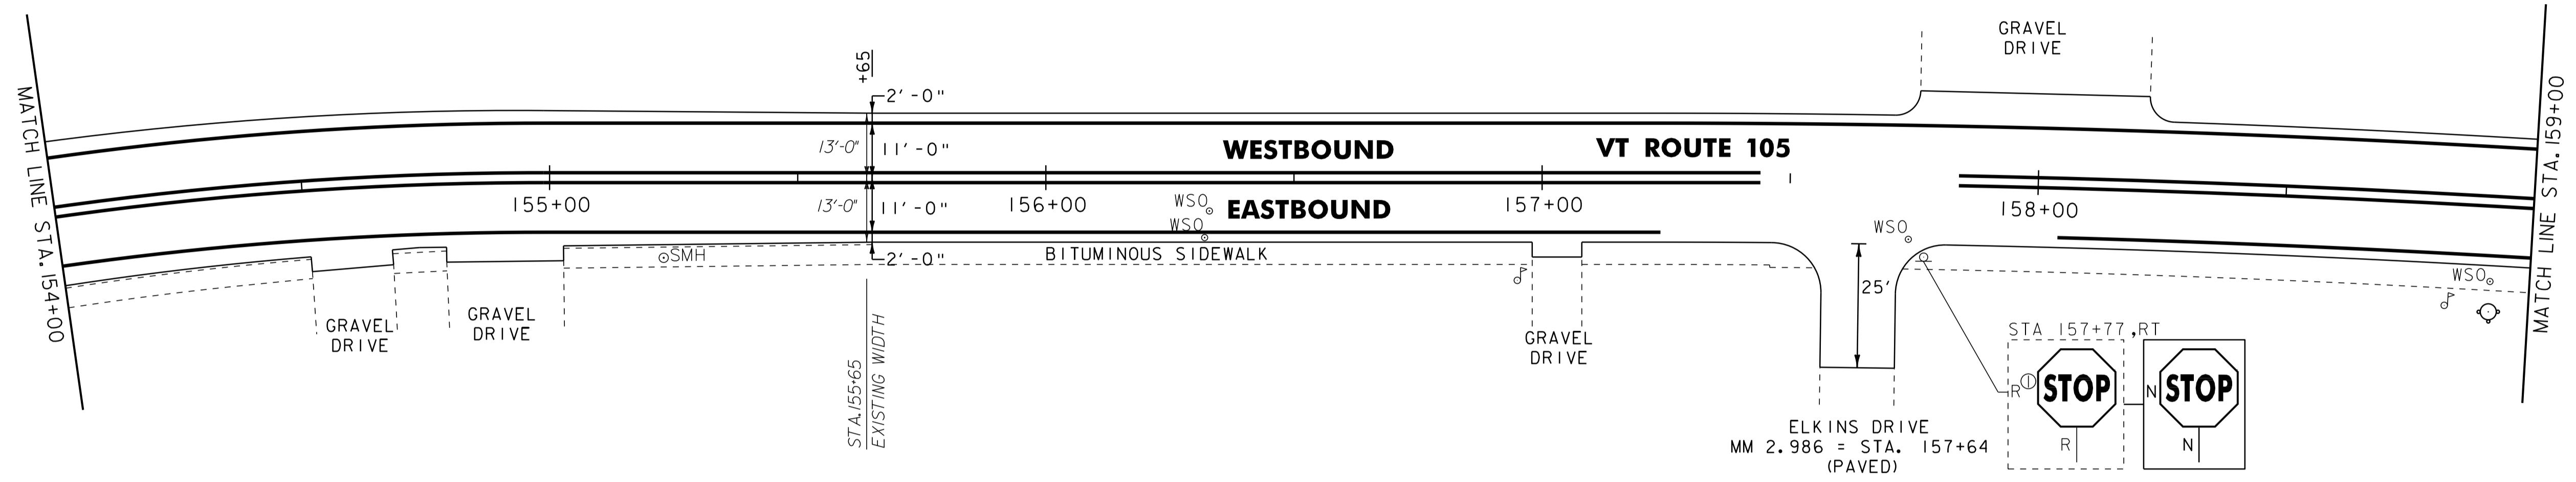

NOTES:  
 1. ALL EXISTING SIGNS NOT SHOWN SHALL BE RETAINED.  
 2. FOR LEGENDS, SEE LAYOUT SHEET #1.



NOT TO SCALE

**PROJECT  
 LAYOUT  
 SHEET #6**

PROJECT NAME: NORTH TROY	PLOT DATE: 25-OCT-2011 4:03
PROJECT NUMBER: STP 2620(1)	DRAWN BY: STANTEC
FILE NAME: p06b208.dgn	CHECKED BY: JLL
PROJECT LEADER: JLL	SHEET 90 OF 116
DESIGNED BY: MCF	
IPARM FILE: p06B208106.i	