

604.42 CHANGING ELEVATION OF SEWER MANHOLES
 STA. 160+12, LT
 STA. 162+12, LT
 STA. 163+65, LT

618.10 PORTLAND CEMENT CONCRETE SIDEWALK, 5 INCH
 STA. 161+80, RT

618.30 DETECTABLE WARNING SURFACE
 STA. 161+80, RT
 162+10, LT

629.20 ADJUST ELEVATION OF VALVE BOX
 STA. 162+13, RT
 STA. 162+24, RT

646.402 DURABLE 4 INCH WHITE LINE, THERMOPLASTIC
 (ALL LINES WILL INCLUDE EDGE LINE AND LANE LINE
 BREAKS AND RADII FOR SIDE ROADS)
 STA. 159+00 TO 164+00, SOLID LT & RT

646.412 DURABLE 4 INCH YELLOW LINE, THERMOPLASTIC
 (ALL LINES WILL INCLUDE C BREAKS FOR SIDE ROADS)
 STA. 159+00 TO 164+00, SOLID LT & RT


646.502 DURABLE CROSSWALK MARKING, THERMOPLASTIC
 STA. 161+81, LT & RT

646.602 TEMPORARY 4 INCH WHITE LINE, PAINT
 (ALL LINES WILL INCLUDE EDGE LINE AND LANE LINE
 BREAKS AND RADII FOR SIDE ROADS)
 STA. 159+00 TO 164+00, SOLID LT & RT

646.612 TEMPORARY 4 INCH YELLOW LINE, PAINT
 (ALL LINES WILL INCLUDE C BREAKS FOR SIDE ROADS)
 STA. 159+00 TO 164+00, SOLID LT & RT

646.702 TEMPORARY CROSSWALK MARKING, PAINT
 STA. 161+81, LT & RT

675.50 REMOVING SIGNS
 AS SHOWN - 3

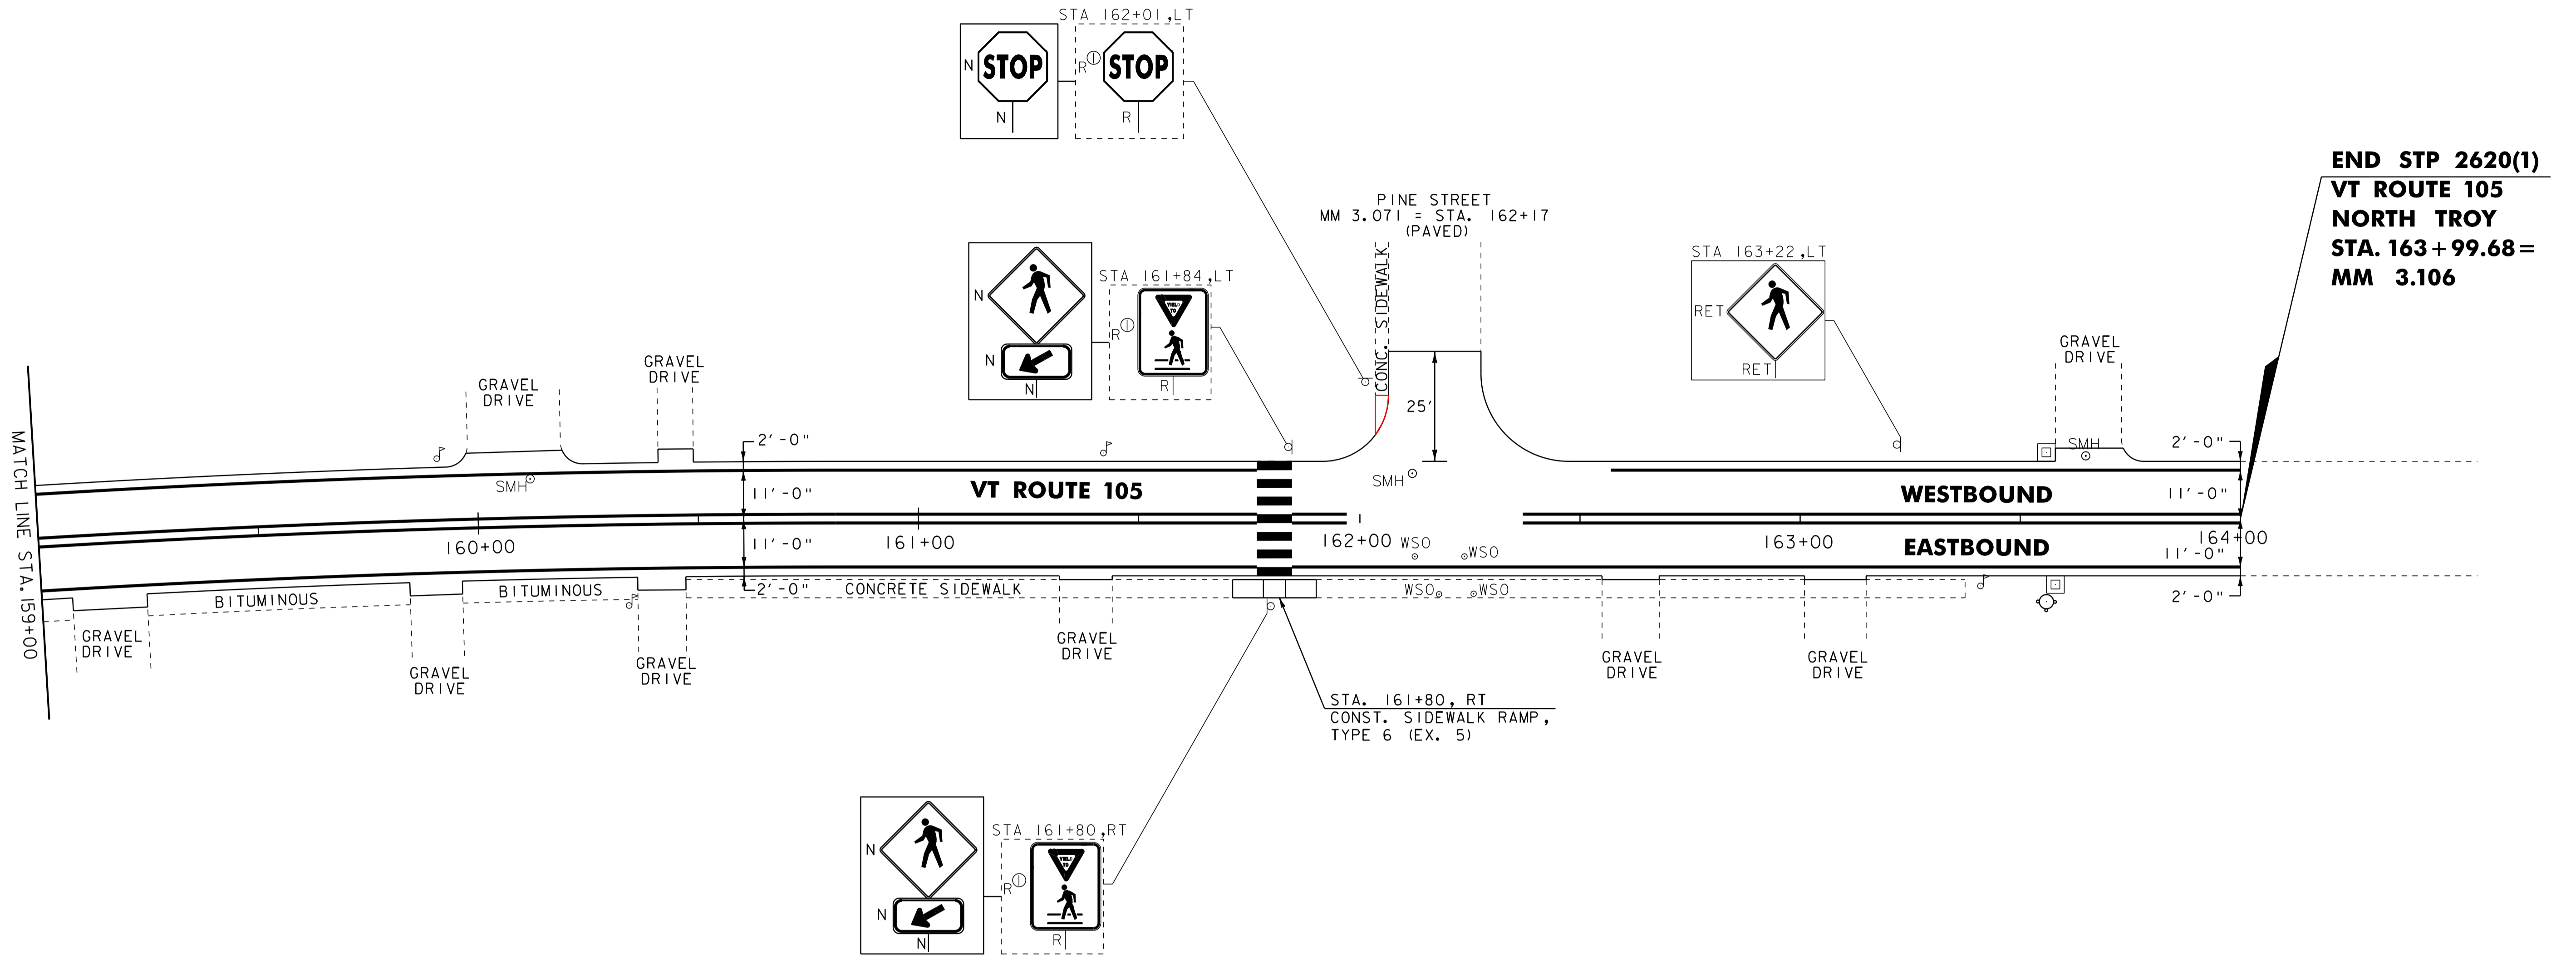

END STP 2620(1)
VT ROUTE 105
NORTH TROY
STA. 163+99.68 =
MM 3.106

NOTES:
 1. ALL EXISTING SIGNS NOT SHOWN SHALL BE RETAINED.
 2. FOR LEGENDS, SEE LAYOUT SHEET #1.

NOT TO SCALE



PROJECT LAYOUT SHEET #7

PROJECT NAME: NORTH TROY	PLOT DATE: 25-OCT-2011 4:03
PROJECT NUMBER: STP 2620(1)	DRAWN BY: STANTEC
FILE NAME: p06b208.dgn	CHECKED BY: JLL
PROJECT LEADER: JLL	SHEET 91 OF 116
DESIGNED BY: MCF	
IPARM FILE: p06b208107.i	