

604.412, 604.415 OR 604.418 REHAB,
DIS, CBS OR MHS, CLASS I, II OR III
STA. 46+59, RT

604.42 CHANGING ELEVATION OF SEWER MANHOLES
STA. 45+92, LT
STA. 46+82, LT

629.20 ADJUST ELEVATION OF VALVE BOX
STA. 46+55, RT
STA. 46+64, RT
STA. 46+67, RT
STA. 46+71, RT

646.402 DURABLE 4 INCH WHITE LINE, THERMOPLASTIC
(ALL LINES WILL INCLUDE EDGE LINE AND LANE LINE
BREAKS AND RADII FOR SIDE ROADS)
STA. 45+78 TO 48+50, SOLID LT & RT
STA. 46+18, DOUBLE SOLID LT, (DOMINION AVE. EDGELINES)
STA. 46+76, DOUBLE SOLID RT, (ELM STREET EDGELINES)

646.412 DURABLE 4 INCH YELLOW LINE, THERMOPLASTIC
(ALL LINES WILL INCLUDE C BREAKS FOR SIDE ROADS)
STA. 45+78 TO 48+50, SOLID LT & RT
STA. 46+18, DOUBLE SOLID LT (DOMINION AVE.)
STA. 46+76, DOUBLE SOLID RT (ELM STREET)

646.482 DURABLE 24 INCH STOP BAR, THERMOPLASTIC
STA. 46+18, LT (DOMINION AVE.)
STA. 46+77, RT (ELM ST.)

646.492 DURABLE LETTER OR SYMBOL, THERMOPLASTIC
STA. 46+11, LT - "STOP"
STA. 46+82, RT - "STOP"

646.502 DURABLE CROSSWALK MARKING, THERMOPLASTIC
STA. 46+73, LT TO 46+91, RT

646.602 TEMPORARY 4 INCH WHITE LINE, PAINT
(ALL LINES WILL INCLUDE EDGE LINE AND LANE LINE
BREAKS AND RADII FOR SIDE ROADS)
STA. 45+78 TO 48+50, SOLID LT & RT
STA. 46+18, DOUBLE SOLID LT, (DOMINION AVE. EDGELINES)
STA. 46+76, DOUBLE SOLID RT, (ELM STREET EDGELINES)


646.612 TEMPORARY 4 INCH YELLOW LINE, PAINT
(ALL LINES WILL INCLUDE C BREAKS FOR SIDE ROADS)
STA. 45+78 TO 48+50, SOLID LT & RT
STA. 46+18, DOUBLE SOLID LT (DOMINION AVE.)
STA. 46+76, DOUBLE SOLID RT (ELM STREET)

646.682 TEMPORARY 24 INCH STOP BAR, PAINT
STA. 46+18, LT (DOMINION AVE.)
STA. 46+77, RT (ELM ST.)

646.692 TEMPORARY LETTER OR SYMBOL, PAINT
STA. 46+11, LT - "STOP"
STA. 46+82, RT - "STOP"

646.702 TEMPORARY CROSSWALK MARKING, PAINT
STA. 46+73, LT TO 46+91, RT

675.50 REMOVING SIGNS
AS SHOWN - 2

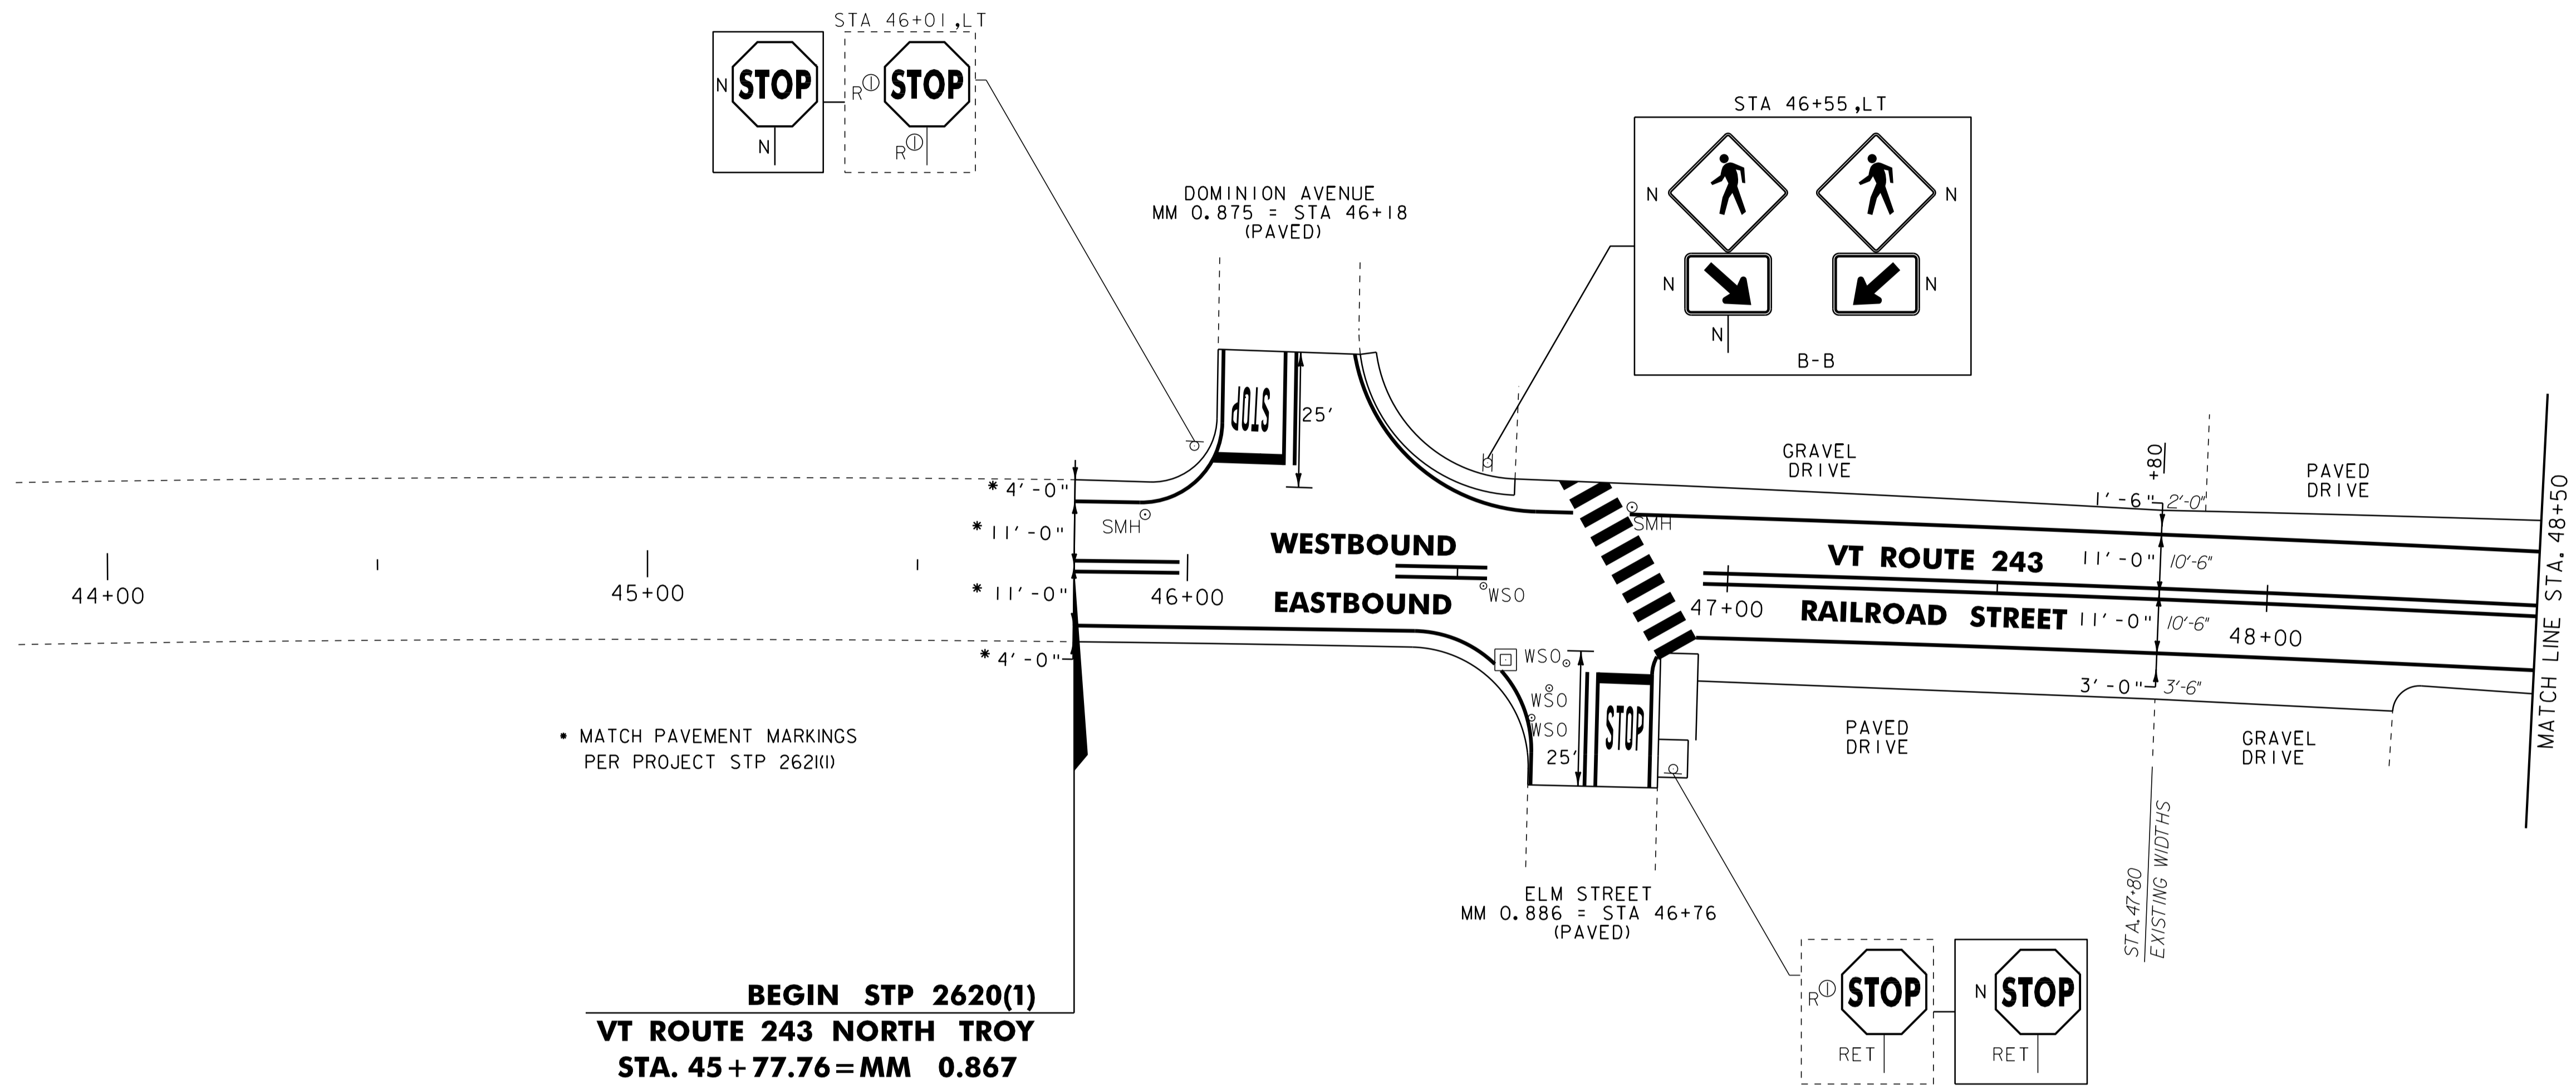

NOTES:
1. ALL EXISTING SIGNS NOT SHOWN SHALL BE RETAINED.
2. FOR LEGENDS, SEE LAYOUT SHEET #1.



NOT TO SCALE

**PROJECT
LAYOUT
SHEET #8**

PROJECT NAME: NORTH TROY	PLOT DATE: 25-OCT-2011 14:04
PROJECT NUMBER: STP 2620(1)	DRAWN BY: STANTEC
FILE NAME: p06b208.dgn	CHECKED BY: JLL
PROJECT LEADER: JLL	SHEET 92 OF 116
DESIGNED BY: MCF	
IPARM FILE: p06b208108.i	