

604.412 REHAB. DIS, CBs OR MHS, CLASS 1
STA. 7+74, RT

646.402 DURABLE 4 INCH WHITE LINE, THERMOPLASTIC
STA. 6+12 TO 9+00, SOLID LT
STA. ~~7+33~~ TO 9+00, SOLID RT
6+12

646.412 DURABLE 4 INCH YELLOW LINE, THERMOPLASTIC
STA. 6+12 TO 9+00, SOLID LT & RT

646.492 DURABLE LETTER OR SYMBOL, THERMOPLASTIC
STA. 6+30, LT - "AHEAD"
STA. 6+70, LT - "STOP"


646.602 TEMPORARY 4 INCH WHITE LINE, PAINT
STA. 6+12 TO 9+00, SOLID LT
STA. 7+33 TO 9+00, SOLID RT

646.612 TEMPORARY 4 INCH YELLOW LINE, PAINT
STA. 6+12 TO 9+00, SOLID LT & RT

646.692 TEMPORARY LETTER OR SYMBOL, PAINT
STA. 6+30, LT - "AHEAD"
STA. 6+70, LT - "STOP"

621.80 REMOVAL & DISPOSAL OF GUARDRAIL
STA. 6+27.5 TO 6+65 LT

621.50 MANUFACTURED TERMINAL SECTION, FLARED
STA. 6+27.5 TO 6+65 LT

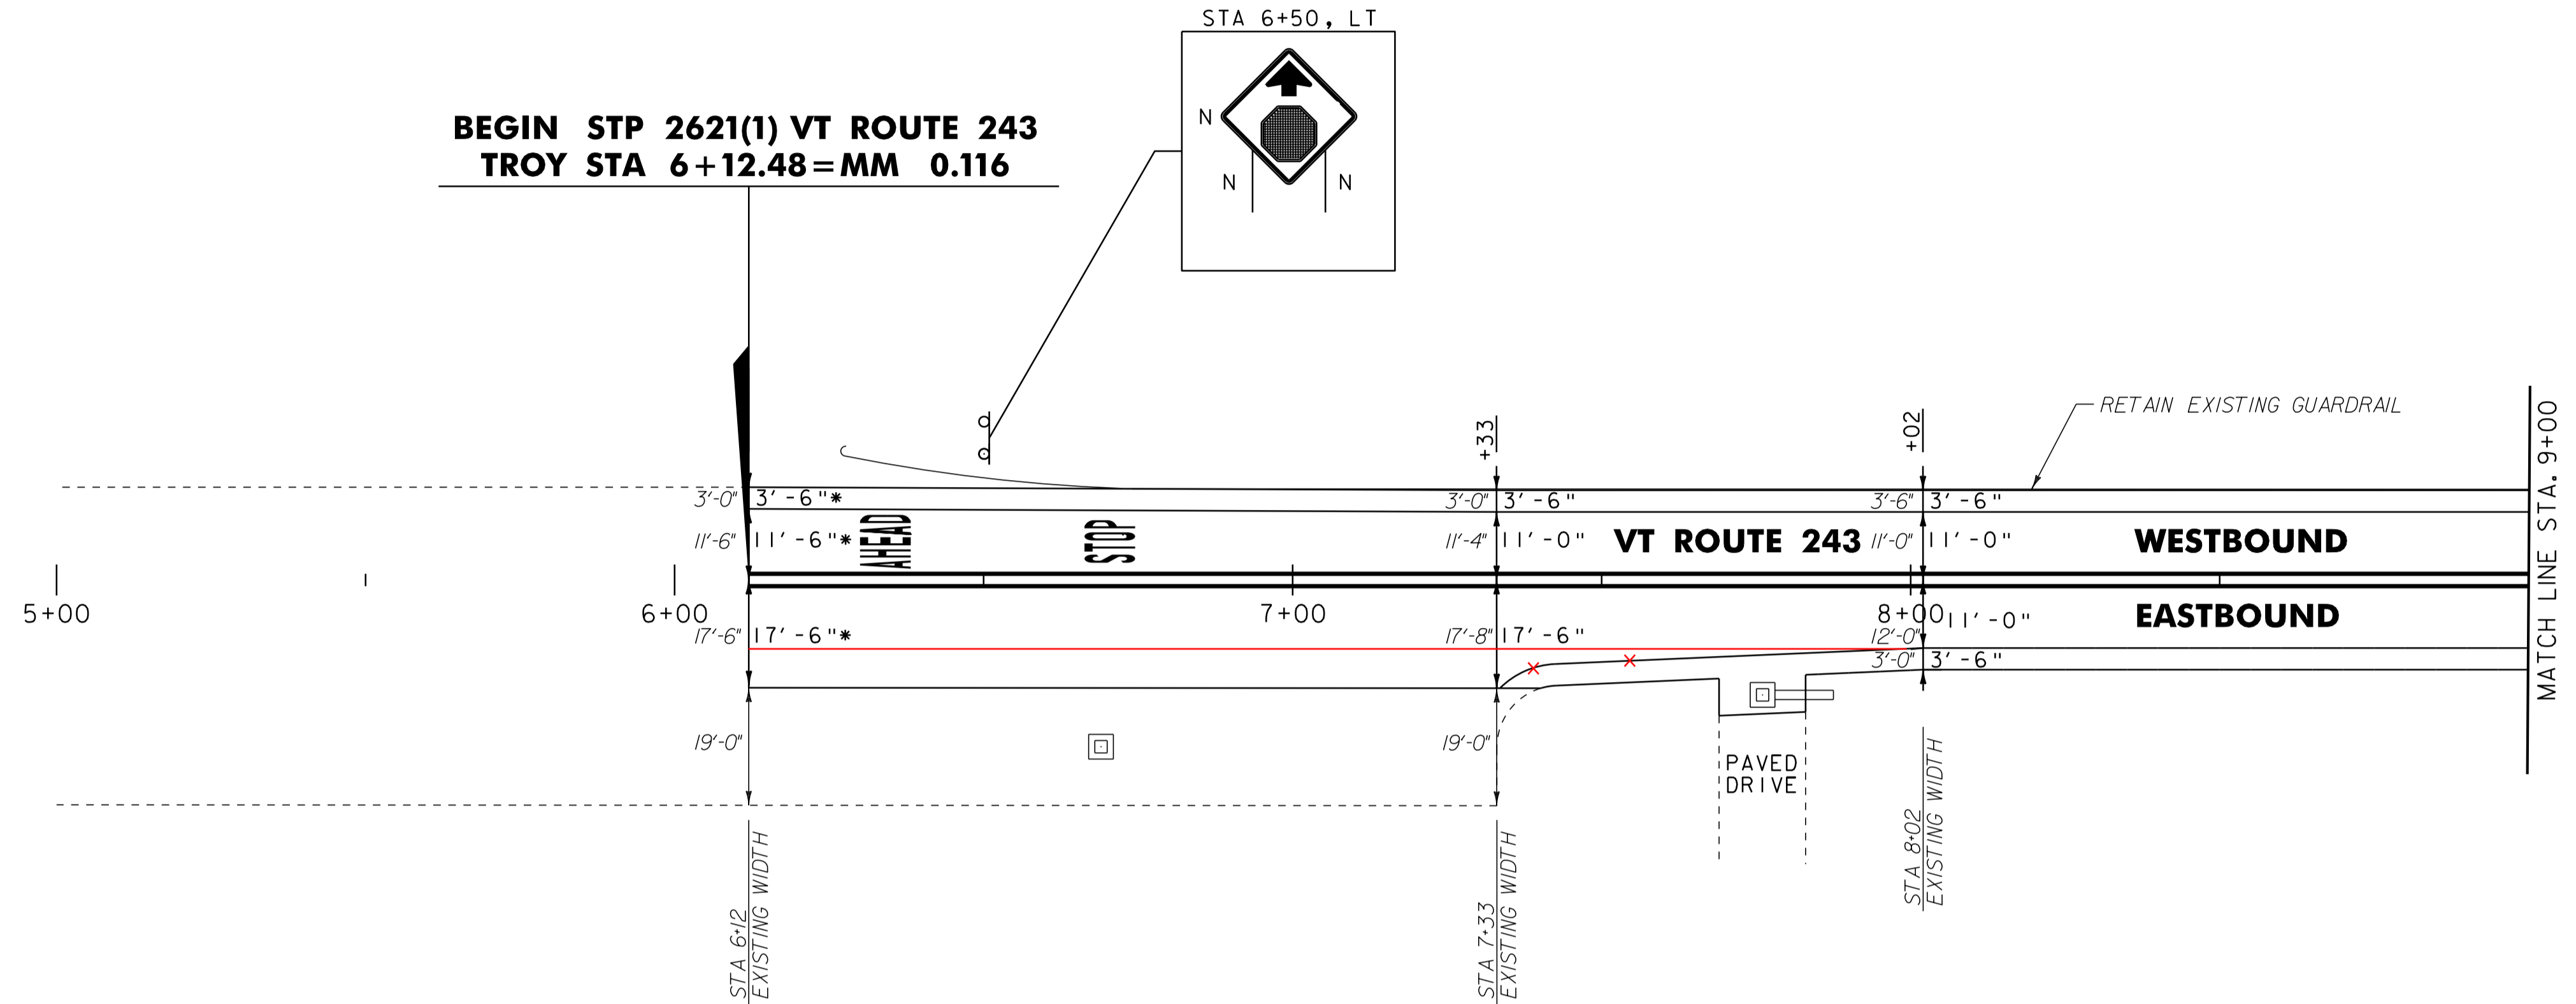

* MATCH EXISTING PAVEMENT MARKINGS

UTILITY LEGEND	
	= EXISTING HYDRANT
	= EXISTING DI
	= EXISTING MANHOLE
	= EXISTING TELEPHONE MANHOLE
	= EXISTING ELECTRIC MANHOLE
	= EXISTING SEWER MANHOLE
	= EXISTING WATER SHUTOFF
	= EXISTING GAS SHUTOFF
	= EXISTING MAILBOX
	= REMOVE AND RETURN TO VILLAGE OF NORTH TROY

SIGN LEGEND	
N	= NEW
R	= REMOVE
R&S	= REMOVE & SALVAGE
S	= SALVAGE SIGN
RET	= RETAIN
B-B	= BACK TO BACK
R	= RETURN TO TOWN OF TROY

NOTE:
ALL EXISTING SIGNS NOT SHOWN SHALL BE RETAINED.



NOT TO SCALE

PROJECT LAYOUT SHEET #1

PROJECT NAME: TROY	PLOT DATE: 25-OCT-2011 14:04
PROJECT NUMBER: STP 2621(1)	DRAWN BY: STANTEC
FILE NAME: p06c210.dgn	CHECKED BY: JLL
PROJECT LEADER: JLL	SHEET 108 OF 116
DESIGNED BY: MCF	
IPARM FILE: p06c210101.i	