

646.402 DURABLE 4 INCH WHITE LINE, THERMOPLASTIC
STA. 36+50 TO 42+00, SOLID LT & RT

646.602 TEMPORARY 4 INCH WHITE LINE, PAINT
STA. 36+50 TO 42+00, SOLID LT & RT


~~621.20 STEEL BEAM GUARDRAIL, GALVANIZED~~
~~STA. 36+95 TO 37+07.5, LT~~

621.80 REMOVAL AND DISPOSAL OF GUARDRAIL
STA. ~~36+95~~ TO 37+45, LT
37+07

646.412 DURABLE 4 INCH YELLOW LINE, THERMOPLASTIC
STA. 36+50 TO 42+00, SOLID LT & RT

646.612 TEMPORARY 4 INCH YELLOW LINE, PAINT
STA. 36+50 TO 42+00, SOLID LT & RT

621.50 MANUFACTURED TERMINAL SECTION, FLARED
STA. 37+07.5 TO 37+45, LT

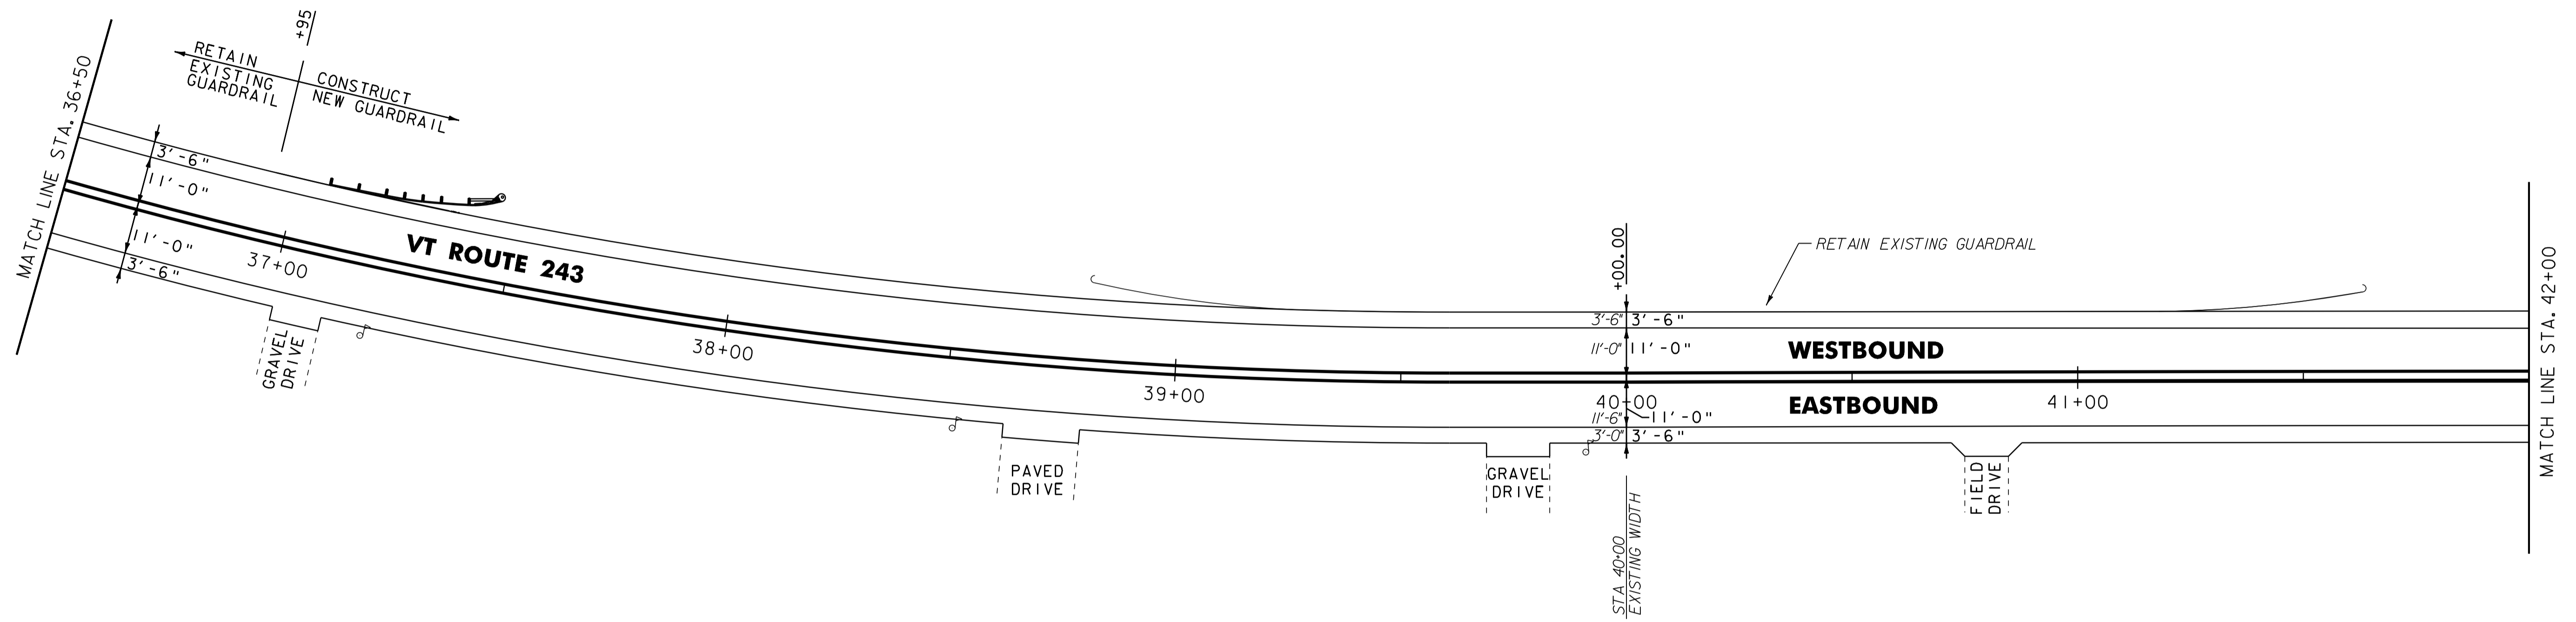

- NOTES:
1. ALL EXISTING SIGNS NOT SHOWN SHALL BE RETAINED.
2. FOR LEGENDS, SEE LAYOUT SHEET #1.

NOT TO SCALE



**PROJECT
LAYOUT
SHEET #7**

| | |
|-----------------------------|------------------------------|
| PROJECT NAME: TROY | PLOT DATE: 25-OCT-2011 14:05 |
| PROJECT NUMBER: STP 2621(I) | DRAWN BY: STANTEC |
| FILE NAME: p06c210.dgn | CHECKED BY: JLL |
| PROJECT LEADER: JLL | SHEET 114 OF 116 |
| DESIGNED BY: MCF | |
| IPARM FILE: p06c210107.i | |