


TEMPORARY 4 INCH WHITE LINE, PAINT
 DURABLE 4 INCH WHITE LINE (OPTION BID ITEM)
 L221+50 TO L227+50 SOLID LT & RT

TEMPORARY 4 INCH YELLOW LINE, PAINT
 DURABLE 4 INCH YELLOW LINE (OPTION BID ITEM)
 L221+50 TO L227+50 SOLID LT & RT

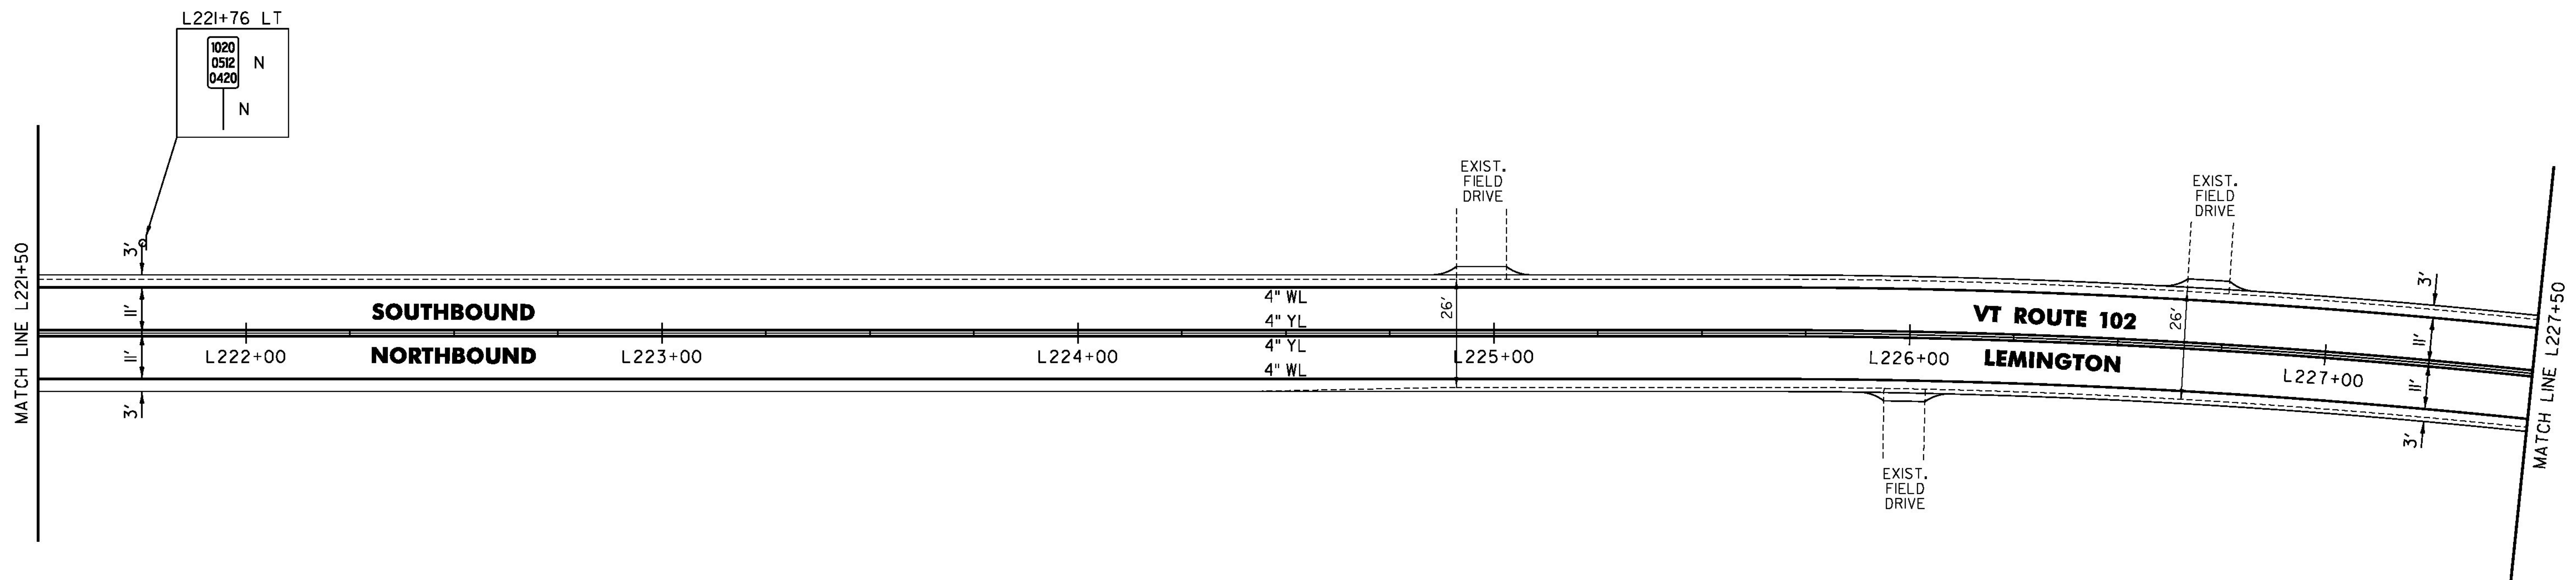

CLD 14-0197

NOT TO SCALE

| | |
|---------------------|------------------|
| PROJECT NAME: | LEMINGTON-CANAAN |
| PROJECT NUMBER: | STP 2723(I) |
| FILE NAME: | z07c2i4bdr.dgn |
| PROJECT LEADER: | P. SHEDD |
| DESIGNED BY: | N. LEMAY |
| VT 102 PLAN SHEET 6 | |
| PLOT DATE: | 2/28/2015 |
| DRAWN BY: | W. GORDON |
| CHECKED BY: | P. SHEDD |
| SHEET | 29 OF 162 |