

TEMPORARY 4 INCH WHITE LINE, PAINT  
 DURABLE 4 INCH WHITE LINE (OPTION BID ITEM)  
 L227+50 TO L233+50 SOLID LT & RT

TEMPORARY 4 INCH YELLOW LINE, PAINT  
 DURABLE 4 INCH YELLOW LINE (OPTION BID ITEM)  
 L227+50 TO L230+75 SOLID LT & RT  
 L230+75 TO L233+50 SOLID LT, DASHED RT


STEEL BEAM GUARDRAIL, GALVANIZED  
 L228+67 TO L228+92 RT  
 L229+10 TO L229+35 LT

ANCHOR FOR STEEL BEAM RAIL  
 2 (SEE STANDARD G-1d)

REMOVAL AND DISPOSAL OF GUARDRAIL  
 L228+67 TO L228+92 RT  
 L229+10 TO L229+35 LT

DELINEATOR WITH STEEL POST  
 L228+67 RT  
 L229+10 LT

REMOVING SIGNS  
 1 - AS SHOWN

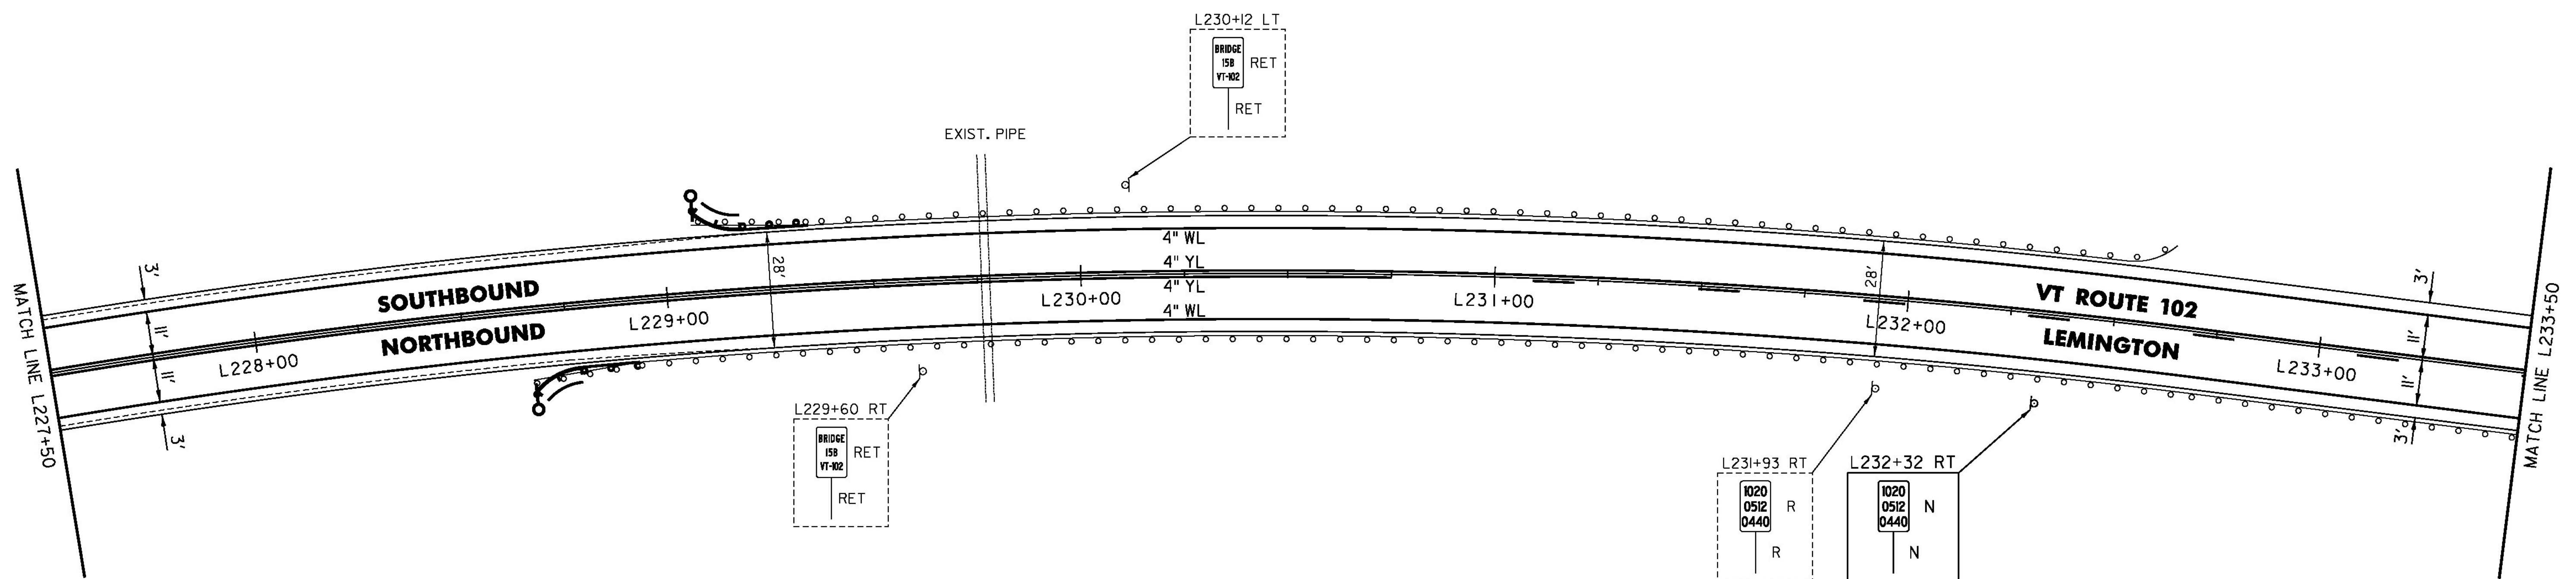

NOT TO SCALE

PROJECT NAME:	LEMINGTON-CANAAN
PROJECT NUMBER:	STP 2723(I)
FILE NAME:	z07c2i4bdr.dgn
PROJECT LEADER:	P. SHEDD
DESIGNED BY:	N. LEMAY
VT 102 PLAN SHEET 7	
PLOT DATE:	2/28/2015
DRAWN BY:	W. GORDON
CHECKED BY:	P. SHEDD
SHEET	30 OF 162

CLD 14-0197