

TEMPORARY 4 INCH WHITE LINE, PAINT
 DURABLE 4 INCH WHITE LINE (OPTION BID ITEM)
 L233+50 TO L239+50 SOLID LT & RT

TEMPORARY 4 INCH YELLOW LINE, PAINT
 DURABLE 4 INCH YELLOW LINE (OPTION BID ITEM)
 L233+50 TO L238+15 SOLID LT, DASHED RT
 L238+15 TO L239+50 DASHED CL


STEEL BEAM GUARDRAIL, GALVANIZED
 L234+67 TO L234+92 RT

ANCHOR FOR STEEL BEAM RAIL
 1 (SEE STANDARD G-1d)

REMOVAL AND DISPOSAL OF GUARDRAIL
 L234+67 TO L234+92 RT

DELINEATOR WITH STEEL POST
 L234+92 RT

REMOVING SIGNS
 1 - AS SHOWN

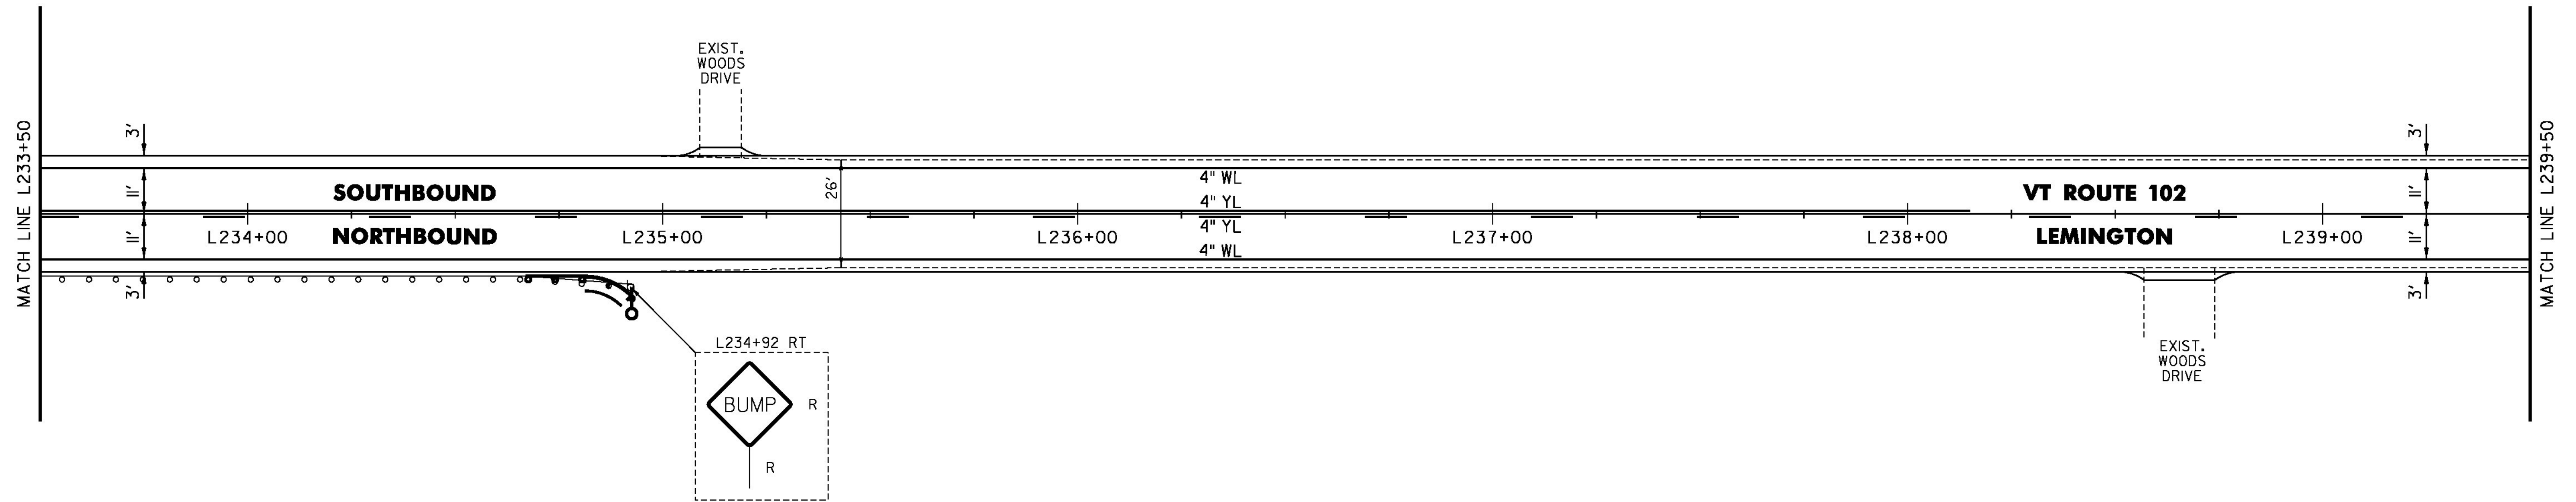

CLD 14-0197

NOT TO SCALE

PROJECT NAME:	LEMINGTON-CANAAN
PROJECT NUMBER:	STP 2723(I)
FILE NAME:	z07c214bdr.dgn
PROJECT LEADER:	P. SHEDD
DESIGNED BY:	N. LEMAY
VT 102 PLAN SHEET 8	
PLOT DATE:	2/28/2015
DRAWN BY:	W. GORDON
CHECKED BY:	P. SHEDD
SHEET	31 OF 162