

TEMPORARY 4 INCH WHITE LINE, PAINT
 DURABLE 4 INCH WHITE LINE (OPTION BID ITEM)
 L281+50 TO L287+50 SOLID LT & RT

TEMPORARY 4 INCH YELLOW LINE, PAINT
 DURABLE 4 INCH YELLOW LINE (OPTION BID ITEM)
 L281+50 TO L287+50 SOLID LT & RT


STEEL BEAM GUARDRAIL, GALVANIZED
 L284+55 TO L284+80 RT
 L287+12 TO L287+37 RT

ANCHOR FOR STEEL BEAM RAIL
 2 (SEE STANDARD G-1d)

REMOVAL AND DISPOSAL OF GUARDRAIL
 L284+55 TO L284+80 RT
 L287+12 TO L287+37 RT

DELINEATOR WITH STEEL POST
 L284+80 RT
 L287+12 RT

REMOVING SIGNS
 1 - AS SHOWN

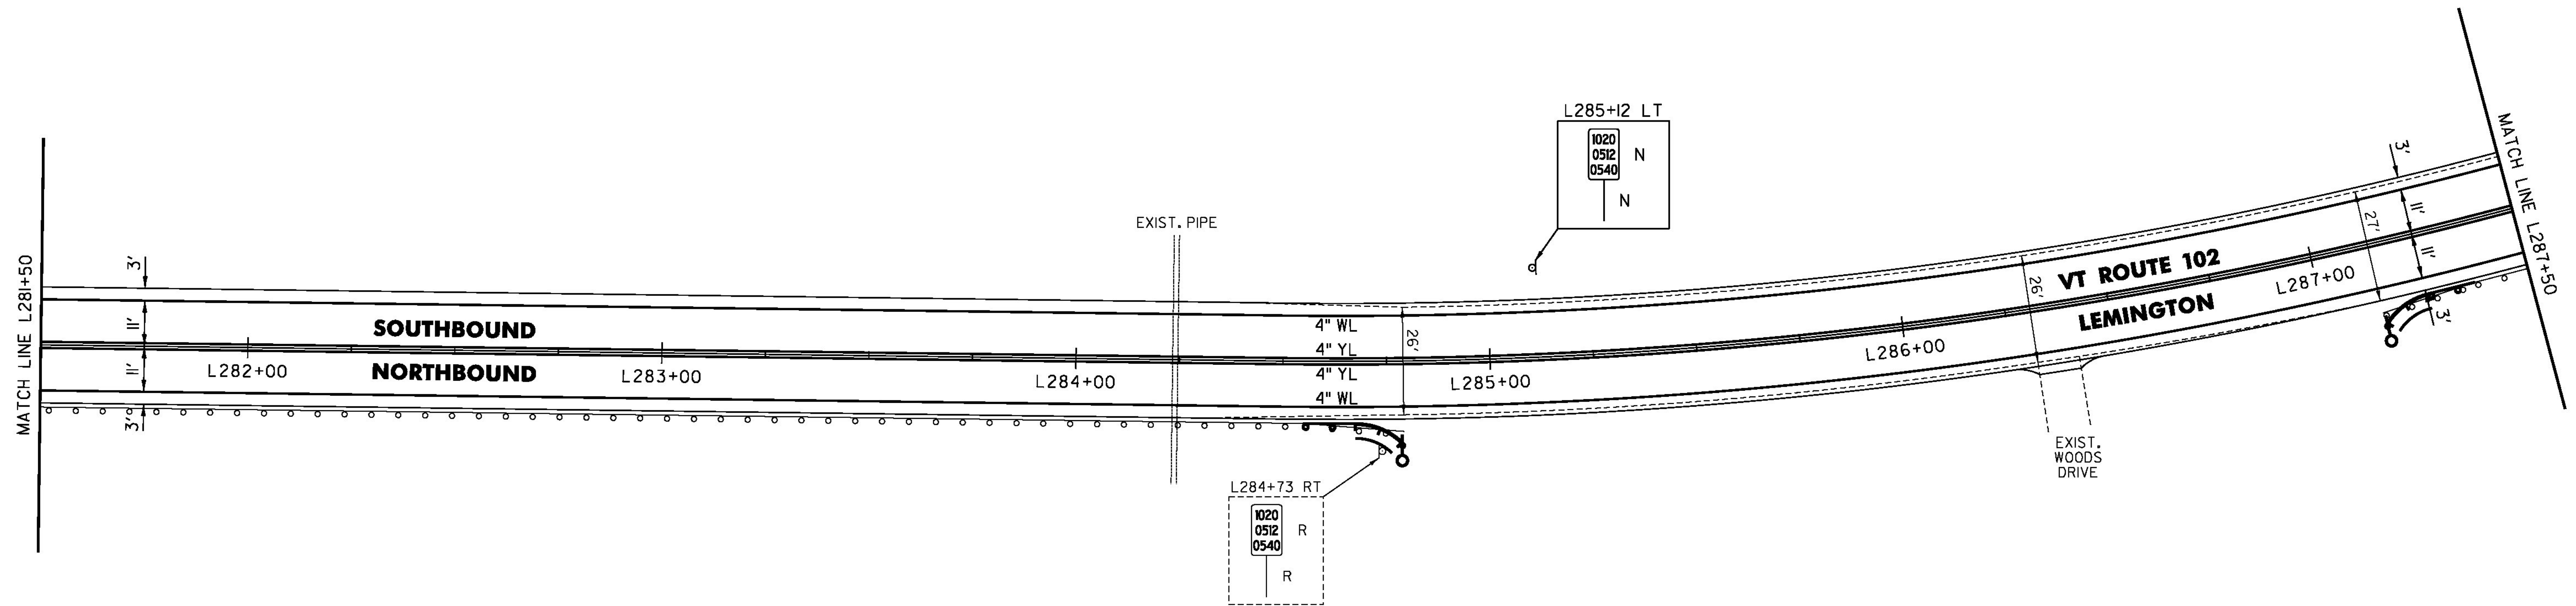

NOT TO SCALE

PROJECT NAME:	LEMINGTON-CANAAN
PROJECT NUMBER:	STP 2723(I)
FILE NAME:	z07c2i4bdr.dgn
PROJECT LEADER:	P. SHEDD
DESIGNED BY:	N. LEMAY
VT 102 PLAN SHEET 16	
PLOT DATE:	2/28/2015
DRAWN BY:	W. GORDON
CHECKED BY:	P. SHEDD
SHEET	39 OF 162

CLD 14-0197