

TEMPORARY 4 INCH WHITE LINE, PAINT
 DURABLE 4 INCH WHITE LINE (OPTION BID ITEM)
 L305+50 TO L311+50 SOLID LT & RT

TEMPORARY 4 INCH YELLOW LINE, PAINT
 DURABLE 4 INCH YELLOW LINE (OPTION BID ITEM)
 L305+50 TO L311+50 SOLID LT & RT


STEEL BEAM GUARDRAIL, GALVANIZED
 L306+22 TO L306+47 RT

REMOVE AND RESET GUARDRAIL
 L306+47 TO L311+50 RT

ANCHOR FOR STEEL BEAM RAIL
 1 (SEE STANDARD G-1d)

REMOVAL AND DISPOSAL OF GUARDRAIL
 L306+22 TO L306+47 RT

DELINEATOR WITH STEEL POST
 L306+22 RT

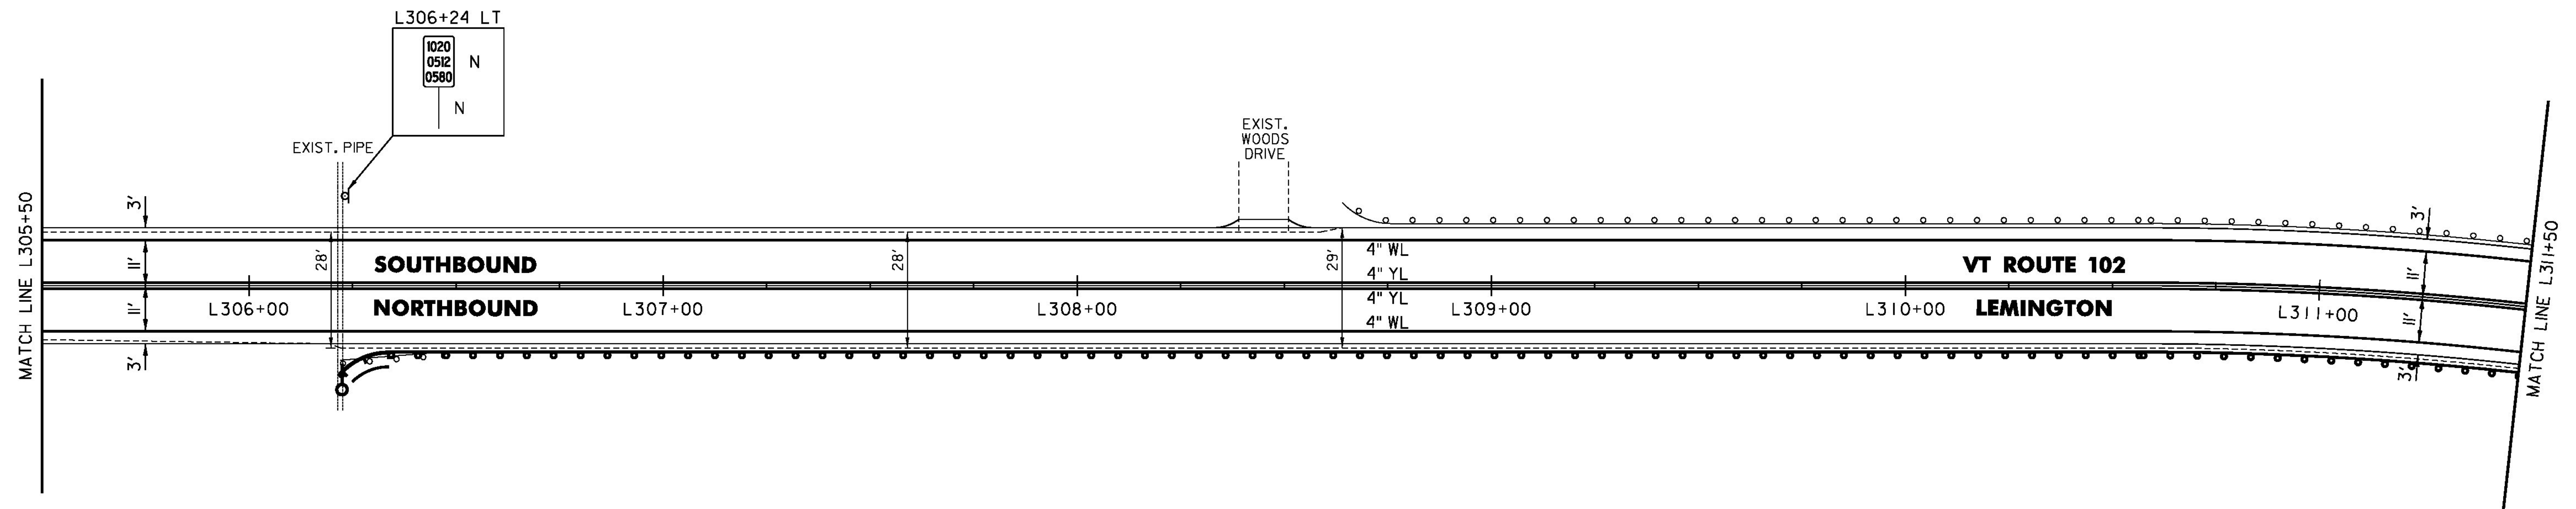

PROJECT NAME:	LEMINGTON-CANAAN
PROJECT NUMBER:	STP 2723(I)
FILE NAME:	z07c214bdr.dgn
PROJECT LEADER:	P. SHEDD
DESIGNED BY:	N. LEMAY
VT 102 PLAN SHEET 20	
PLOT DATE:	2/28/2015
DRAWN BY:	W. GORDON
CHECKED BY:	P. SHEDD
SHEET	43 OF 162

NOT TO SCALE

CLD 14-0197