

TEMPORARY 4 INCH WHITE LINE, PAINT  
 DURABLE 4 INCH WHITE LINE (OPTION BID ITEM)  
 L329+50 TO L335+50 SOLID LT  
 L329+50 TO L331+92 SOLID RT  
 L331+92 TO L332+37 SOLID RT (VT ROUTE 26)  
 L332+61 TO L333+00 SOLID RT (VT ROUTE 26)  
 L333+00 TO L335+50 SOLID RT

TEMPORARY 24 INCH STOP BAR, PAINT  
 DURABLE 24 INCH STOP BAR (OPTION BID ITEM)  
 L332+41 TO L332+78 RT (VT ROUTE 26)

STEEL BEAM GUARDRAIL, GALVANIZED  
 L331+70 TO L332+26 RT  
 L332+68 TO L335+50 RT  
 ANCHOR FOR STEEL BEAM RAIL  
 1 (SEE STANDARD G-1d)

REMOVAL AND DISPOSAL OF GUARDRAIL  
 L331+73 TO L332+26 RT  
 L332+68 TO L335+50 RT  
 DELINEATOR WITH STEEL POST  
 L331+70 RT


ERECTING SALVAGED SIGNS  
 4 - AS SHOWN

REMOVING SIGNS  
 42 - AS SHOWN

THINNING AND TRIMMING FOR SIGNS  
 L332+58 LT

TEMPORARY 4 INCH YELLOW LINE, PAINT  
 DURABLE 4 INCH YELLOW LINE (OPTION BID ITEM)  
 L329+50 TO L332+20 SOLID LT & RT  
 L332+40 TO L332+50 DOUBLE SOLID RT (VT ROUTE 26)  
 L332+60 TO L335+50 SOLID LT & RT

TEMPORARY LETTER OR SYMBOL, PAINT  
 DURABLE LETTER OR SYMBOL (OPTION BID ITEM)  
 L332+49 RT "STOP" (VT ROUTE 26)

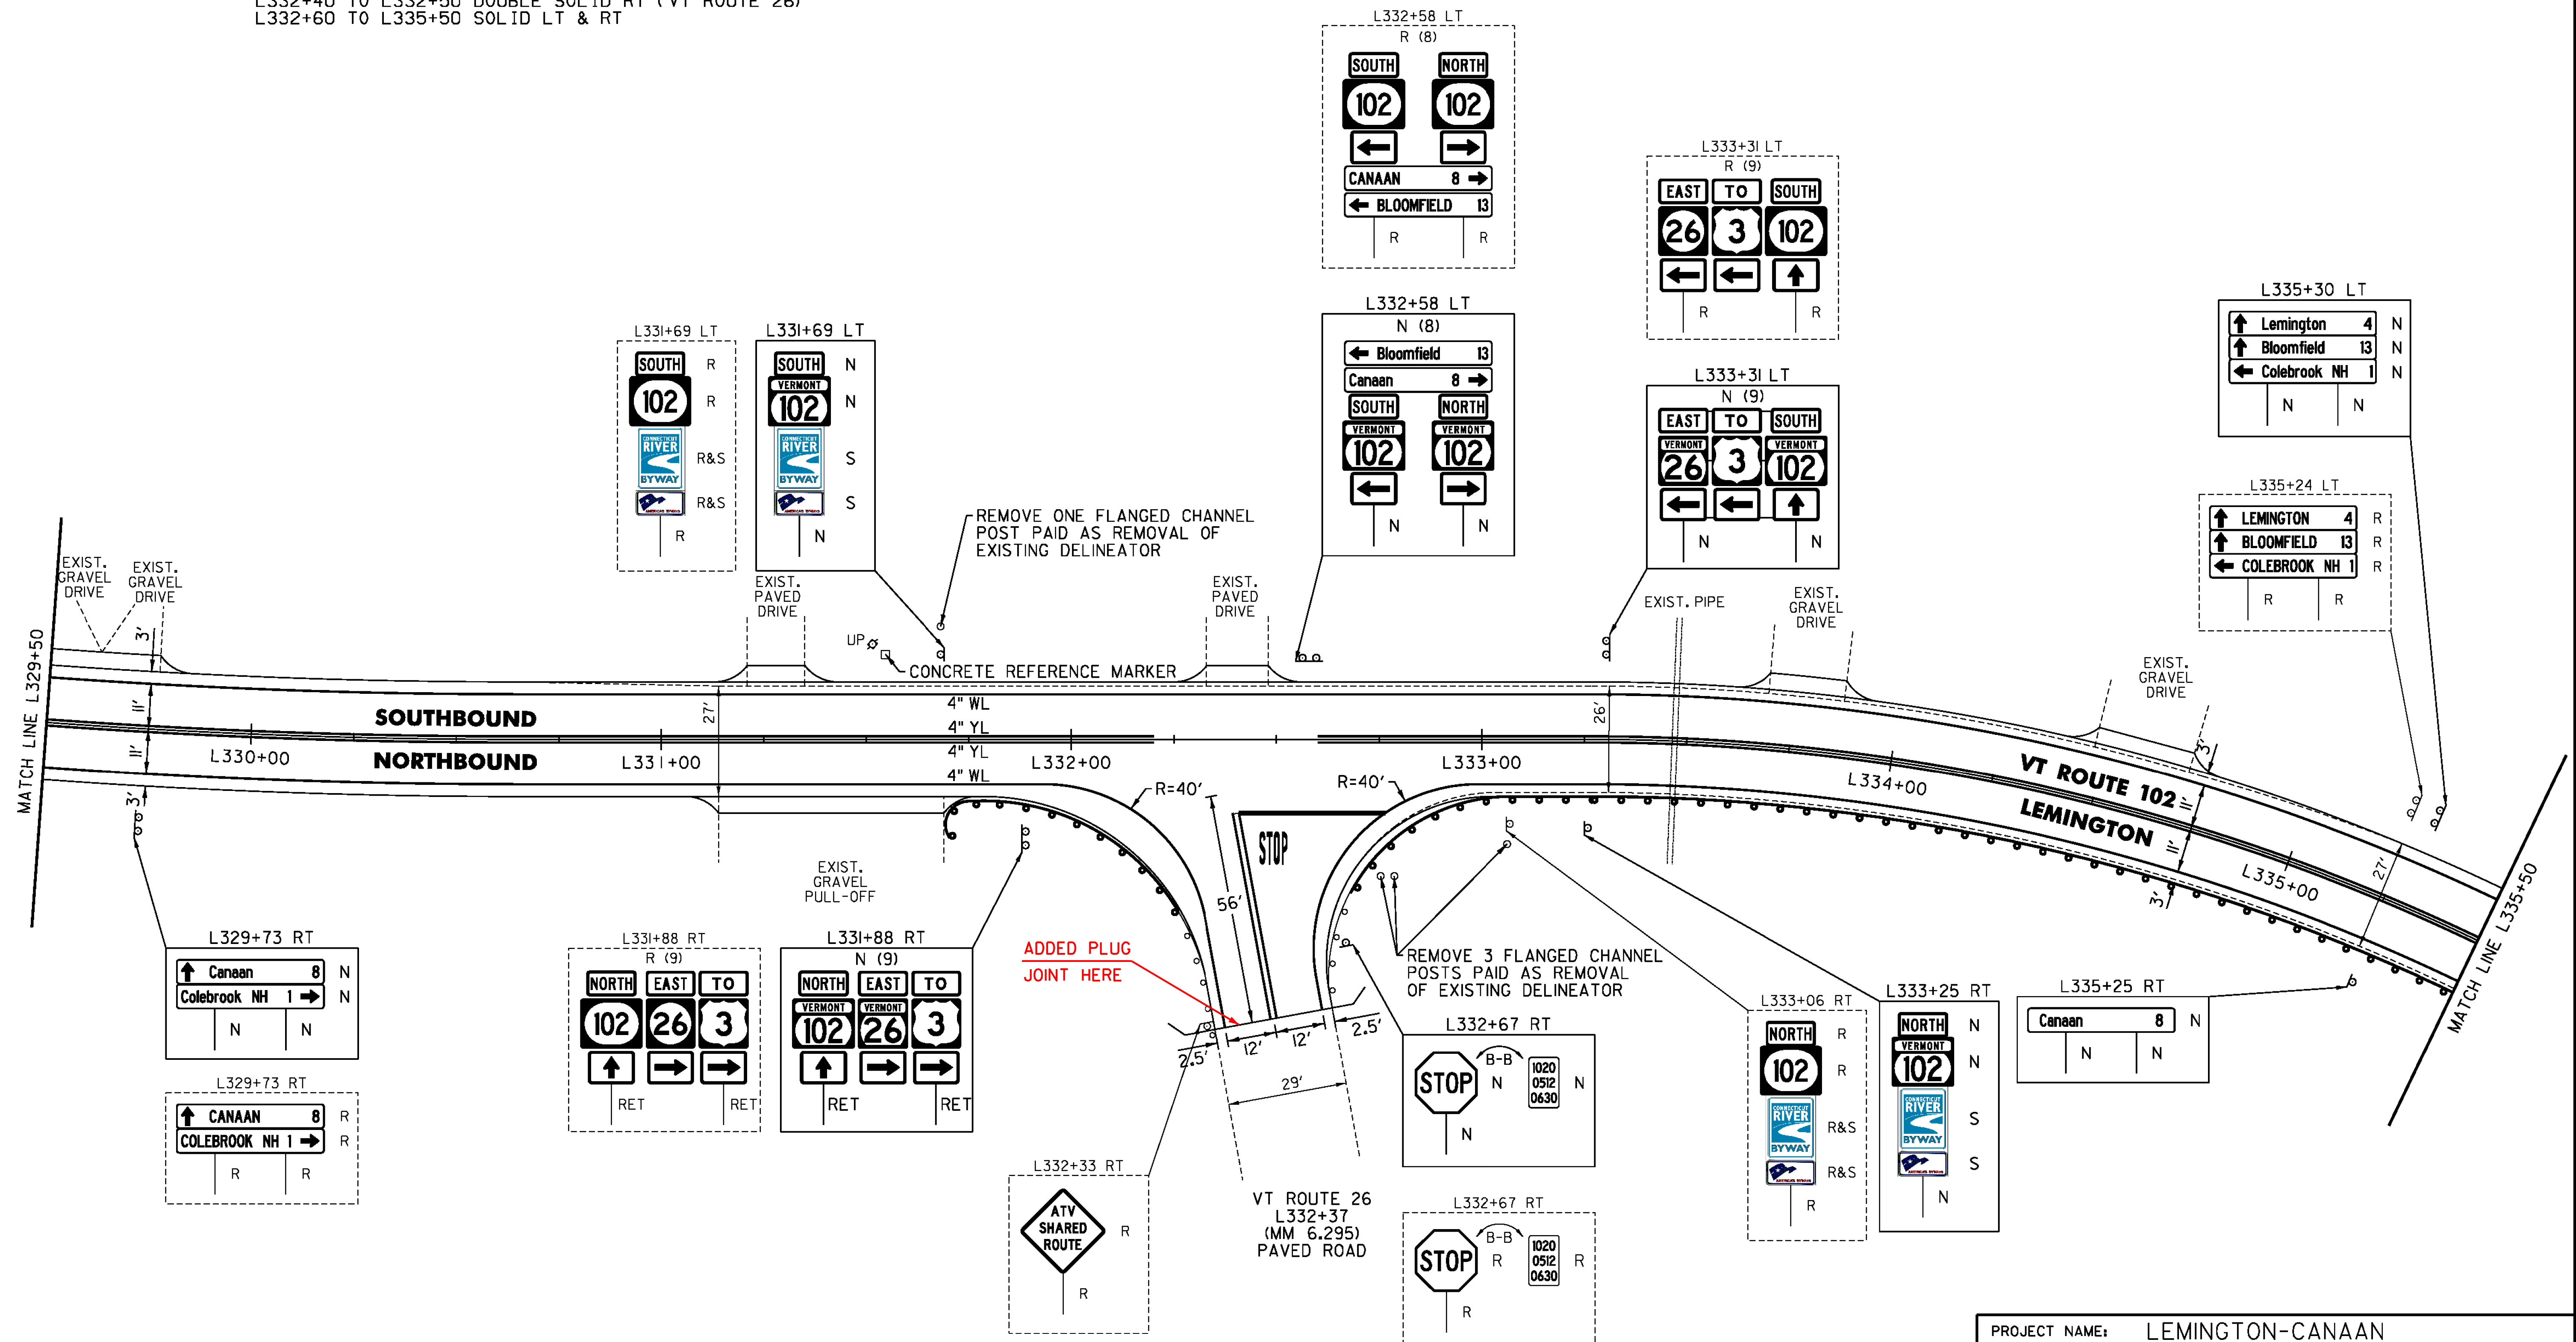

NOT TO SCALE

PROJECT NAME:	LEMINGTON-CANAAN
PROJECT NUMBER:	STP 2723(I)
FILE NAME:	z07c214bdr.dgn
PROJECT LEADER:	P. SHEDD
DESIGNED BY:	N. LEMAY
VT 102 PLAN SHEET 24	
PLOT DATE:	2/28/2015
DRAWN BY:	W. GORDON
CHECKED BY:	P. SHEDD
SHEET	47 OF 162