


TEMPORARY 4 INCH WHITE LINE, PAINT
 DURABLE 4 INCH WHITE LINE (OPTION BID ITEM)
 68+50 TO 74+50 SOLID RT
 68+50 TO 72+65 SOLID LT
 72+65 TO 72+97 SOLID LT (TH 20)
 73+19 TO 73+47 SOLID LT (TH 20)
 73+47 TO 74+50 SOLID LT

TEMPORARY 4 INCH YELLOW LINE, PAINT
 DURABLE 4 INCH YELLOW LINE (OPTION BID ITEM)
 68+50 TO 72+84 SOLID LT & RT
 73+04 TO 73+08 DOUBLE SOLID LT (TH 20)
 73+24 TO 74+50 SOLID LT & RT

TEMPORARY 24 INCH STOP BAR, PAINT
 DURABLE 24 INCH STOP BAR (OPTION BID ITEM)
 72+84 TO 73+04 LT

TEMPORARY LETTER OR SYMBOL, PAINT
 DURABLE LETTER OR SYMBOL (OPTION BID ITEM)
 72+98 LT *STOP* (TH 20)

REMOVING SIGNS
 5 - AS SHOWN

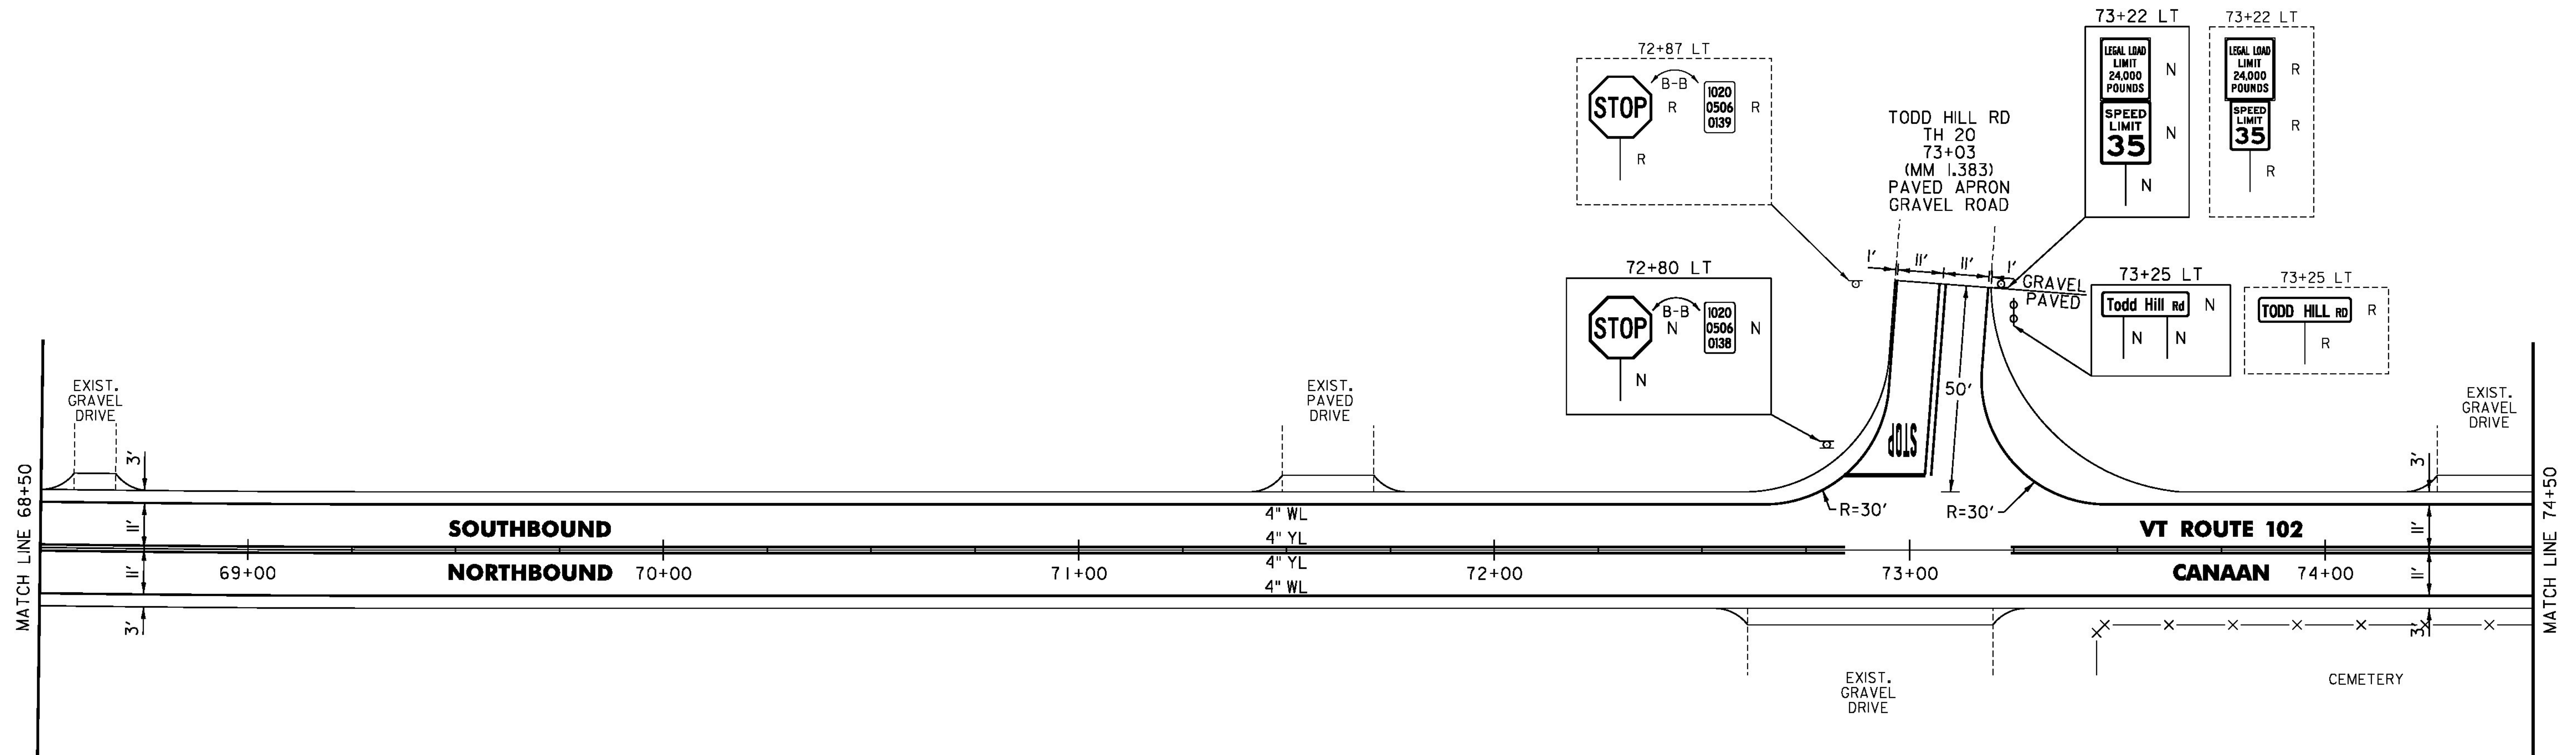

CLD 14-0197

NOT TO SCALE

PROJECT NAME:	LEMINGTON-CANAAN
PROJECT NUMBER:	STP 2723(I)
FILE NAME:	z07c214bdr.dgn
PROJECT LEADER:	P. SHEDD
DESIGNED BY:	N. LEMAY
VT 102 PLAN SHEET 45	
PLOT DATE:	2/28/2015
DRAWN BY:	W. GORDON
CHECKED BY:	P. SHEDD
SHEET	68 OF 162