


TEMPORARY 4 INCH WHITE LINE, PAINT  
 DURABLE 4 INCH WHITE LINE (OPTION BID ITEM)  
 104+50 TO 110+50 SOLID LT & RT

TEMPORARY 4 INCH YELLOW LINE, PAINT  
 DURABLE 4 INCH YELLOW LINE (OPTION BID ITEM)  
 104+50 TO 110+50 SOLID LT & RT

REMOVE AND RESET GUARDRAIL  
 108+08 TO 110+50 LT

ERECTING SALVAGED SIGNS  
 1 - AS SHOWN

REMOVING SIGNS  
 1 - AS SHOWN

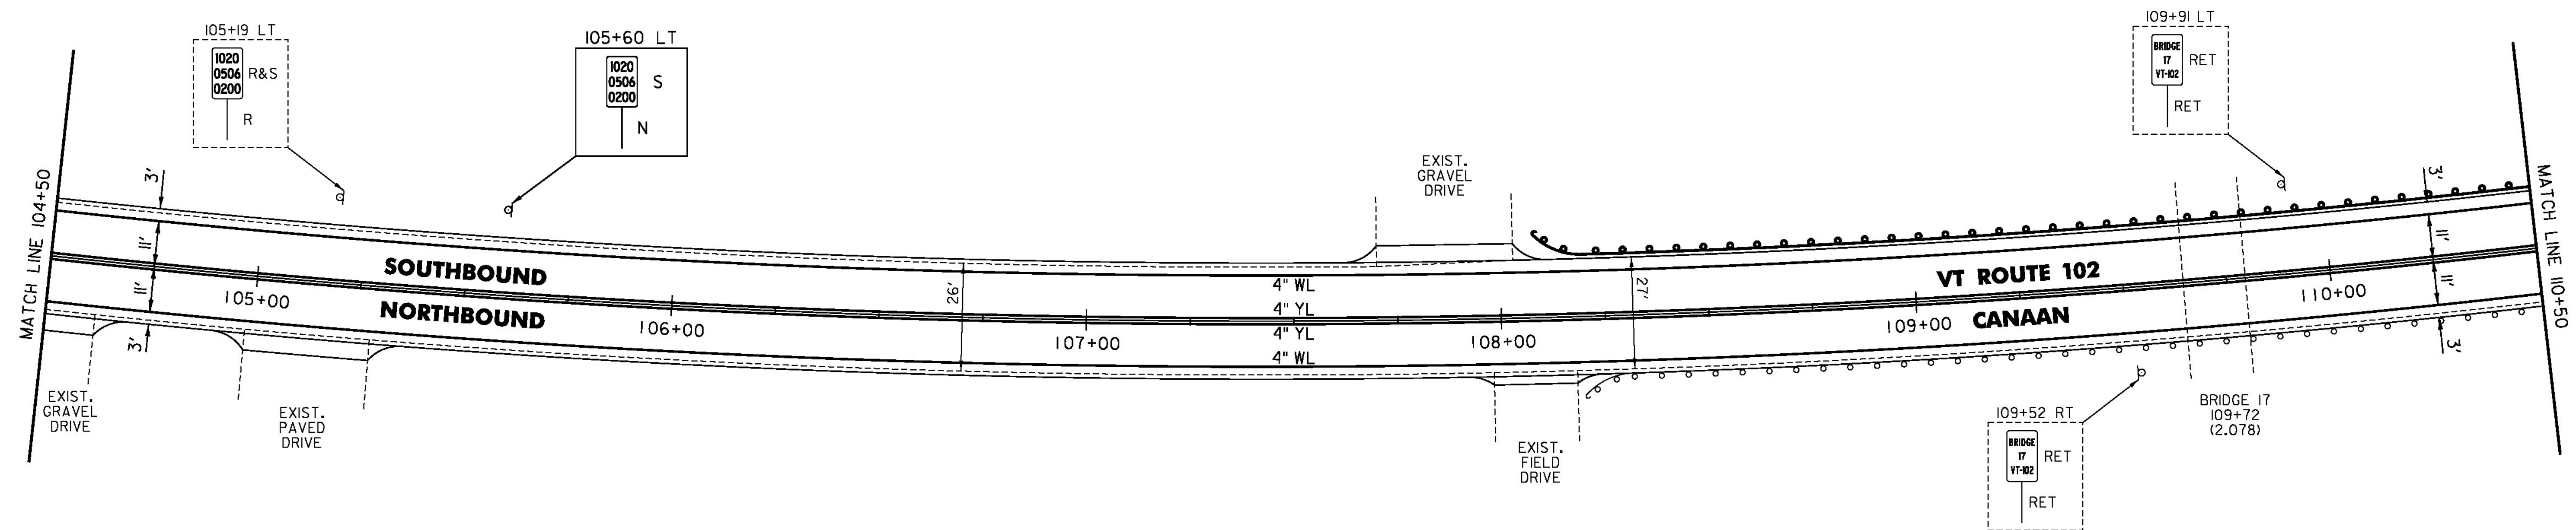

PROJECT NAME:	LEMINGTON-CANAAN
PROJECT NUMBER:	STP 2723(I)
FILE NAME:	z07c2i4bdr.dgn
PROJECT LEADER:	P. SHEDD
DESIGNED BY:	N. LEMAY
VT 102 PLAN SHEET 51	
PLOT DATE:	2/28/2015
DRAWN BY:	W. GORDON
CHECKED BY:	P. SHEDD
SHEET	74 OF 162

NOT TO SCALE

CLD 14-0197