


TEMPORARY 4 INCH WHITE LINE, PAINT
 DURABLE 4 INCH WHITE LINE (OPTION BID ITEM)
 235+50 TO 241+50 SOLID LT & RT

TEMPORARY 4 INCH YELLOW LINE, PAINT
 DURABLE 4 INCH YELLOW LINE (OPTION BID ITEM)
 235+50 TO 241+50 SOLID LT & RT

STEEL BEAM GUARDRAIL, GALVANIZED
 235+50 TO 236+37 RT
 239+24.5 TO 241+50 RT
 STEEL BEAM GUARDRAIL,
 GALVANIZED W/8 FEET POSTS
 236+37 TO 239+24.5 RT

REMOVAL AND DISPOSAL OF GUARDRAIL
 235+50 TO 241+50 RT

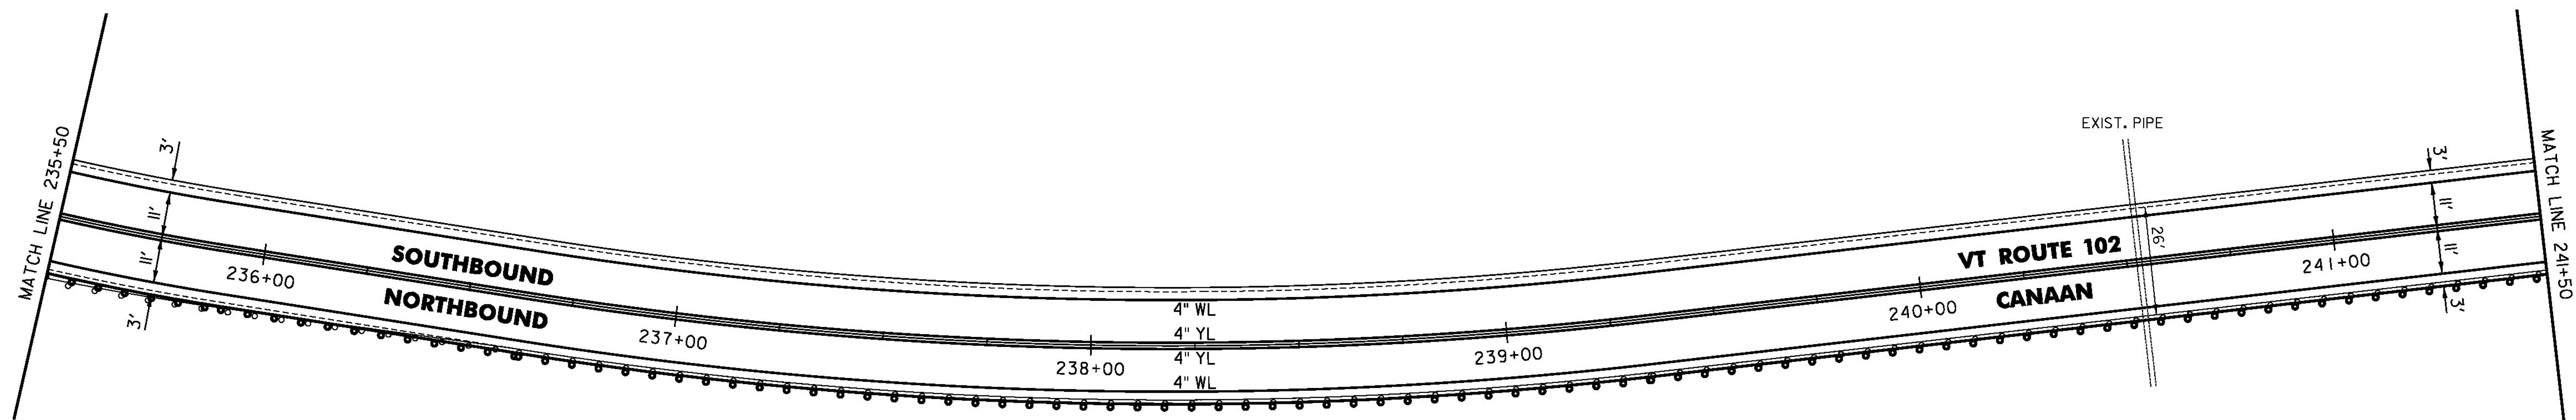

NOT TO SCALE

PROJECT NAME:	LEMINGTON-CANAAN
PROJECT NUMBER:	STP 2723(I)
FILE NAME:	z07c214bdr.dgn
PROJECT LEADER:	P. SHEDD
DESIGNED BY:	N. LEMAY
VT 102 PLAN SHEET 73	
PLOT DATE:	2/28/2015
DRAWN BY:	W. GORDON
CHECKED BY:	P. SHEDD
SHEET	96 OF 162

CLD 14-0197