

TEMPORARY 4 INCH WHITE LINE, PAINT
 DURABLE 4 INCH WHITE LINE (OPTION BID ITEM)
 247+50 TO 253+50 SOLID LT & RT

TEMPORARY 4 INCH YELLOW LINE, PAINT
 DURABLE 4 INCH YELLOW LINE (OPTION BID ITEM)
 247+50 TO 253+50 SOLID LT & RT


STEEL BEAM GUARDRAIL, GALVANIZED
 247+87 TO 248+12 RT

STEEL BEAM GUARDRAIL,
 GALVANIZED W/8 FEET POSTS
 247+50 TO 247+87 RT

ANCHOR FOR STEEL BEAM RAIL
 1' (SEE STANDARD G-1d)

REMOVAL AND DISPOSAL OF GUARDRAIL
 247+50 TO 248+12 RT

DELINEATOR WITH STEEL POST
 248+12 RT

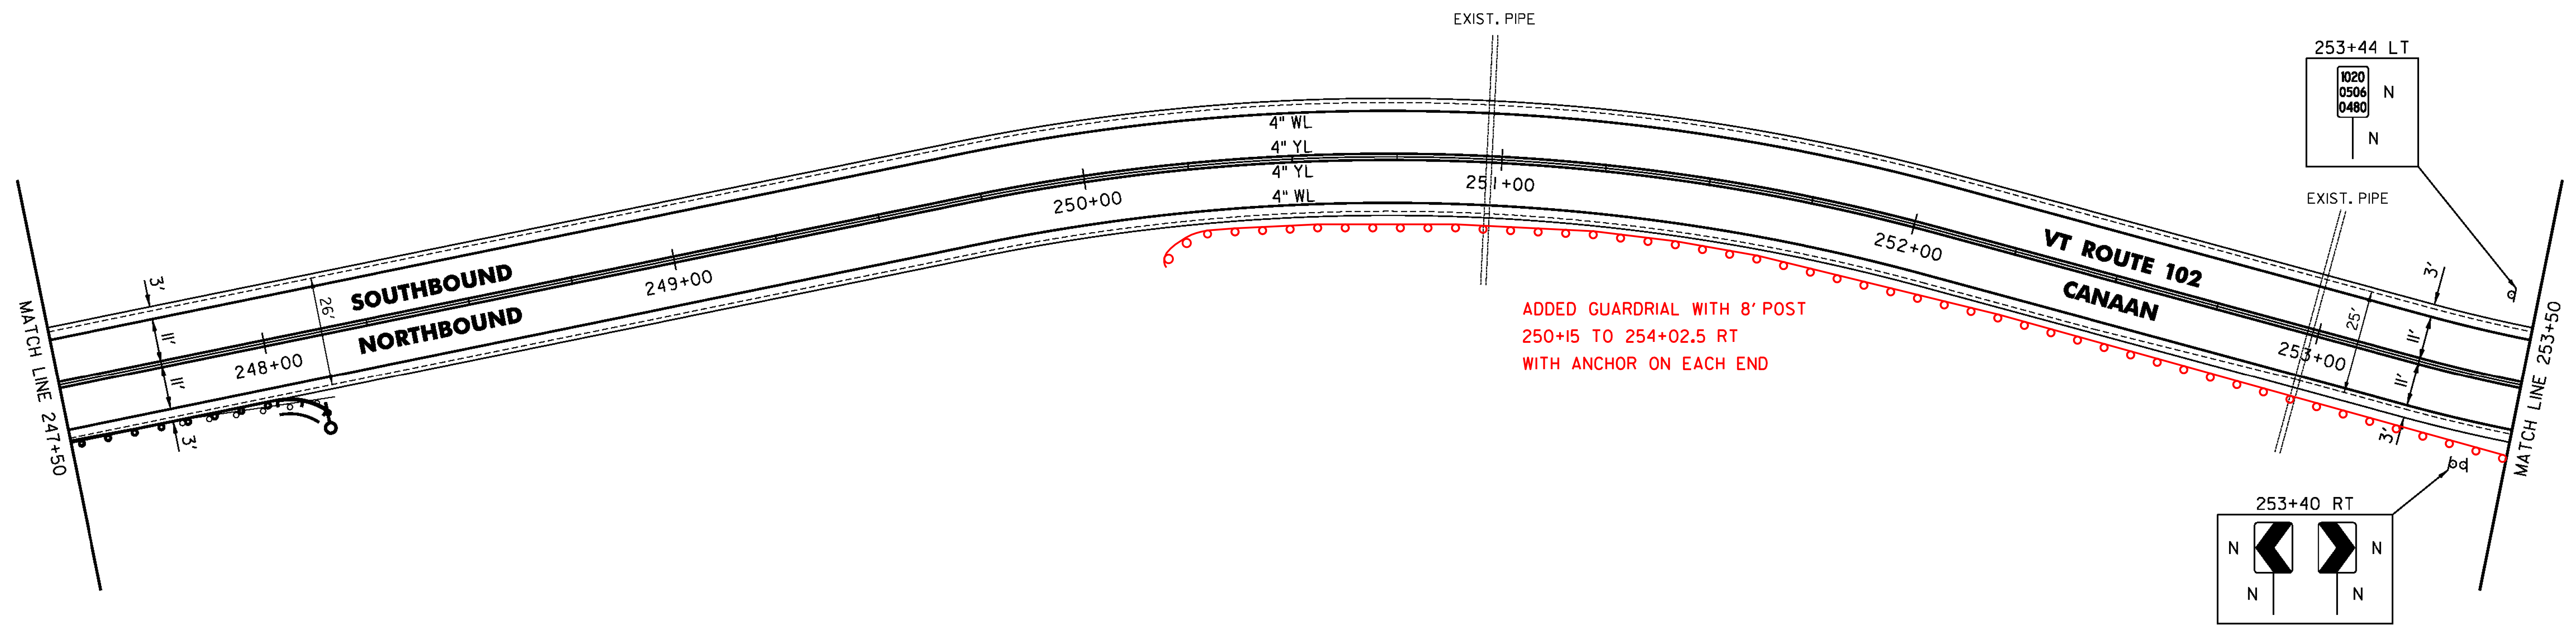

NOT TO SCALE

PROJECT NAME:	LEMINGTON-CANAAN	PLOT DATE:	2/28/2015
PROJECT NUMBER:	STP 2723(I)	DRAWN BY:	W. GORDON
FILE NAME:	z07c214bdr.dgn	CHECKED BY:	P. SHEDD
PROJECT LEADER:	P. SHEDD	SHEET	98 OF 162
DESIGNED BY:	N. LEMAY		
VT 102 PLAN SHEET	75		