


TEMPORARY 4 INCH WHITE LINE, PAINT
 DURABLE 4 INCH WHITE LINE (OPTION BID ITEM)
 253+50 TO 259+50 SOLID LT & RT

REMOVING SIGNS
 5 - AS SHOWN

TEMPORARY 4 INCH YELLOW LINE, PAINT
 DURABLE 4 INCH YELLOW LINE (OPTION BID ITEM)
 253+50 TO 259+50 SOLID LT & RT

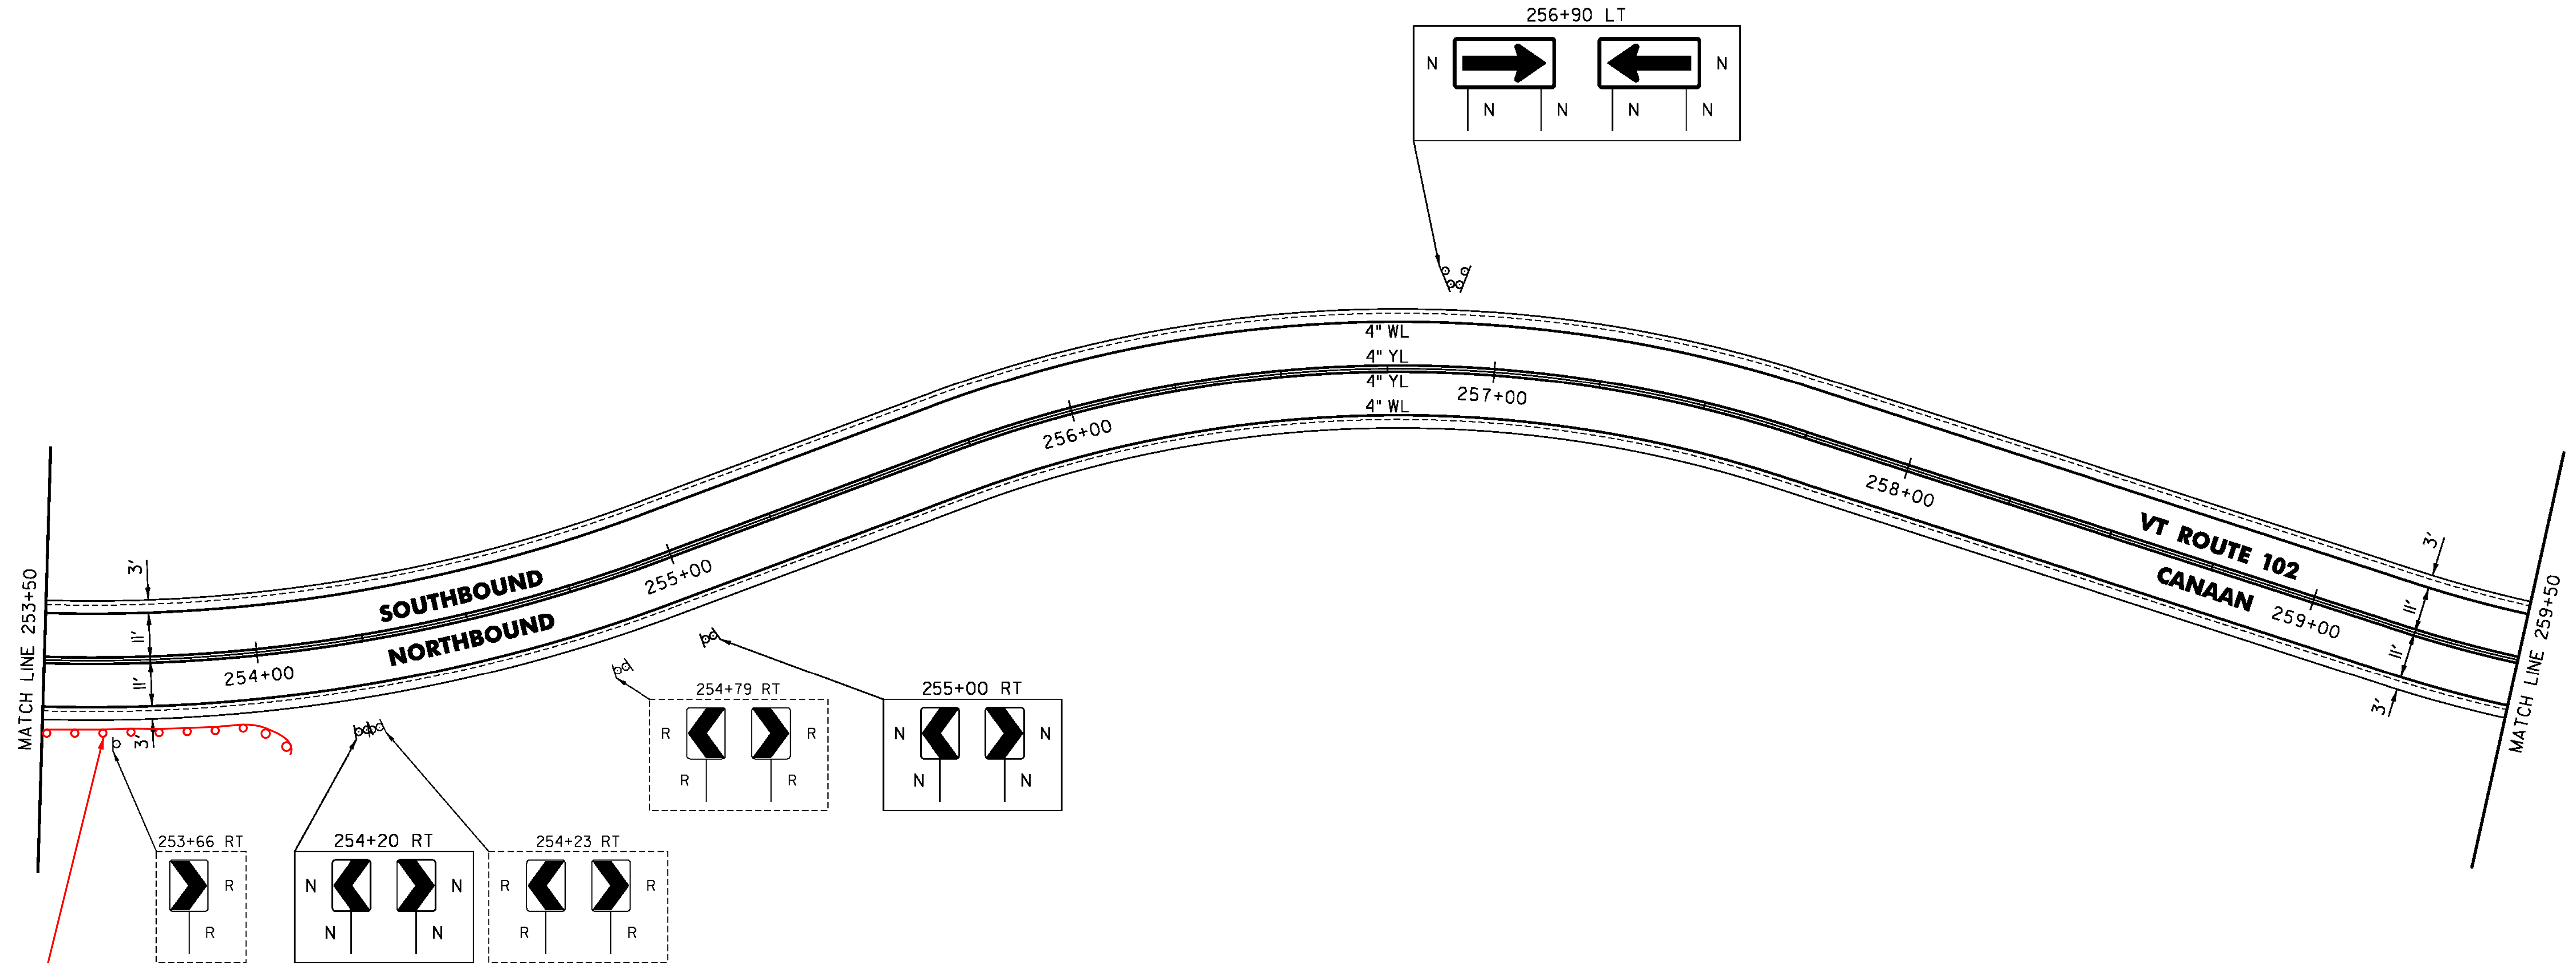

ADDED GUARDRIAL WITH 8' POST
 250+15 TO 254+02.5 RT
 WITH ANCHOR ON EACH END

NOT TO SCALE

PROJECT NAME:	LEMINGTON-CANAAN	PLOT DATE:	2/28/2015
PROJECT NUMBER:	STP 2723(I)	DRAWN BY:	W. GORDON
FILE NAME:	z07c214bdr.dgn	DESIGNED BY:	N. LEMAY
PROJECT LEADER:	P. SHEDD	CHECKED BY:	P. SHEDD
VT 102 PLAN SHEET 76		SHEET	99 OF 162

CLD 14-0197