

TEMPORARY 4 INCH WHITE LINE, PAINT  
 DURABLE 4 INCH WHITE LINE (OPTION BID ITEM)  
 271+50 TO 277+50 SOLID LT & RT

TEMPORARY 4 INCH YELLOW LINE, PAINT  
 DURABLE 4 INCH YELLOW LINE (OPTION BID ITEM)  
 271+50 TO 277+50 SOLID LT & RT


STEEL BEAM GUARDRAIL, GALVANIZED  
 274+08 TO 277+20.5 RT  
 275+90 TO 277+40 LT

ANCHOR FOR STEEL BEAM RAIL  
 4 (SEE STANDARD G-1d)

REMOVAL AND DISPOSAL OF GUARDRAIL  
 274+08 TO 276+83 RT  
 276+15 TO 276+90 LT

REMOVING SIGNS  
 2 - AS SHOWN

DELINEATOR WITH STEEL POST  
 274+08 RT  
 275+90 LT  
 277+20.5 RT  
 277+40 LT

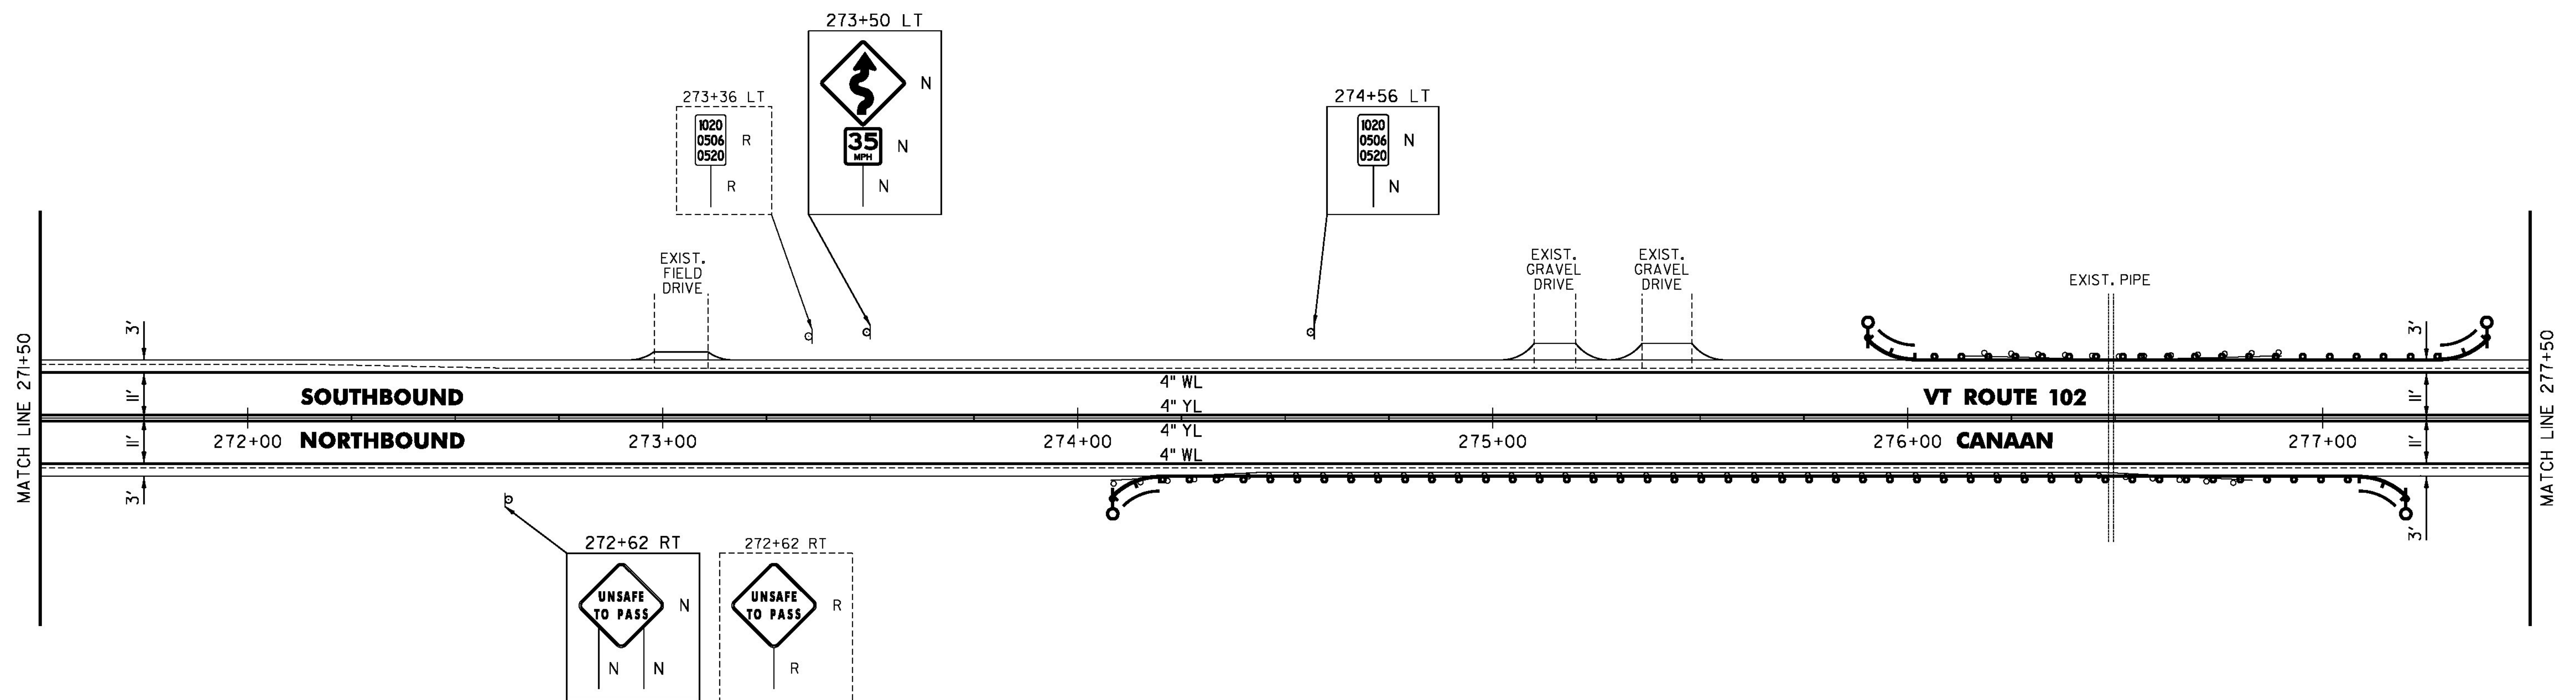

CLD 14-0197

NOT TO SCALE

PROJECT NAME:	LEMINGTON-CANAAN
PROJECT NUMBER:	STP 2723(I)
FILE NAME:	z07c214bdr.dgn
PROJECT LEADER:	P. SHEDD
DESIGNED BY:	N. LEMAY
VT 102 PLAN SHEET 79	
PLOT DATE:	2/28/2015
DRAWN BY:	W. GORDON
CHECKED BY:	P. SHEDD
SHEET	102 OF 162