

TEMPORARY 4 INCH WHITE LINE, PAINT  
 DURABLE 4 INCH WHITE LINE (OPTION BID ITEM)  
 353+50 TO 356+22 SOLID RT  
 353+50 TO 356+52 SOLID LT  
 356+62 TO 356+71 SOLID LT (TH 24)  
 356+67 TO 358+75 SOLID RT  
 356+94 TO 357+12 SOLID LT (TH 24)  
 357+12 TO 358+75 SOLID LT

TEMPORARY 4 INCH YELLOW LINE, PAINT  
 DURABLE 4 INCH YELLOW LINE (OPTION BID ITEM)  
 353+50 TO 356+22 SOLID LT & RT  
 356+80 DOUBLE SOLID LT (TH 24)  
 357+00 TO 358+75 SOLID LT & RT

TEMPORARY 24 INCH STOP BAR, PAINT  
 DURABLE 24 INCH STOP BAR (OPTION BID ITEM)  
 356+64 TO 356+77 LT (TH 24)

TEMPORARY LETTER OR SYMBOL, PAINT  
 DURABLE LETTER OR SYMBOL (OPTION BID ITEM)  
 356+75 LT "STOP" (TH 24)  
 258+52 LT "SCHOOL"

TEMPORARY CROSSWALK MARKING, PAINT  
 DURABLE CROSSWALK MARKING (OPTION BID ITEM)  
 356+56 TO 356+62 LT TO RT

PAINTED CURB  
 356+59 TO 356+67 LT (ENTIRE ISLAND)


CHANGING ELEVATION  
 OF SEWER MANHOLES (NON-PART)  
 356+60 LT

VERTICAL GRANITE CURB  
 356+59 TO 356+67 LT

PORTLAND CEMENT  
 CONCRETE SIDEWALK, 5 INCH  
 356+59 TO 356+66 LT


ERECTING SALVAGED SIGNS  
 2 - AS SHOWN

REMOVING SIGNS  
 27 - AS SHOWN

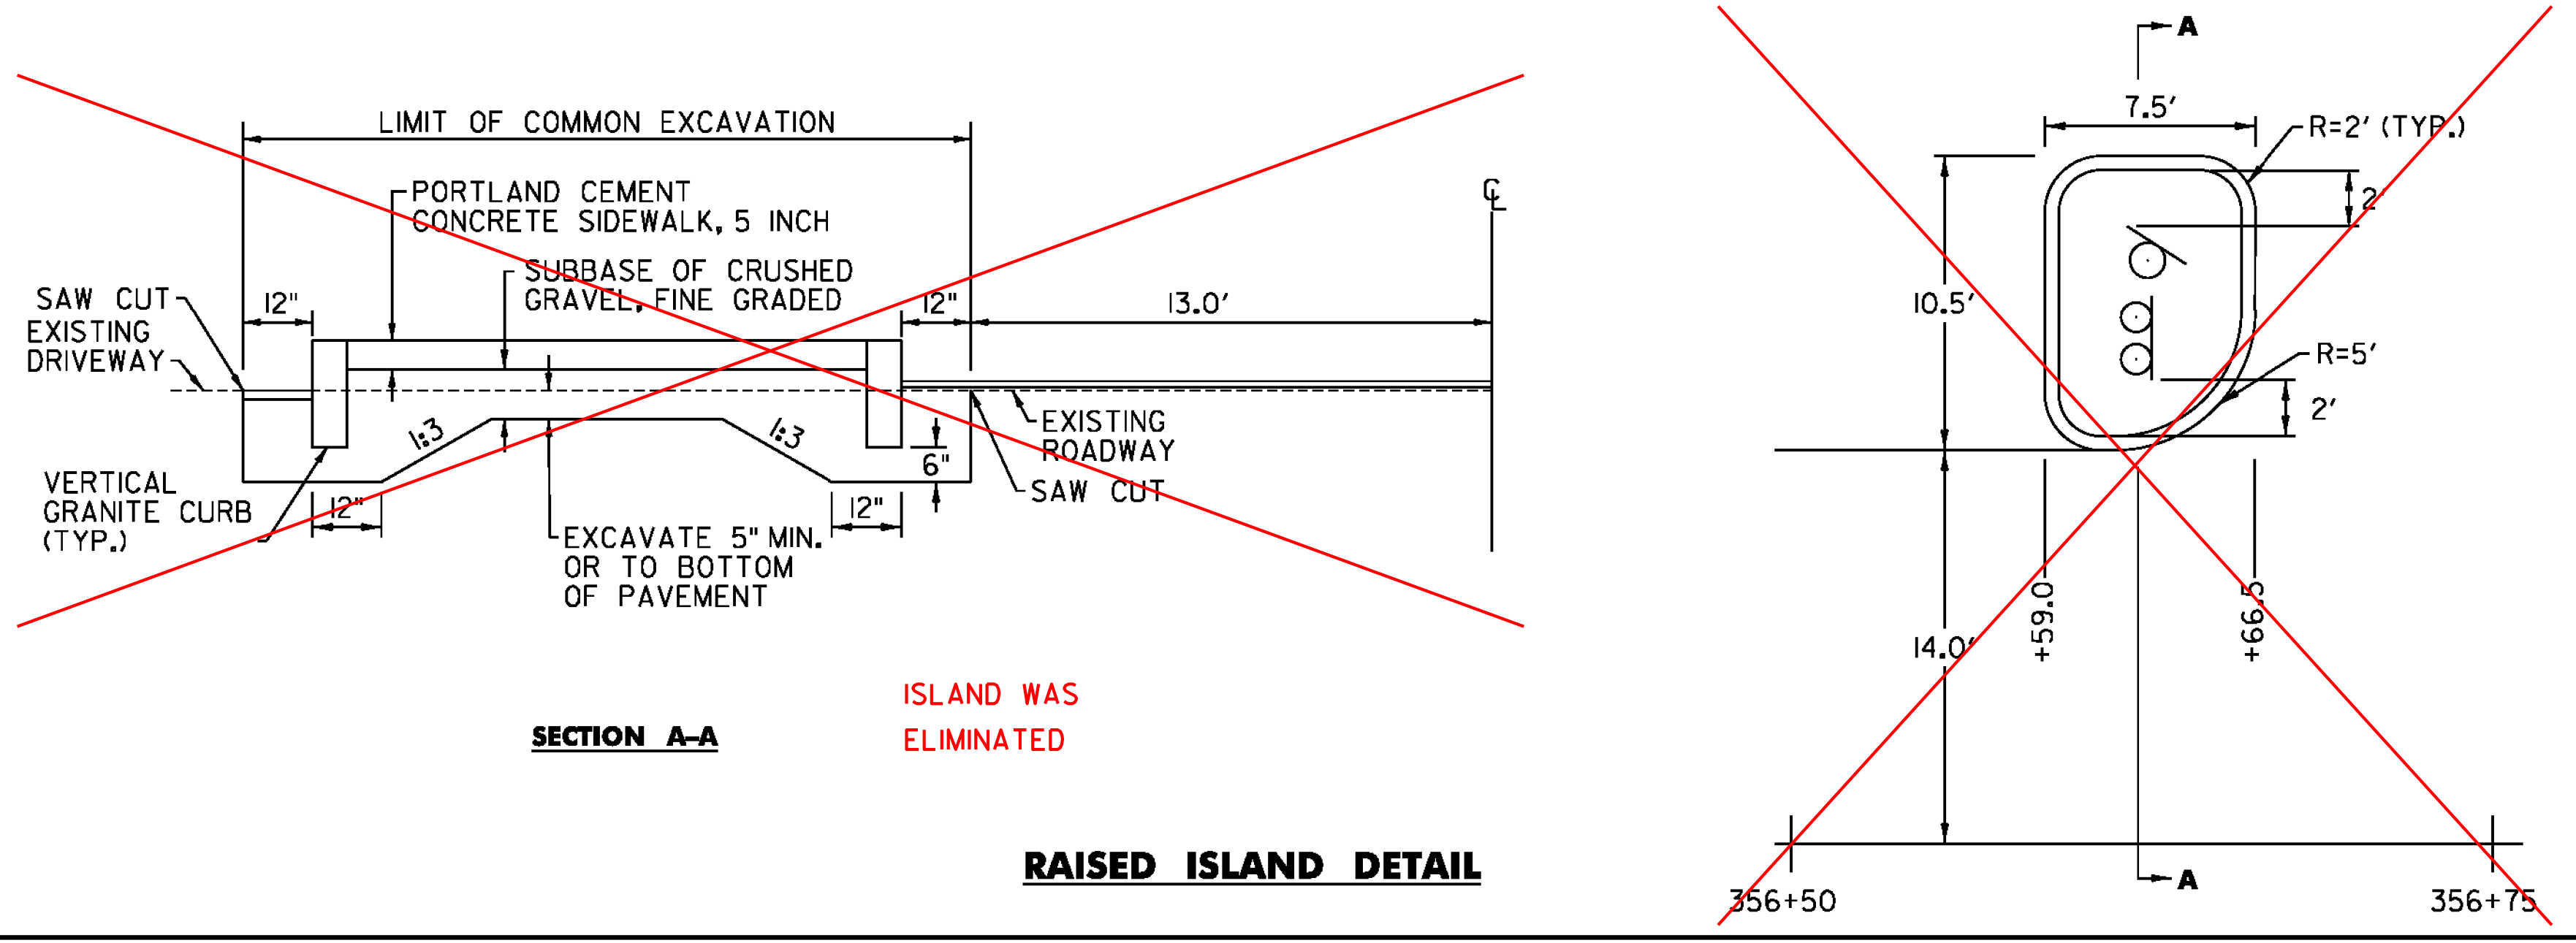

THIS SIGN RETAINED  
 356+99 LT

ISLAND WAS ELIMINATED AND CROSSWALK  
 RELOCATED. THE TOWN DID NOT WANT THIS  
 ISLAND. TH PAVEMENT MARKINGS WERE  
 ELIMINATED ALSO.

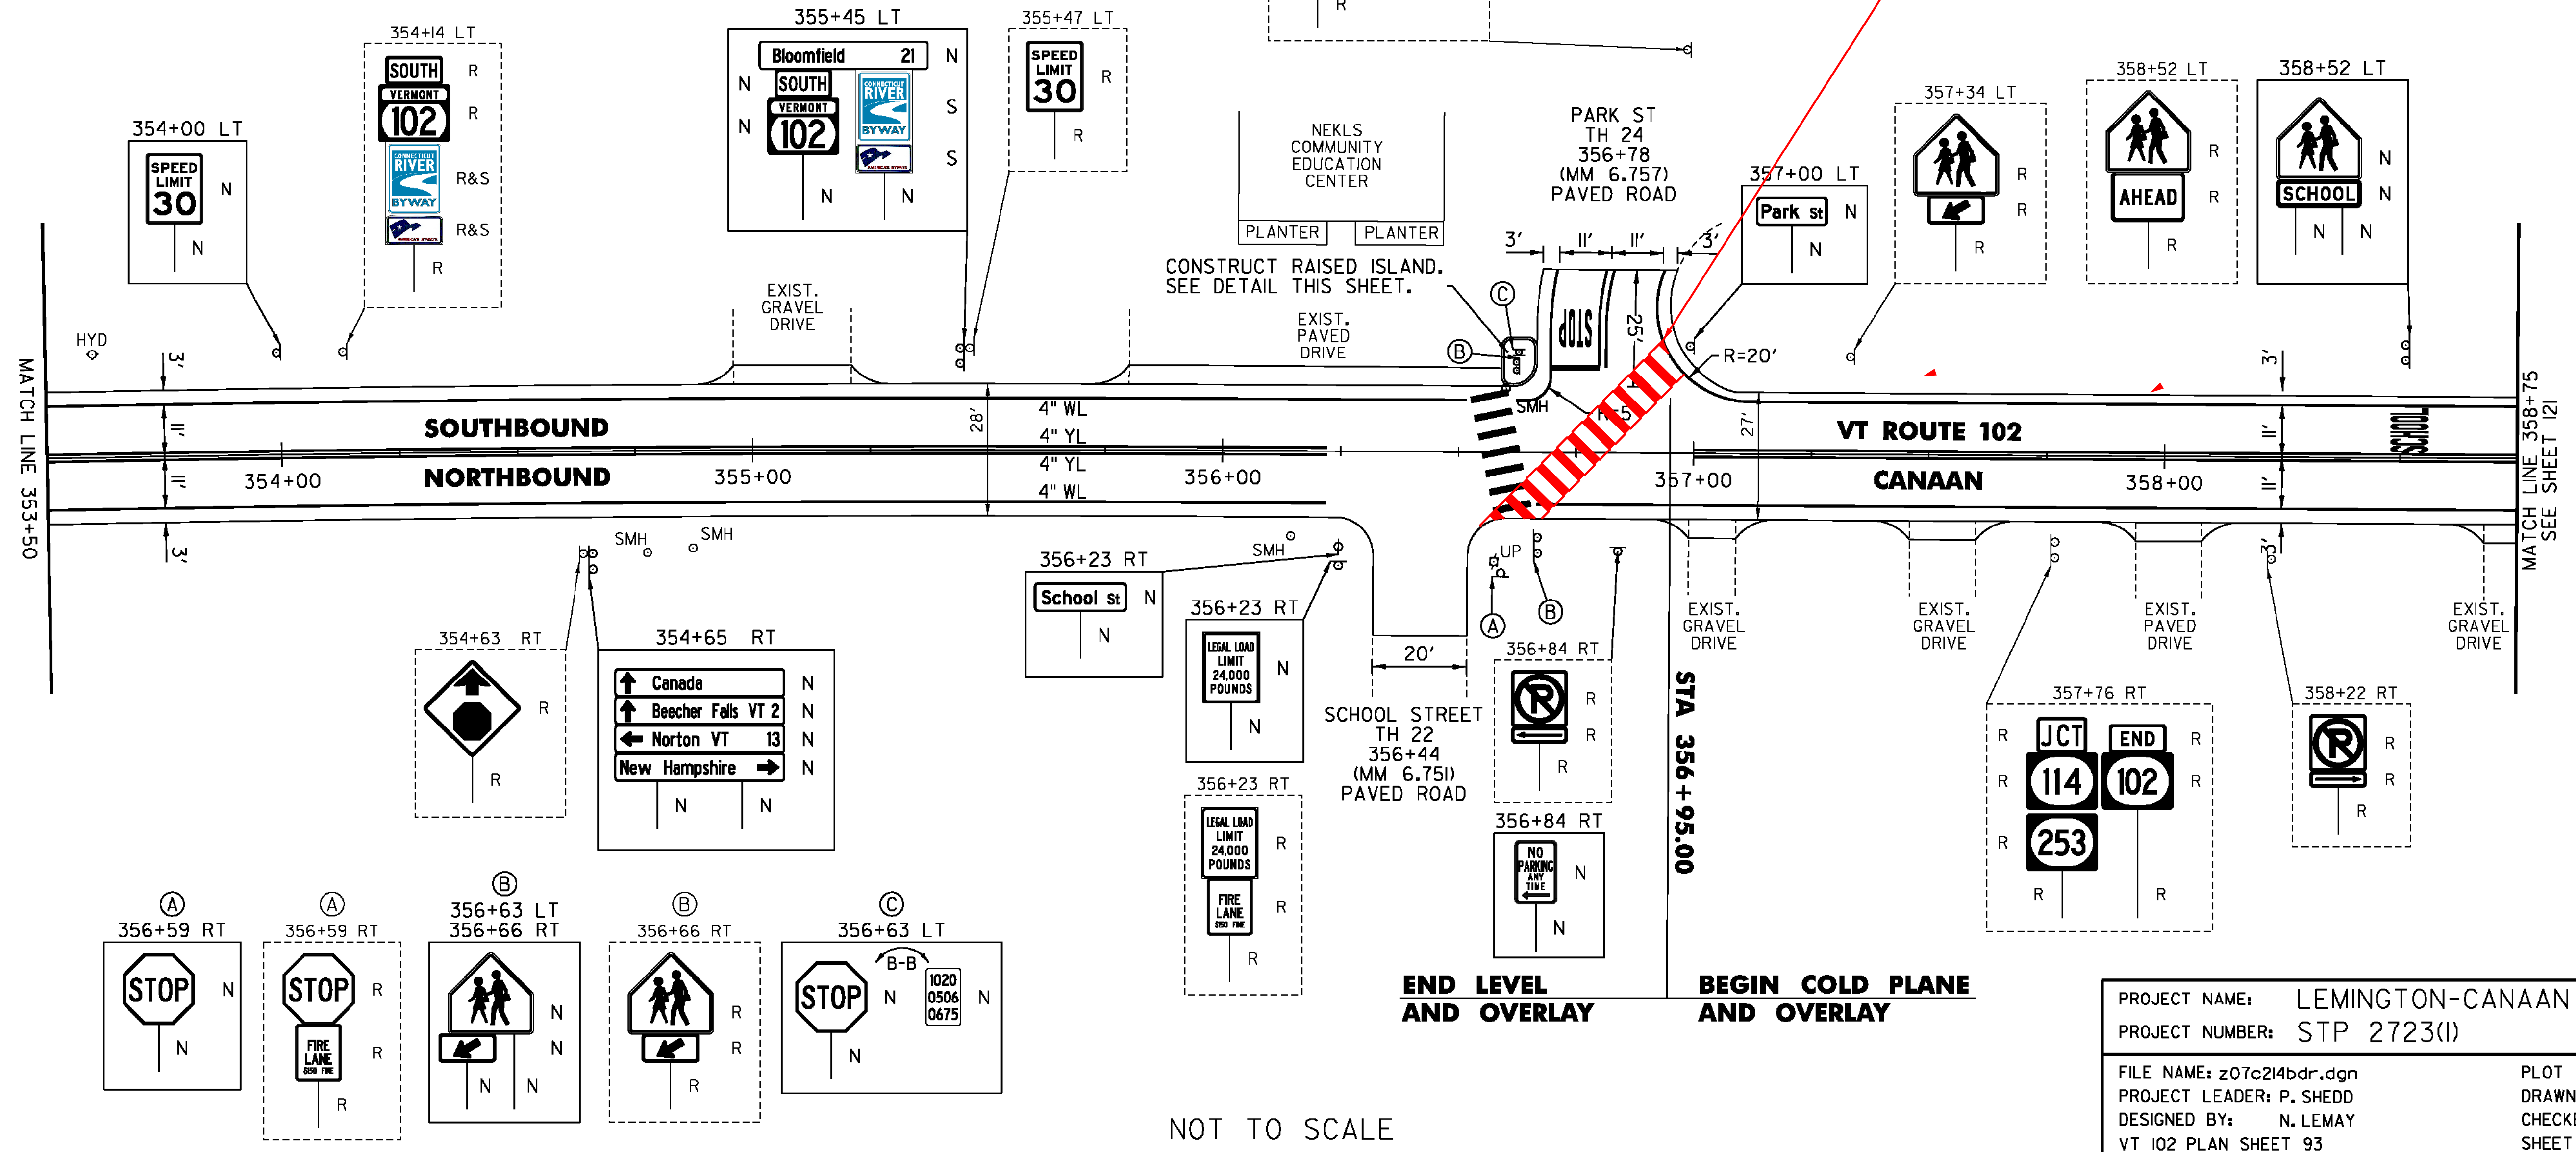

PROJECT NAME:	LEMINGTON-CANAAN	PLOT DATE:	2/28/2015
PROJECT NUMBER:	STP 2723(I)	DRAWN BY:	W. GORDON
FILE NAME:	z07c214bdr.dgn	CHECKED BY:	P. SHEDD
PROJECT LEADER:	P. SHEDD	SHEET	116 OF 162
DESIGNED BY:	N. LEMAY		
VT 102 PLAN SHEET	93		

CLD 14-0197