

TEMPORARY 4 INCH WHITE LINE, PAINT
 DURABLE 4 INCH WHITE LINE (OPTION BID ITEM)
 433+50 TO 435+16 SOLID LT
 433+50 TO 435+16 SOLID RT
 435+16 TO 435+36 LT (NO PARKING)
 435+16 TO 435+36 RT (NO PARKING)
 435+45 TO 438+50 SOLID LT
 435+94 TO 438+50 SOLID RT


TEMPORARY 4 INCH YELLOW LINE, PAINT
 DURABLE 4 INCH YELLOW LINE (OPTION BID ITEM)
 433+50 TO 435+34 SOLID LT & RT
 435+74 TO 438+50 SOLID LT & RT

TEMPORARY CROSSWALK MARKING, PAINT
 DURABLE CROSSWALK MARKING (OPTION BID ITEM)
 435+40 LT TO RT

TEMPORARY LETTER OR SYMBOL, PAINT
 DURABLE LETTER OR SYMBOL (OPTION BID ITEM)
 433+52 RT * SCHOOL *

REHAB. DROP INLETS, CATCH BASINS,
 OR MANHOLES, CLASS I, CLASS II, OR CLASS III
 436+72 LT
 438+16 LT
 438+16 RT

CHANGING ELEVATION
 OF SEWER MANHOLES (NON-PART)
 437+57 RT

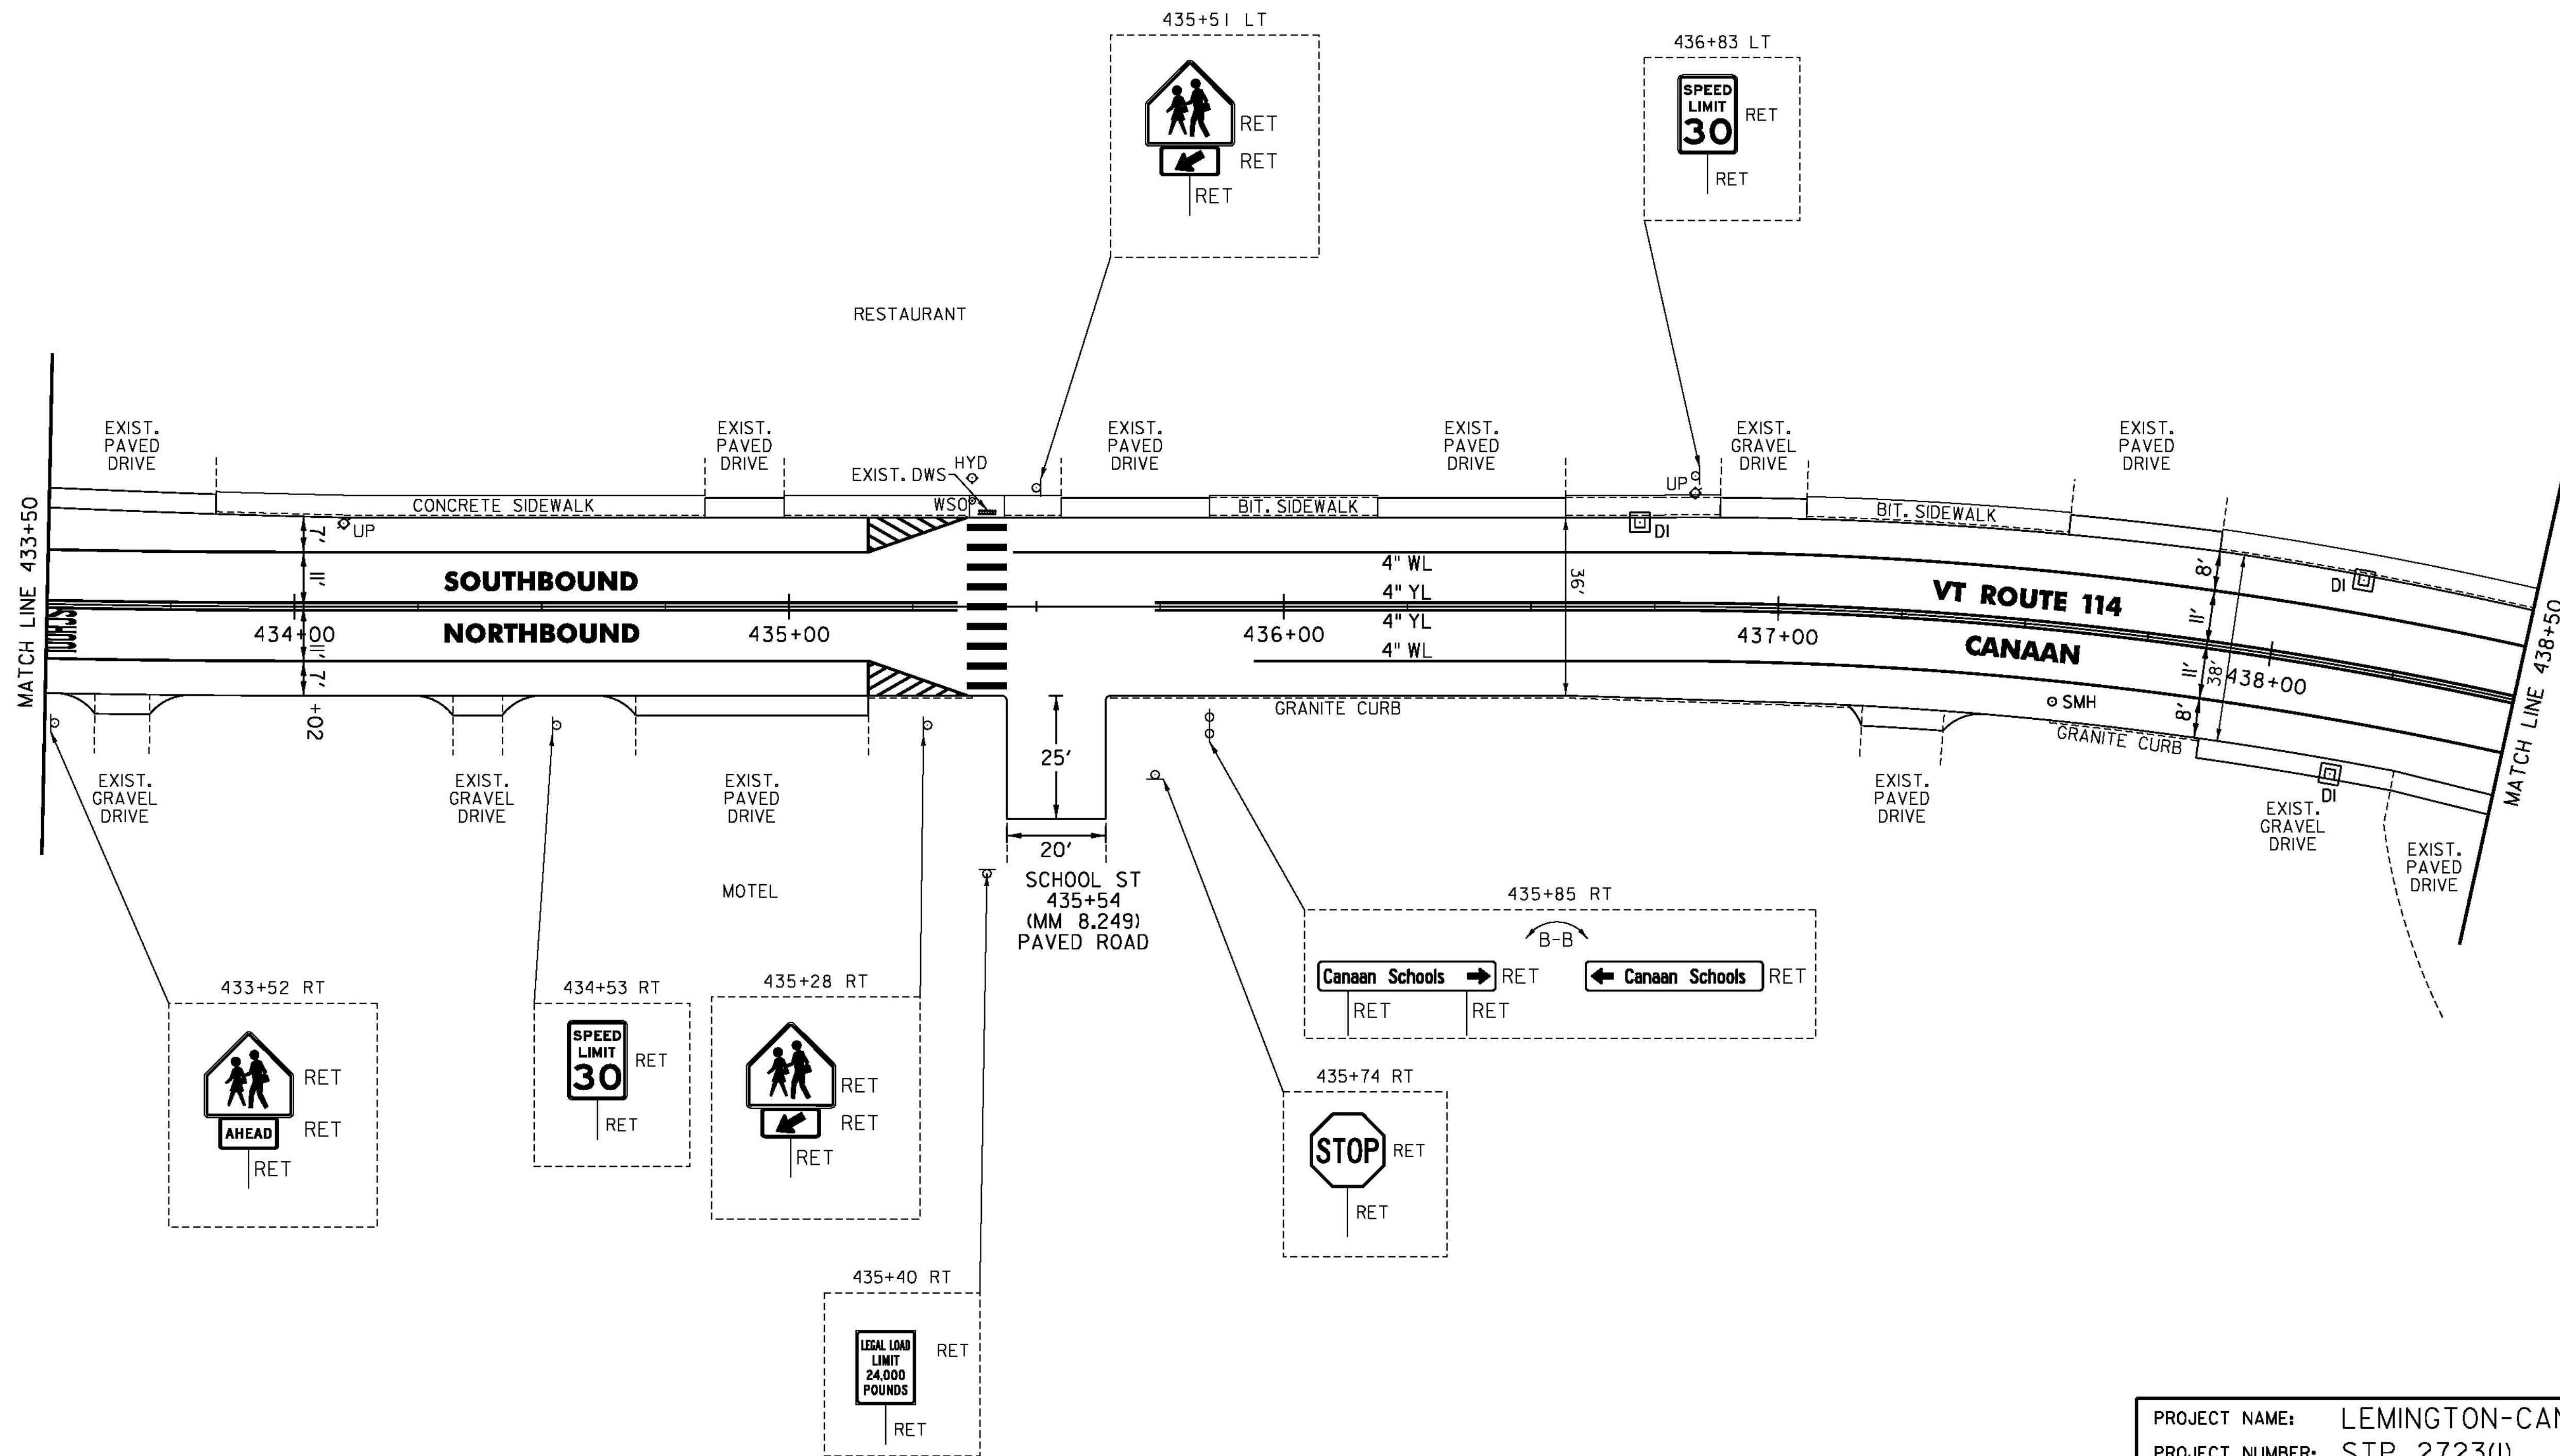

NOT TO SCALE

PROJECT NAME:	LEMINGTON-CANAAN
PROJECT NUMBER:	STP 2723(I)
FILE NAME:	z07c214bdr.dgn
PROJECT LEADER:	P. SHEDD
DESIGNED BY:	N. LEMAY
VT 114 PLAN SHEET 6	
PLOT DATE:	3/4/2015
DRAWN BY:	W. GORDON
CHECKED BY:	P. SHEDD
SHEET	122 OF 162

CLD 14-0197