

TEMPORARY 4 INCH WHITE LINE, PAINT
 DURABLE 4 INCH WHITE LINE (OPTION BID ITEM)
 C18+50 TO C24+50 SOLID RT
 C18+50 TO C21+50 SOLID LT
 C22+30 TO C24+50 SOLID LT


TEMPORARY 4 INCH YELLOW LINE, PAINT
 DURABLE 4 INCH YELLOW LINE (OPTION BID ITEM)
 C18+50 TO C21+70 SOLID LT & RT
 C22+10 TO C24+50 SOLID LT & RT

STEEL BEAM GUARDRAIL, GALVANIZED
 C23+14.5 TO C24+50 RT

ANCHOR FOR STEEL BEAM RAIL
 1 (SEE STANDARD G-1d)

REMOVAL AND DISPOSAL OF GUARDRAIL
 C23+18 TO C24+50 RT

DELINEATOR WITH STEEL POST
 C23+14.5 RT

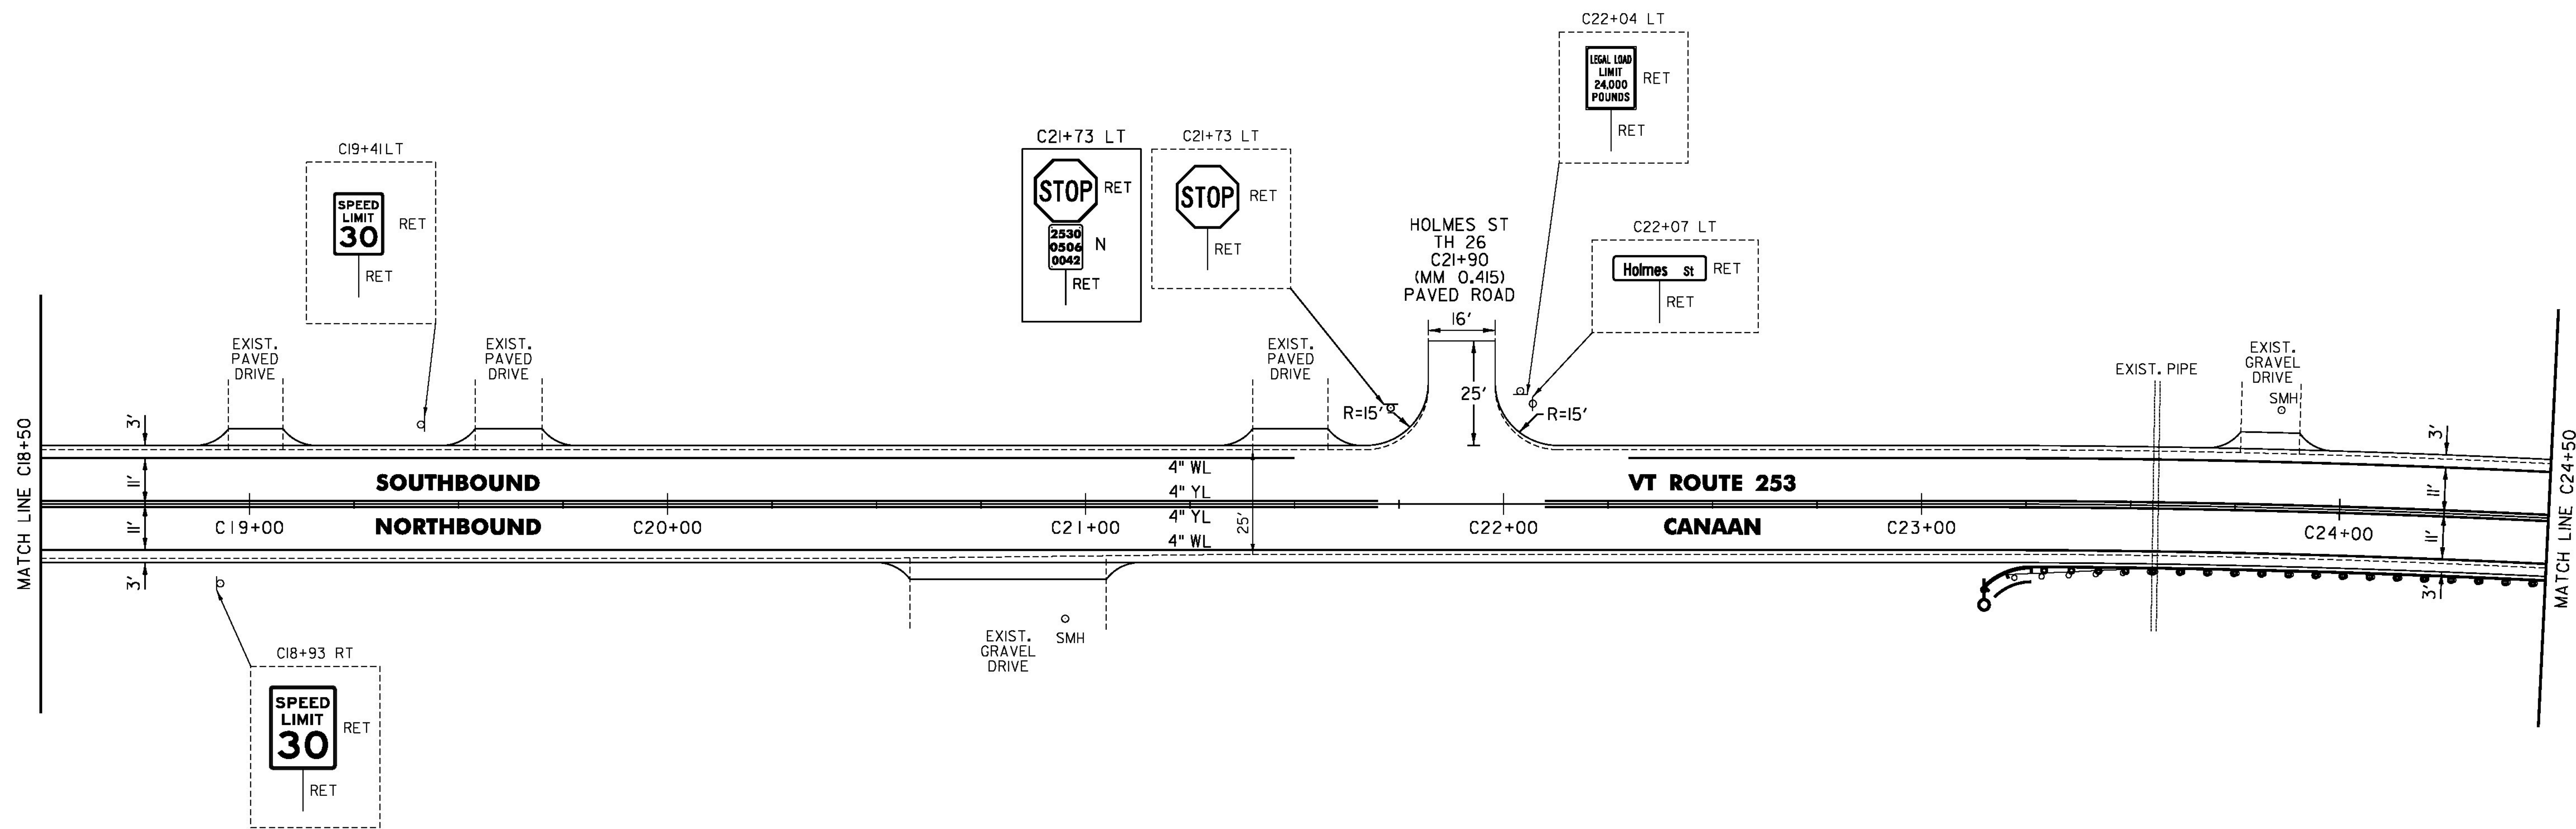

CLD 14-0197

NOT TO SCALE

PROJECT NAME:	LEMINGTON-CANAAN
PROJECT NUMBER:	STP 2723(I)
FILE NAME:	z07c214bdr.dgn
PROJECT LEADER:	P. SHEDD
DESIGNED BY:	N. LEMAY
VT 253 PLAN SHEET 4	
PLOT DATE:	2/28/2015
DRAWN BY:	W. GORDON
CHECKED BY:	P. SHEDD
SHEET	127 OF 162