

TEMPORARY 4 INCH WHITE LINE, PAINT
 DURABLE 4 INCH WHITE LINE (OPTION BID ITEM)
 C35+50 TO C41+50 SOLID LT & RT


TEMPORARY 4 INCH YELLOW LINE, PAINT
 DURABLE 4 INCH YELLOW LINE (OPTION BID ITEM)
 C35+50 TO C41+50 SOLID LT & RT

STEEL BEAM GUARDRAIL, GALVANIZED
 C35+50 TO C37+66 RT

STEEL BEAM GUARDRAIL,
 GALVANIZED W/8 FEET POSTS
 C37+66 TO C41+50 RT

REMOVAL AND DISPOSAL OF GUARDRAIL
 C35+50 TO C41+50 RT

REMOVING SIGNS
 1 - AS SHOWN

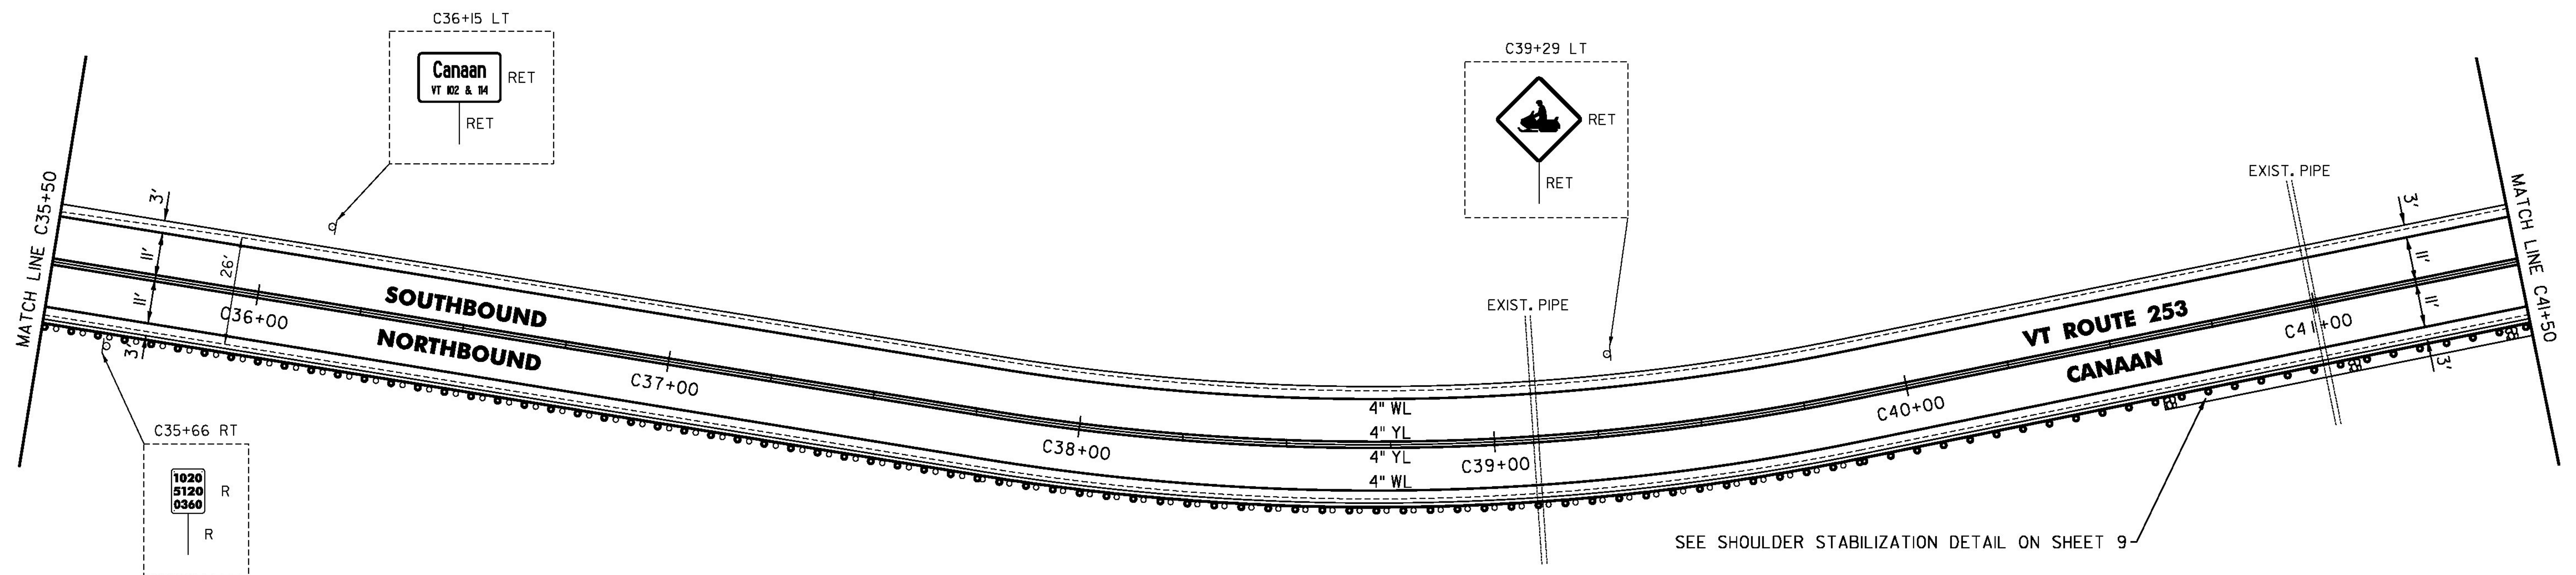

CLD 14-0197

NOT TO SCALE

PROJECT NAME:	LEMINGTON-CANAAN
PROJECT NUMBER:	STP 2723(I)
FILE NAME:	z07c214bdr.dgn
PROJECT LEADER:	P. SHEDD
DESIGNED BY:	N. LEMAY
VT 253 PLAN SHEET 7	
PLOT DATE:	2/28/2015
DRAWN BY:	W. GORDON
CHECKED BY:	P. SHEDD
SHEET	130 OF 162