


INDEX OF SHEETS
SEE SHEET 2

STATE OF VERMONT
AGENCY OF TRANSPORTATION

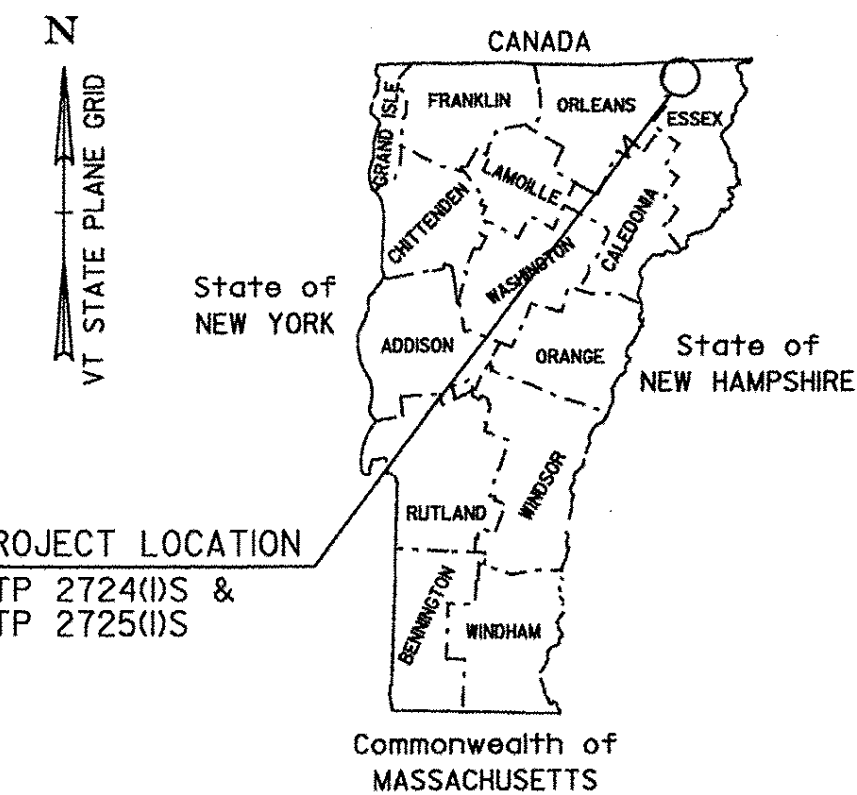

RECORD PLANS

CONTRACTOR: PIKE INDUSTRIES, INC. - BERLIN, VT

RESIDENT ENGINEER: DOUG BUMPS

CONSTRUCTION BEGAN: AUGUST 24, 2009

CONSTRUCTION COMPLETE: SEPTEMBER 8, 2010

RECORD PLANS BY: DOUG BUMPS & C. PIERCE

I HEREBY CERTIFY THAT ALL THE CONSTRUCTION REQUIRED BY THIS SET OF DRAWINGS HAS BEEN ACCOMPLISHED AS INDICATED HEREIN.

BY *Doug Bumps* RESIDENT ENGINEER



DATE 7/14/11

NOTE: Any further information concerning final quantities, amounts or other details relative to this project may be found at Central Files in the electronic archives.

PROPOSED IMPROVEMENT
TOWNS OF BRIGHTON, MORGAN, WARREN GORE & NORTON
COUNTIES OF ESSEX & ORLEANS
VT. ROUTE 114 & VT. ROUTE 147

BRIGHTON, MORGAN AND WARREN GORE
STP 2724(1)S
SEE SHEET 11
FOR ADDITIONAL PROJECT INFORMATION
AND THE SUPERPAVE DESIGN CRITERIA

WARREN GORE & NORTON
STP 2725(1)S
SEE SHEET 73
FOR ADDITIONAL PROJECT INFORMATION
AND THE SUPERPAVE DESIGN CRITERIA

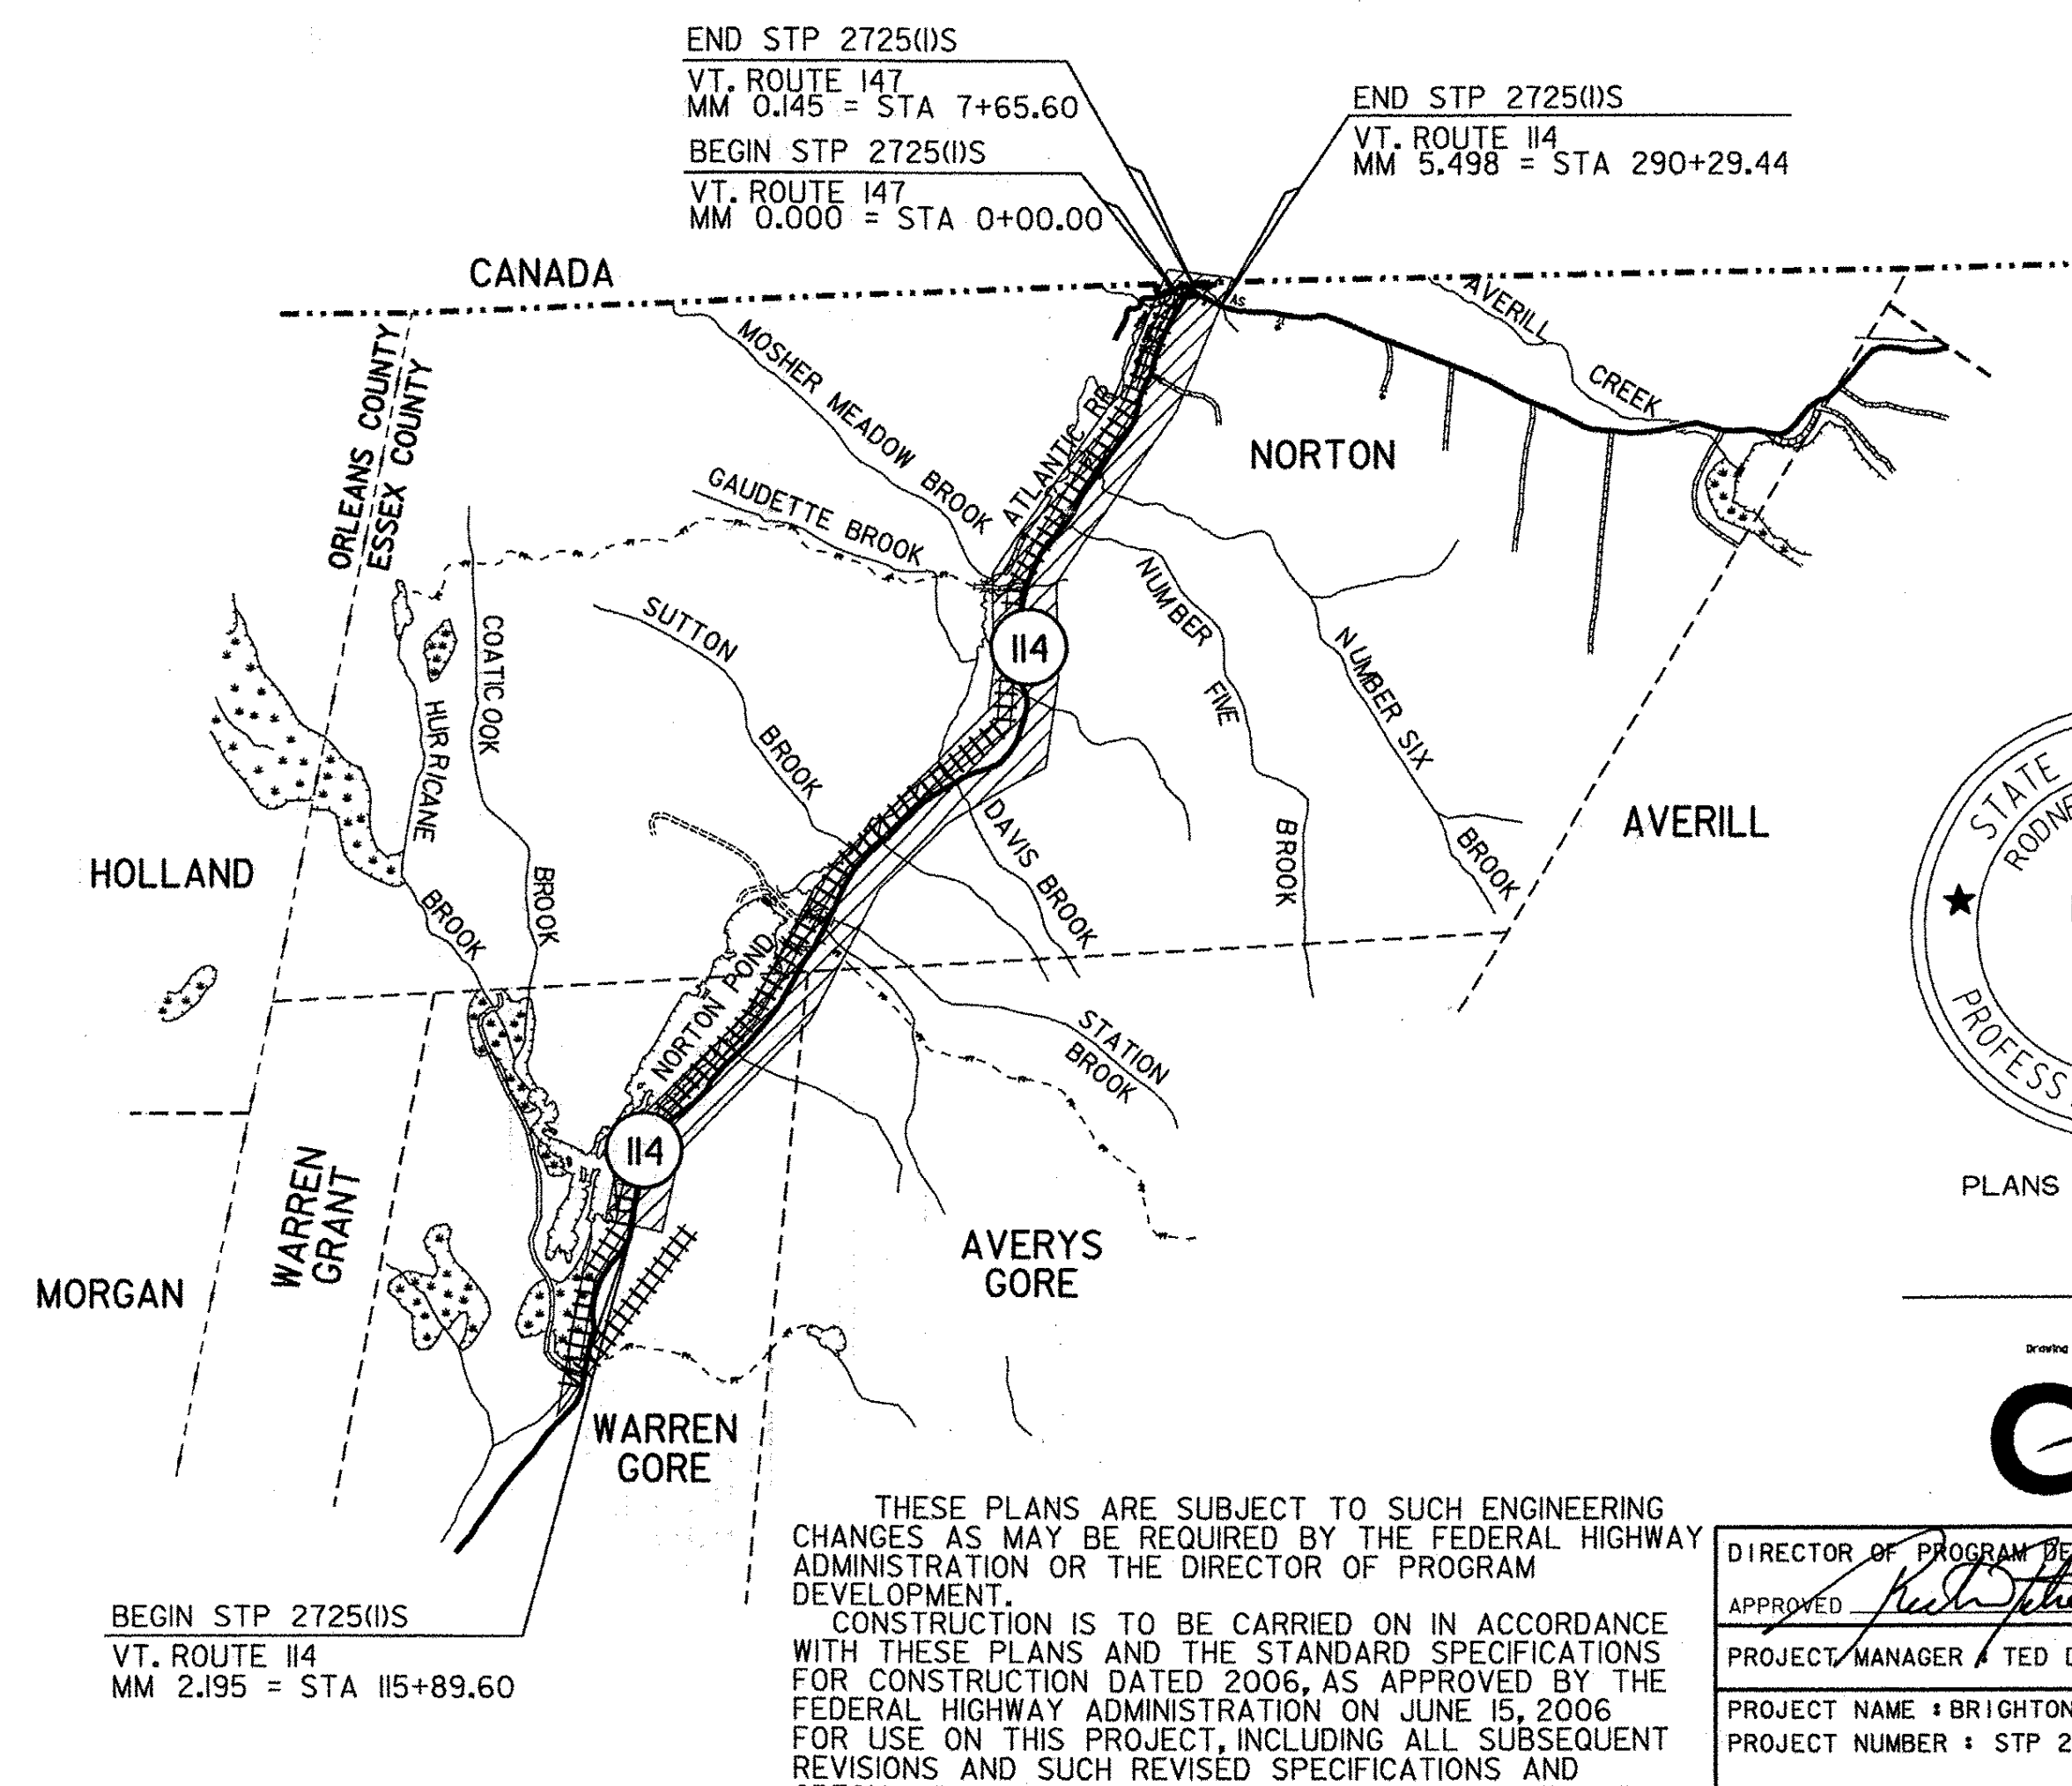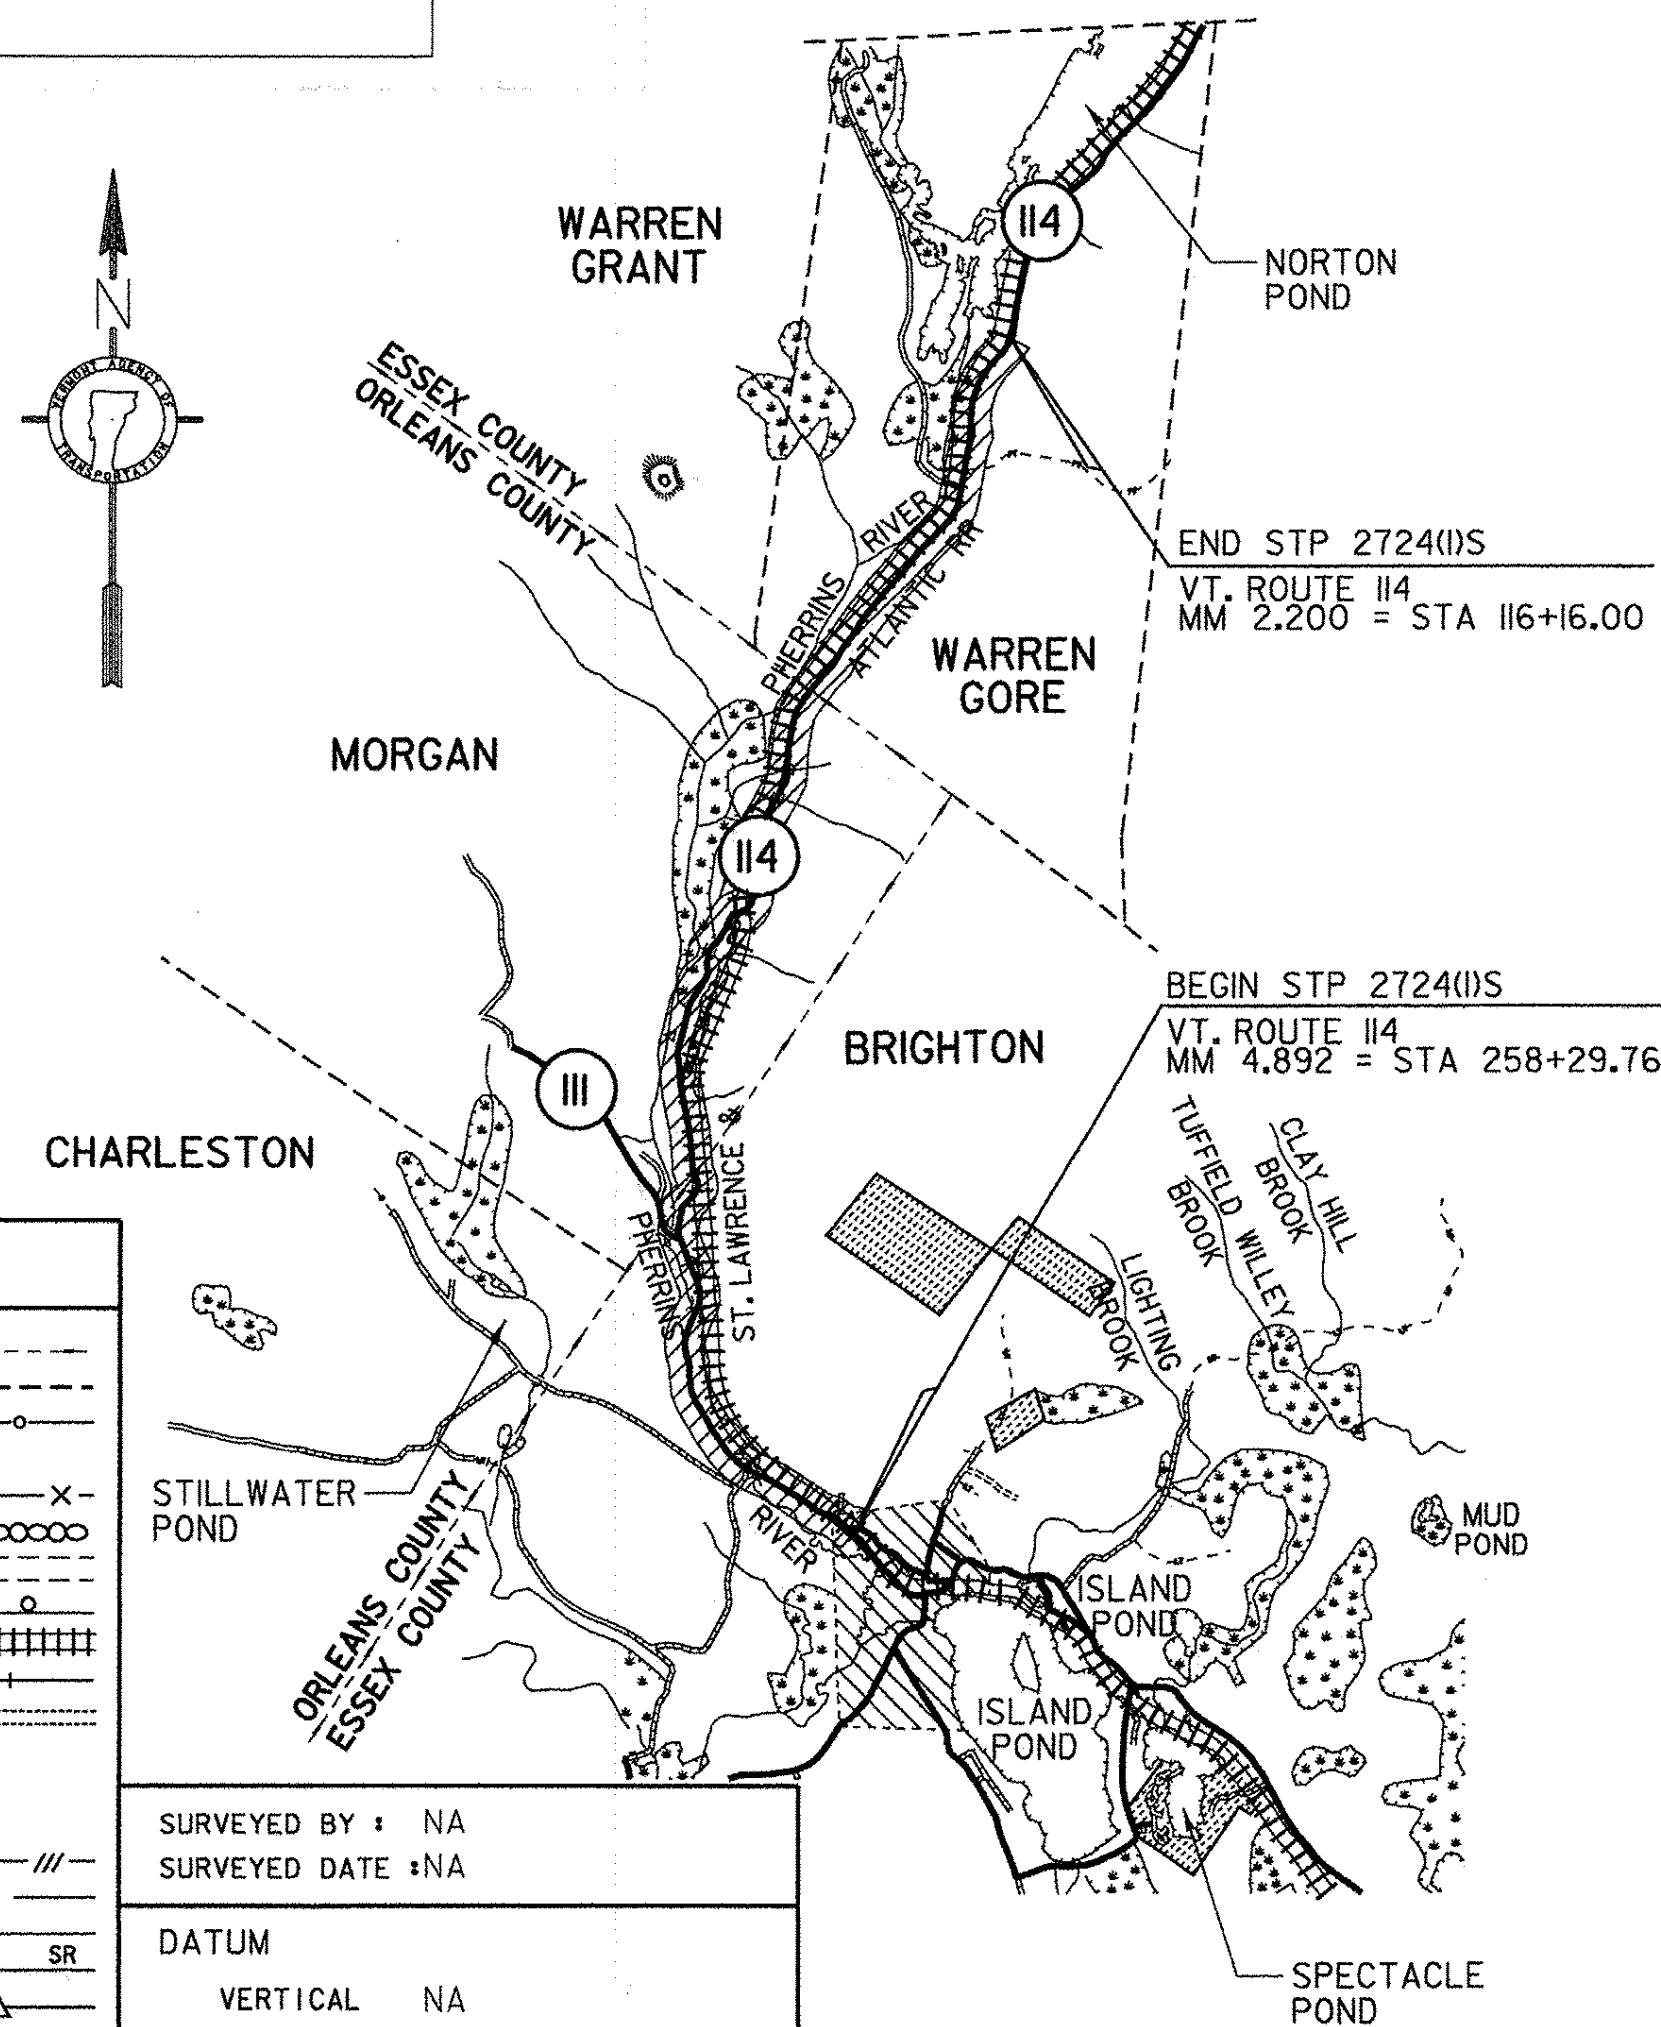

CONVENTIONAL SYMBOLS


COUNTY LINE	---
TOWN LINE	- - - -
LIMITS OF ACCESS	○ — ○
POINT OF ACCESS	X
FENCE LINE	X — X — X — X
STONE WALL	○ — ○ — ○ — ○
TRAVELED WAY	— — — —
GUARD RAIL	— — — —
RAILROAD	— — — —
SURVEY LINE	— — — —
CULVERT	— — — —
POWER POLE	⊕
TELEPHONE POLE	⊕
TREES	⊙
CONTROL OF ACCESS	///
PROPERTY LINE	— — — —
R.O.W. TAKING LINE	— — — —
SLOPE RIGHTS	SR
TOP OF CUT	△
TOE OF SLOPE	○

SURVEYED BY : NA
SURVEYED DATE : NA

DATUM
VERTICAL NA
HORIZONTAL NA

THESE PLANS ARE SUBJECT TO SUCH ENGINEERING CHANGES AS MAY BE REQUIRED BY THE FEDERAL HIGHWAY ADMINISTRATION OR THE DIRECTOR OF PROGRAM DEVELOPMENT.

CONSTRUCTION IS TO BE CARRIED ON IN ACCORDANCE WITH THESE PLANS AND THE STANDARD SPECIFICATIONS FOR CONSTRUCTION DATED 2006, AS APPROVED BY THE FEDERAL HIGHWAY ADMINISTRATION ON JUNE 15, 2006 FOR USE ON THIS PROJECT, INCLUDING ALL SUBSEQUENT REVISIONS AND SUCH REVISED SPECIFICATIONS AND SPECIAL PROVISIONS AS ARE INCORPORATED IN THESE PLANS.

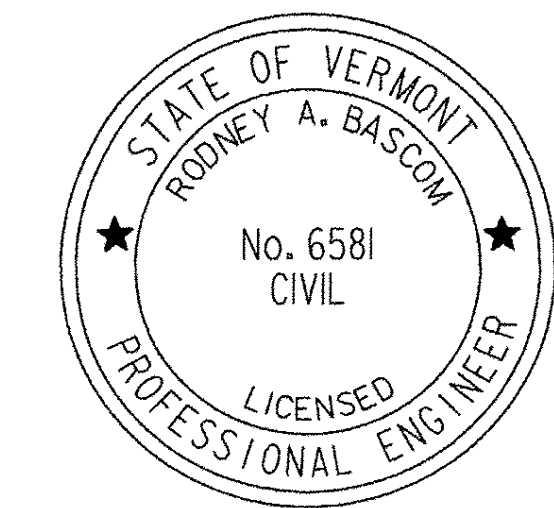

PLANS PREPARED BY



DIRECTOR OF PROGRAM DEVELOPMENT

APPROVED *[Signature]* DATE 6-9-09

PROJECT MANAGER : TED DOMEY

PROJECT NAME : BRIGHTON, MORGAN, WARREN GORE & NORTON

PROJECT NUMBER : STP 2724(1)S & STP 2725(1)S

SHEET 1 OF 107 SHEETS