


646.402 DURABLE 4 INCH WHITE LINE, THERMOPLASTIC
 (ALL LINES WILL INCLUDE EDGE LINE BREAKS AND
 RADIUS FOR TOWN HIGHWAYS)
 WARREN GORE:
 STA 110+00.00 - STA 116+16.00 EDGE LINE LT & RT

646.412 DURABLE 4 INCH YELLOW LINE, THERMOPLASTIC
 (ALL LINES WILL INCLUDE C/L BREAKS FOR
 TOWN HIGHWAYS) S=SOLID, D=DASHED
 WARREN GORE
 STA 110+00.00 - STA 116+16.00 LT C RT
 S - S

646.602 TEMPORARY 4 INCH WHITE LINE, PAINT
 (ALL LINES WILL INCLUDE EDGE LINE BREAKS AND
 RADIUS FOR TOWN HIGHWAYS)
 WARREN GORE:
 STA 110+00.00 - STA 116+16.00 EDGE LINE LT & RT

646.612 TEMPORARY 4 INCH YELLOW LINE, PAINT
 (ALL LINES WILL INCLUDE C/L BREAKS FOR
 TOWN HIGHWAYS) S=SOLID, D=DASHED
 WARREN GORE
 STA 110+00.00 - STA 116+16.00 LT C RT
 S - S

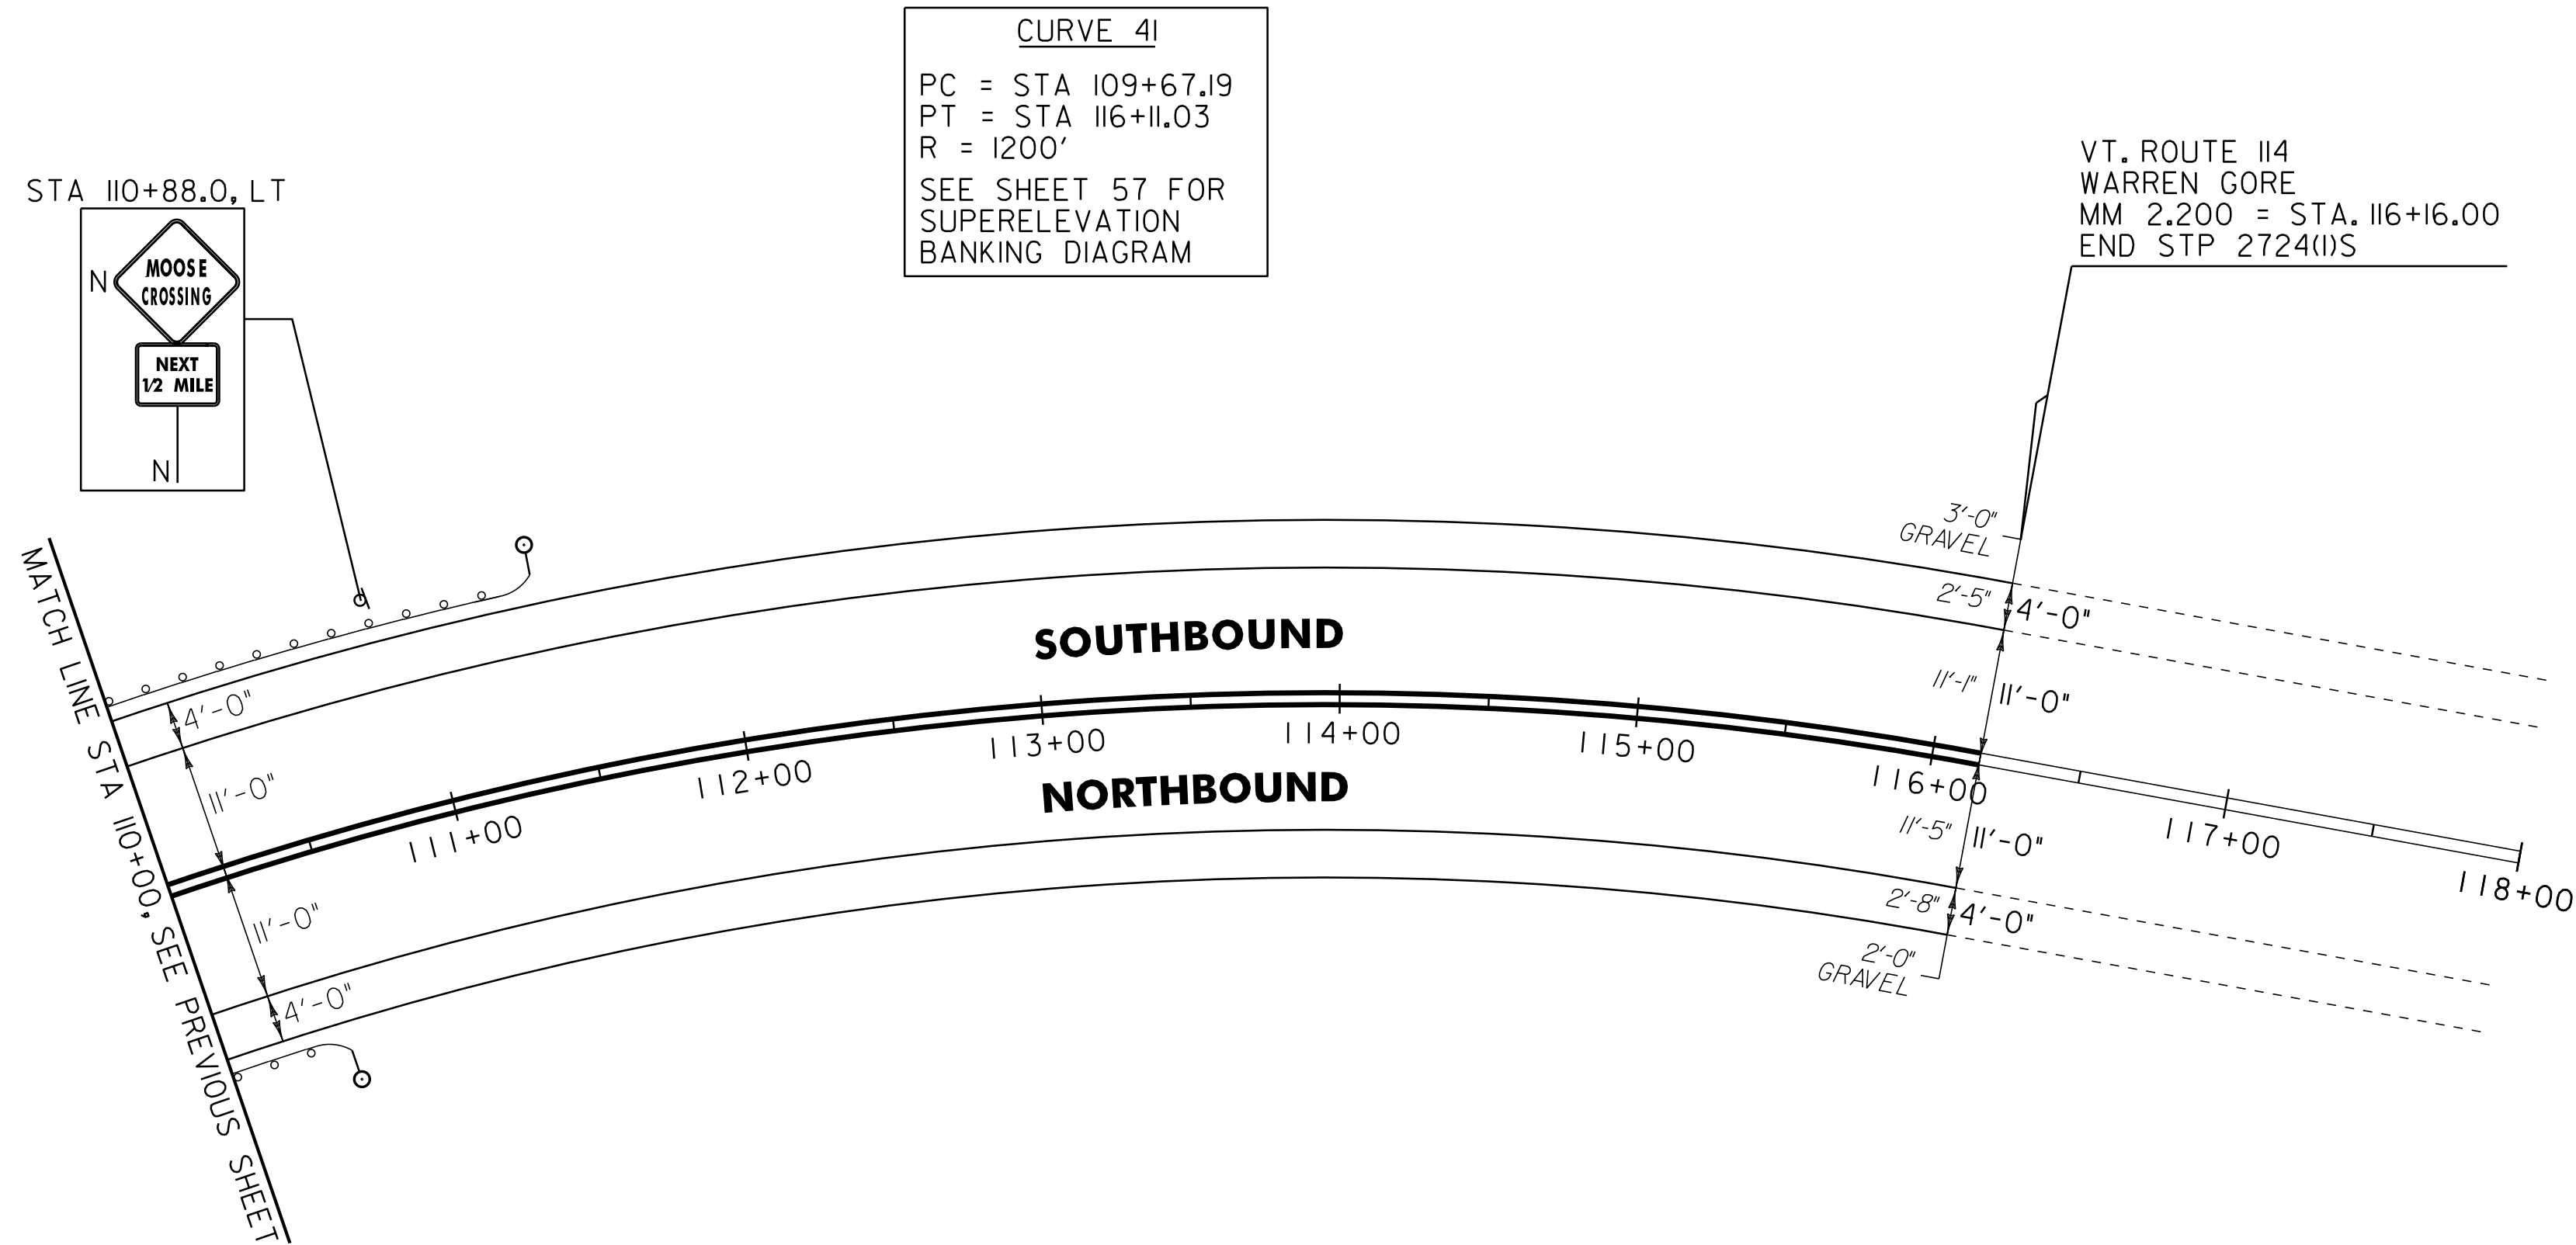

621.20 STEEL BEAM GUARDRAIL, GALVANIZED
 WARREN GORE:
 STA 110+00.0 - STA 111+04.5 LT (104.5 LF)

621.80 REMOVAL AND DISPOSAL OF GUARDRAIL
 WARREN GORE:
 STA 110+00.0 - STA 111+40.0 LT (140.0 LF)

621.50 MANUFACTURED TERMINAL SECTION, FLARED
 WARREN GORE:
 STA 110+00.0 - STA 110+32.0 RT
 STA 111+04.5 - STA 111+42.0 LT

676.10 DELINEATOR WITH STEEL POST
 WARREN GORE:
 STA 110+32.0 RT
 STA 111+42.0 LT

SIGN LEGEND
 R = REMOVE
 S = SALVAGE
 N = NEW
 RET = RETAIN
 B-B = BACK TO BACK
 EXISTING = - - - - -
 NEW = _____

NOT TO SCALE

PROJECT LAYOUT SHEET #21

PROJECT NAME: BRIGHTON - WARREN GORE
 PROJECT NUMBER: STP 2724(1)S
 FILE NAME: p07c216.dgn
 PROJECT LEADER: D.E.G.
 DESIGNED BY: M.J.L.
 IPARM FILE: p07c216121.i

PLOT DATE: 31-OCT-2011 11:51
 DRAWN BY: C.A.K.
 CHECKED BY: D.W.E.
 SHEET 41 OF 107