



**COLD PLANE AND OVERLAY TYPICAL SECTION**

STA. 3+75.00 TO STA. 9+50  
 STA. 89+50 TO STA. 103+80.00 (WITH NO EDGELINES)

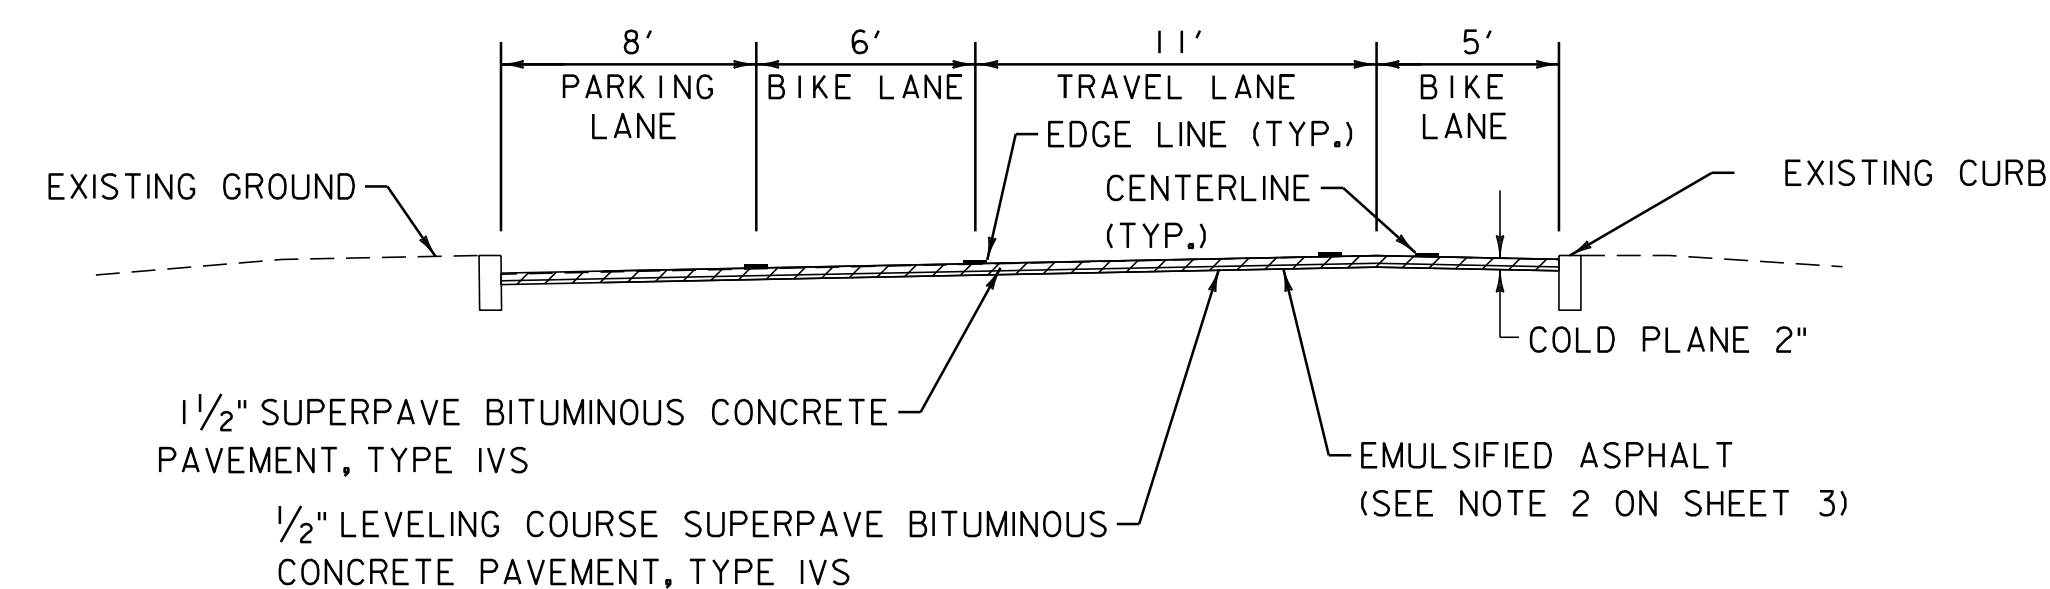


**COLD PLANE AND OVERLAY TYPICAL SECTION**

STA. 18+75 - STA. 42+25

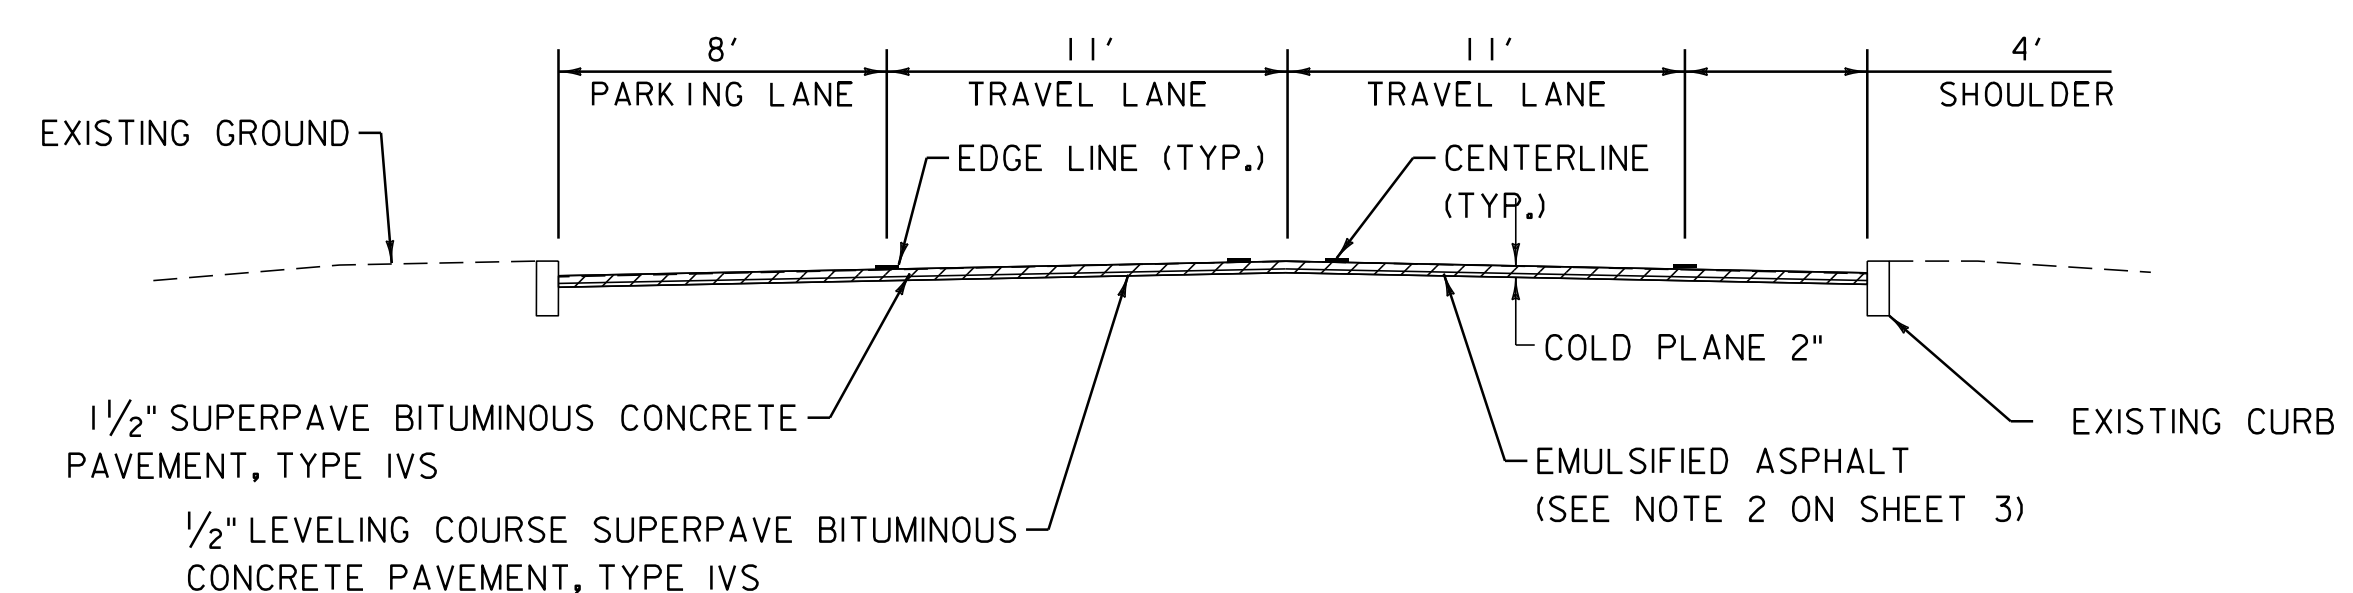

**COLD PLANE AND OVERLAY TYPICAL SECTION**

STA. 9+50 TO STA. 18+75

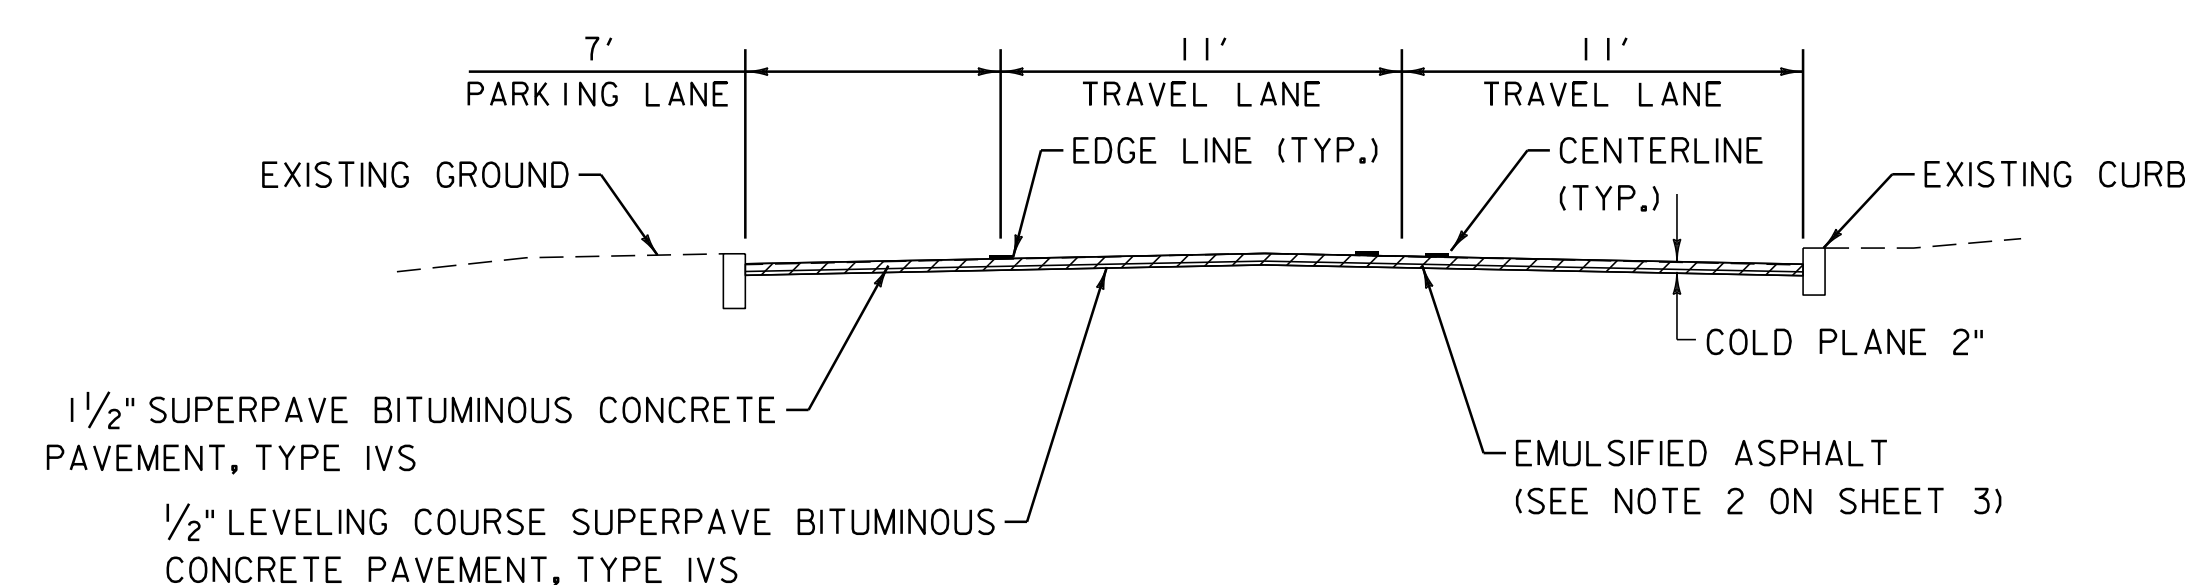

**COLD PLANE AND OVERLAY TYPICAL SECTION**

STA. 42+25 - STA. 46+00

NOT TO SCALE

<b>PROJECT TYPICAL SHEET 1</b>	PROJECT NAME: BURLINGTON (CLASS I)	PLOT DATE: 05-JUN-2014 11:19
	PROJECT NUMBER: STP 2722 (I)	DRAWN BY: SJL
	FILE NAME: 07d028.dgn	CHECKED BY: EPD
	PROJECT LEADER: CDL	SHEET 4 OF 61
DESIGNED BY: SJL		
PLOT FILE: 07d028_4.i		