



COLD PLANE AND OVERLAY TYPICAL SECTION

STA. 46+00 - STA. 50+35

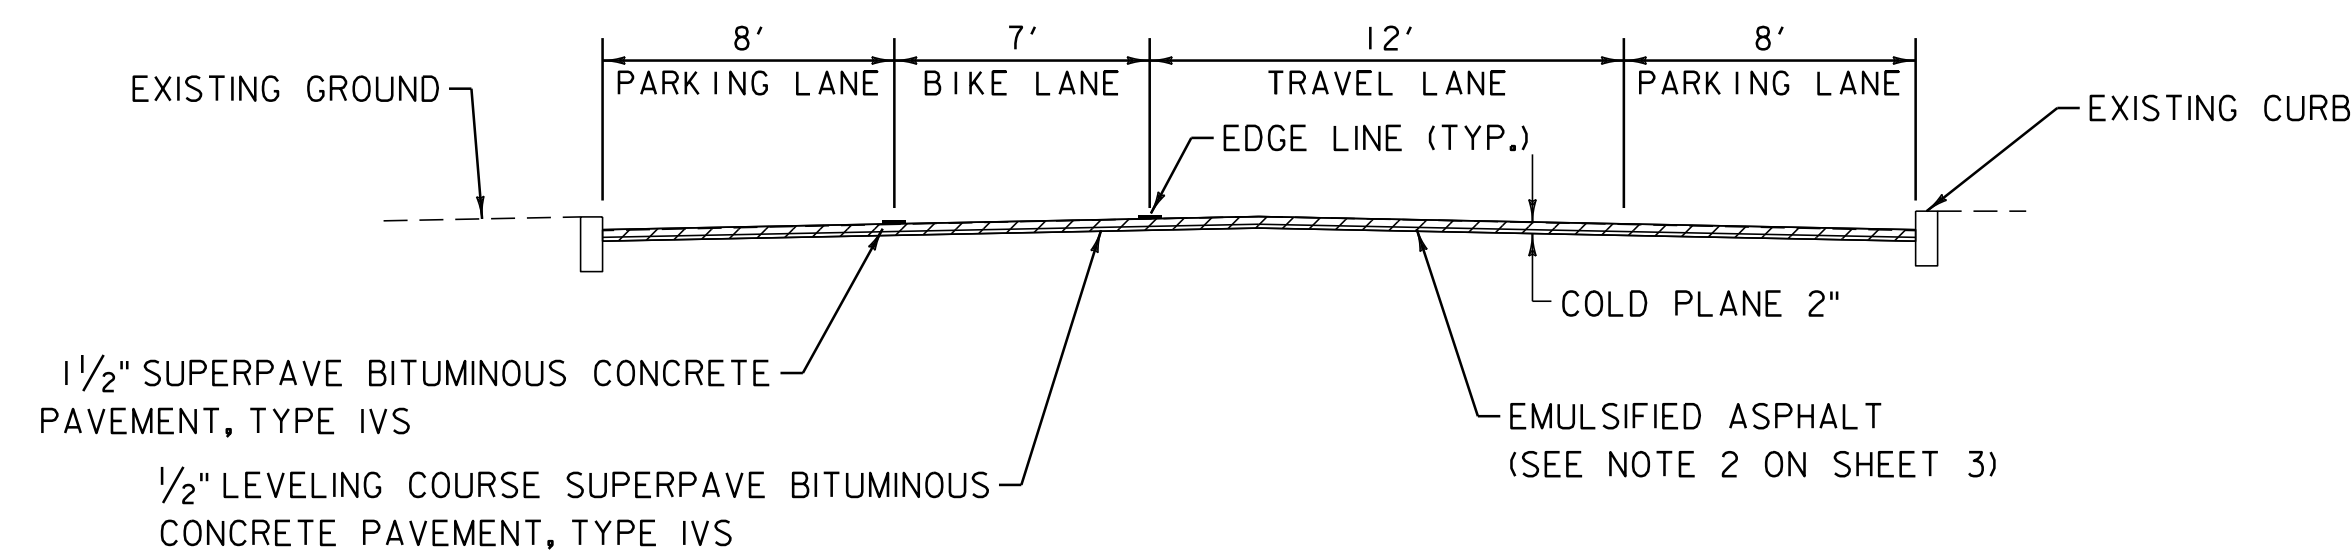


COLD PLANE AND OVERLAY TYPICAL SECTION

STA. 66+75 TO STA. 82+50

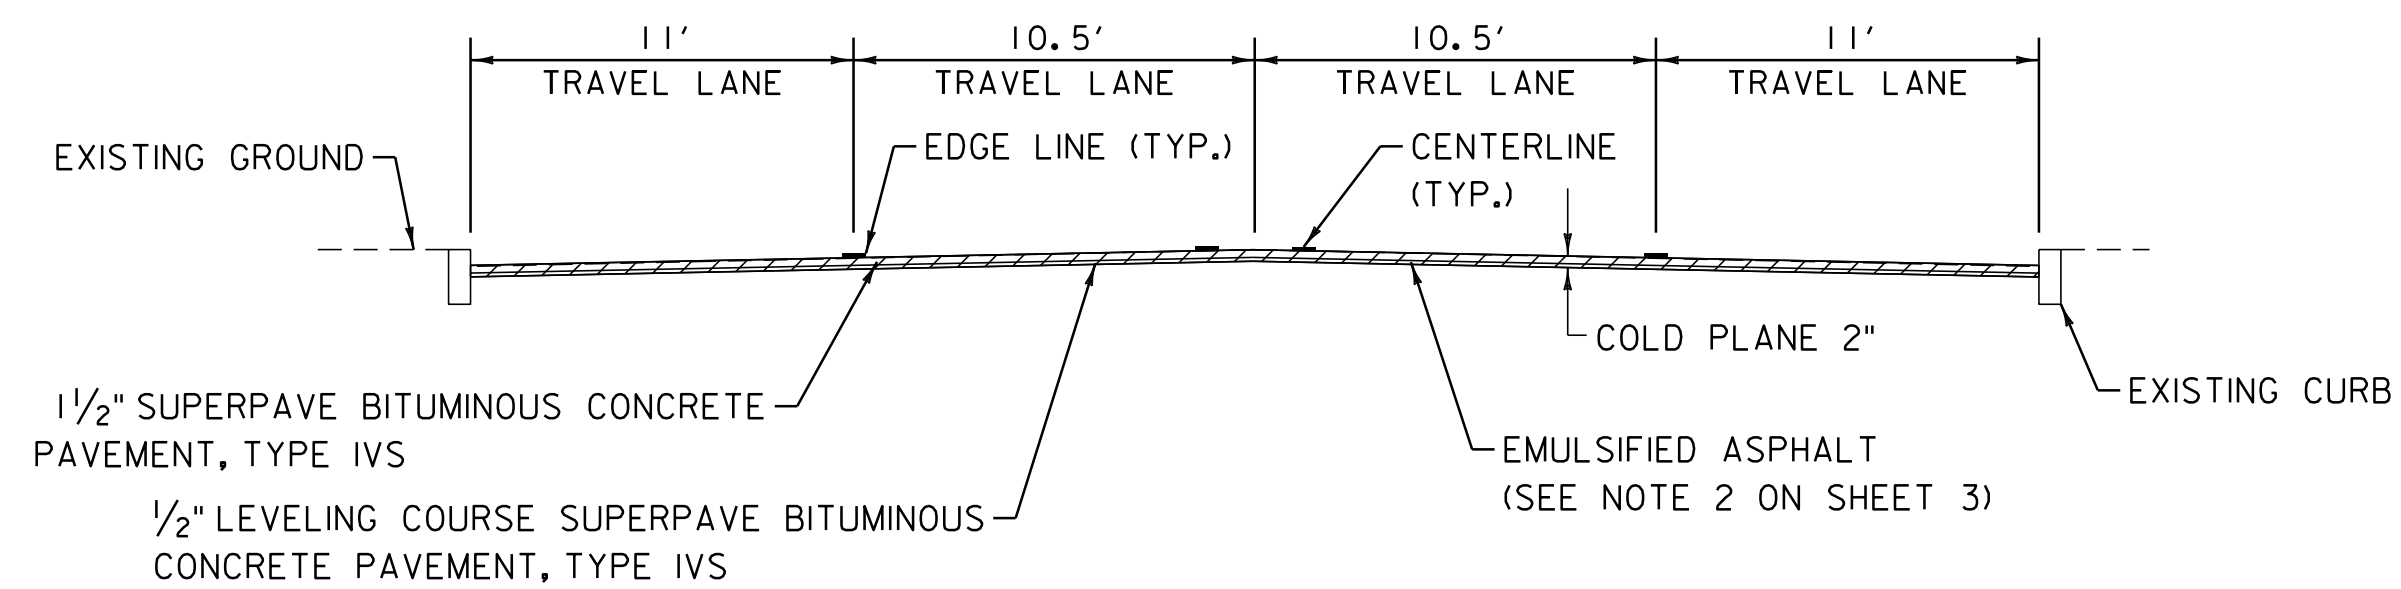

COLD PLANE AND OVERLAY TYPICAL SECTION

STA. 50+35 - STA. 66+75

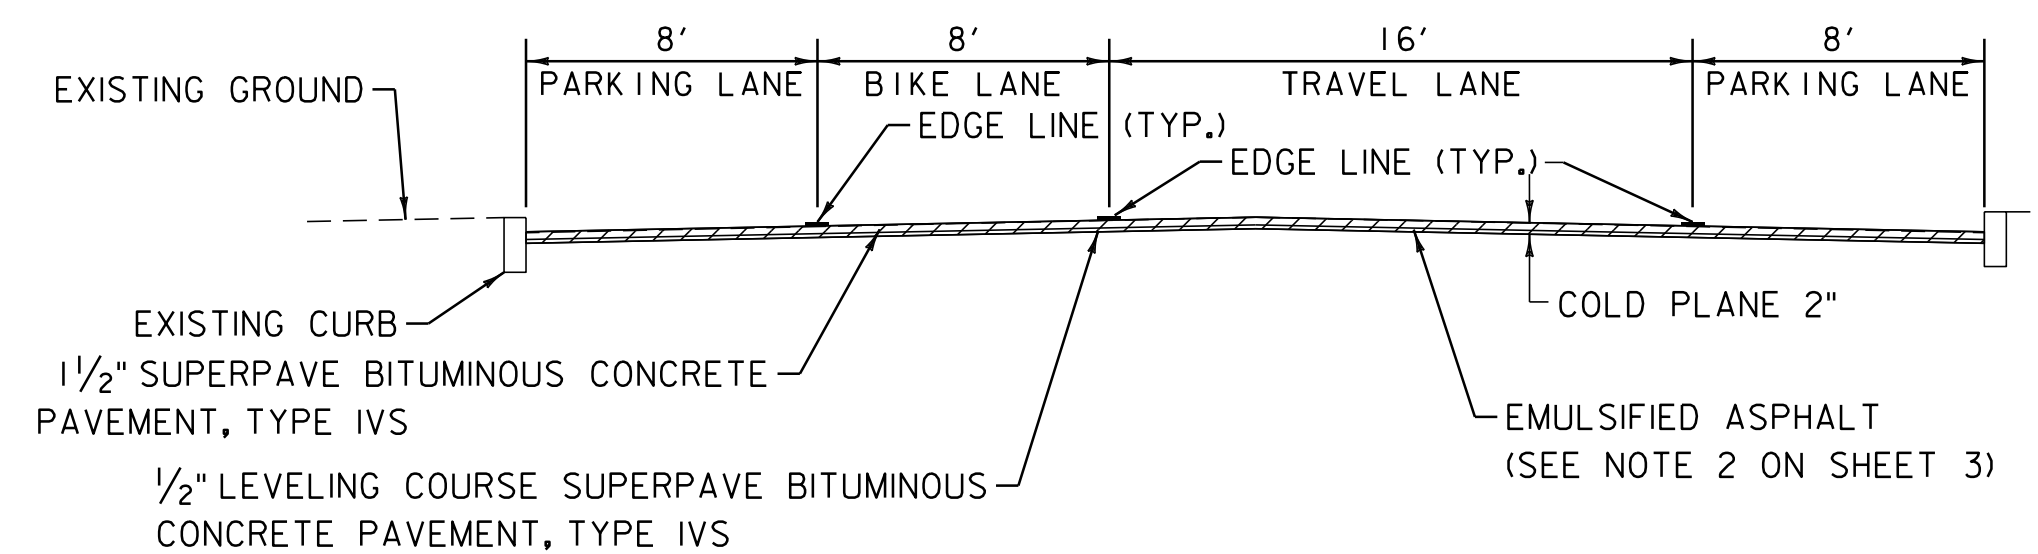

COLD PLANE AND OVERLAY TYPICAL SECTION

STA. 82+50 TO STA. 89+50

NOT TO SCALE

**PROJECT
TYPICAL
SHEET 2**

PROJECT NAME: BURLINGTON (CLASS I)
PROJECT NUMBER: STP 2722 (I)

FILE NAME: 07d028.dgn
PROJECT LEADER: CDL
DESIGNED BY: BMB
PLOT FILE: 07d028_5.i

PLOT DATE: 05-JUN-2014 11:19
DRAWN BY: BMB
CHECKED BY: EPD
SHEET 5 OF 61