

203.16 SOLID ROCK EXCAVATION
 STA. 3+75 - STA. 3+84 LT
 STA. 3+82 - STA. 3+87 RT

604.412, 604.415, 604.418 REHAB, DROP
 INLETS, CATCH BASINS, OR MANHOLES, CLASS I,
 CLASS II OR CLASS III
 STA. 3+75 RT "TYPE D GRATE"
 STA. 3+90 RT "TYPE D GRATE"


604.40 CHANGING ELEVATION OF DROP INLETS,
 CATCH BASINS, OR MANHOLES
 STA. 4+02 RT (TMH)

618.10 PORTLAND CEMENT
 CONCRETE SIDEWALK, 5 INCH
 STA. 3+75 - STA. 3+84 LT
 STA. 3+82 - STA. 3+87 RT

618.30 DETECTABLE WARNING SURFACE
 STA. 3+80 LT
 STA. 3+83 RT

646.406 DURABLE 4" WHITE LINE, RECESSED POLYUREA
 STA. 3+85 - STA. 4+75 (SOLID RT & LT)
 646.416 DURABLE 4" YELLOW LINE, RECESSED POLYUREA
 STA. 3+85 - STA. 4+75 (SOLID RT & LT)
 646.501 DURABLE CROSSWALK MARKING, TYPE I TAPE
 STA. 3+80 LT & RT
 646.602 TEMPORARY 4" WHITE LINE, PAINT
 STA. 3+85 - STA. 4+75 (SOLID RT & LT)
 646.612 TEMPORARY 4" YELLOW LINE, PAINT
 STA. 3+85 - STA. 4+75 (SOLID RT & LT)
 646.702 TEMPORARY CROSSWALK MARKING, PAINT
 STA. 3+80 LT & RT

675.50 REMOVING SIGNS
 AS SHOWN - 4

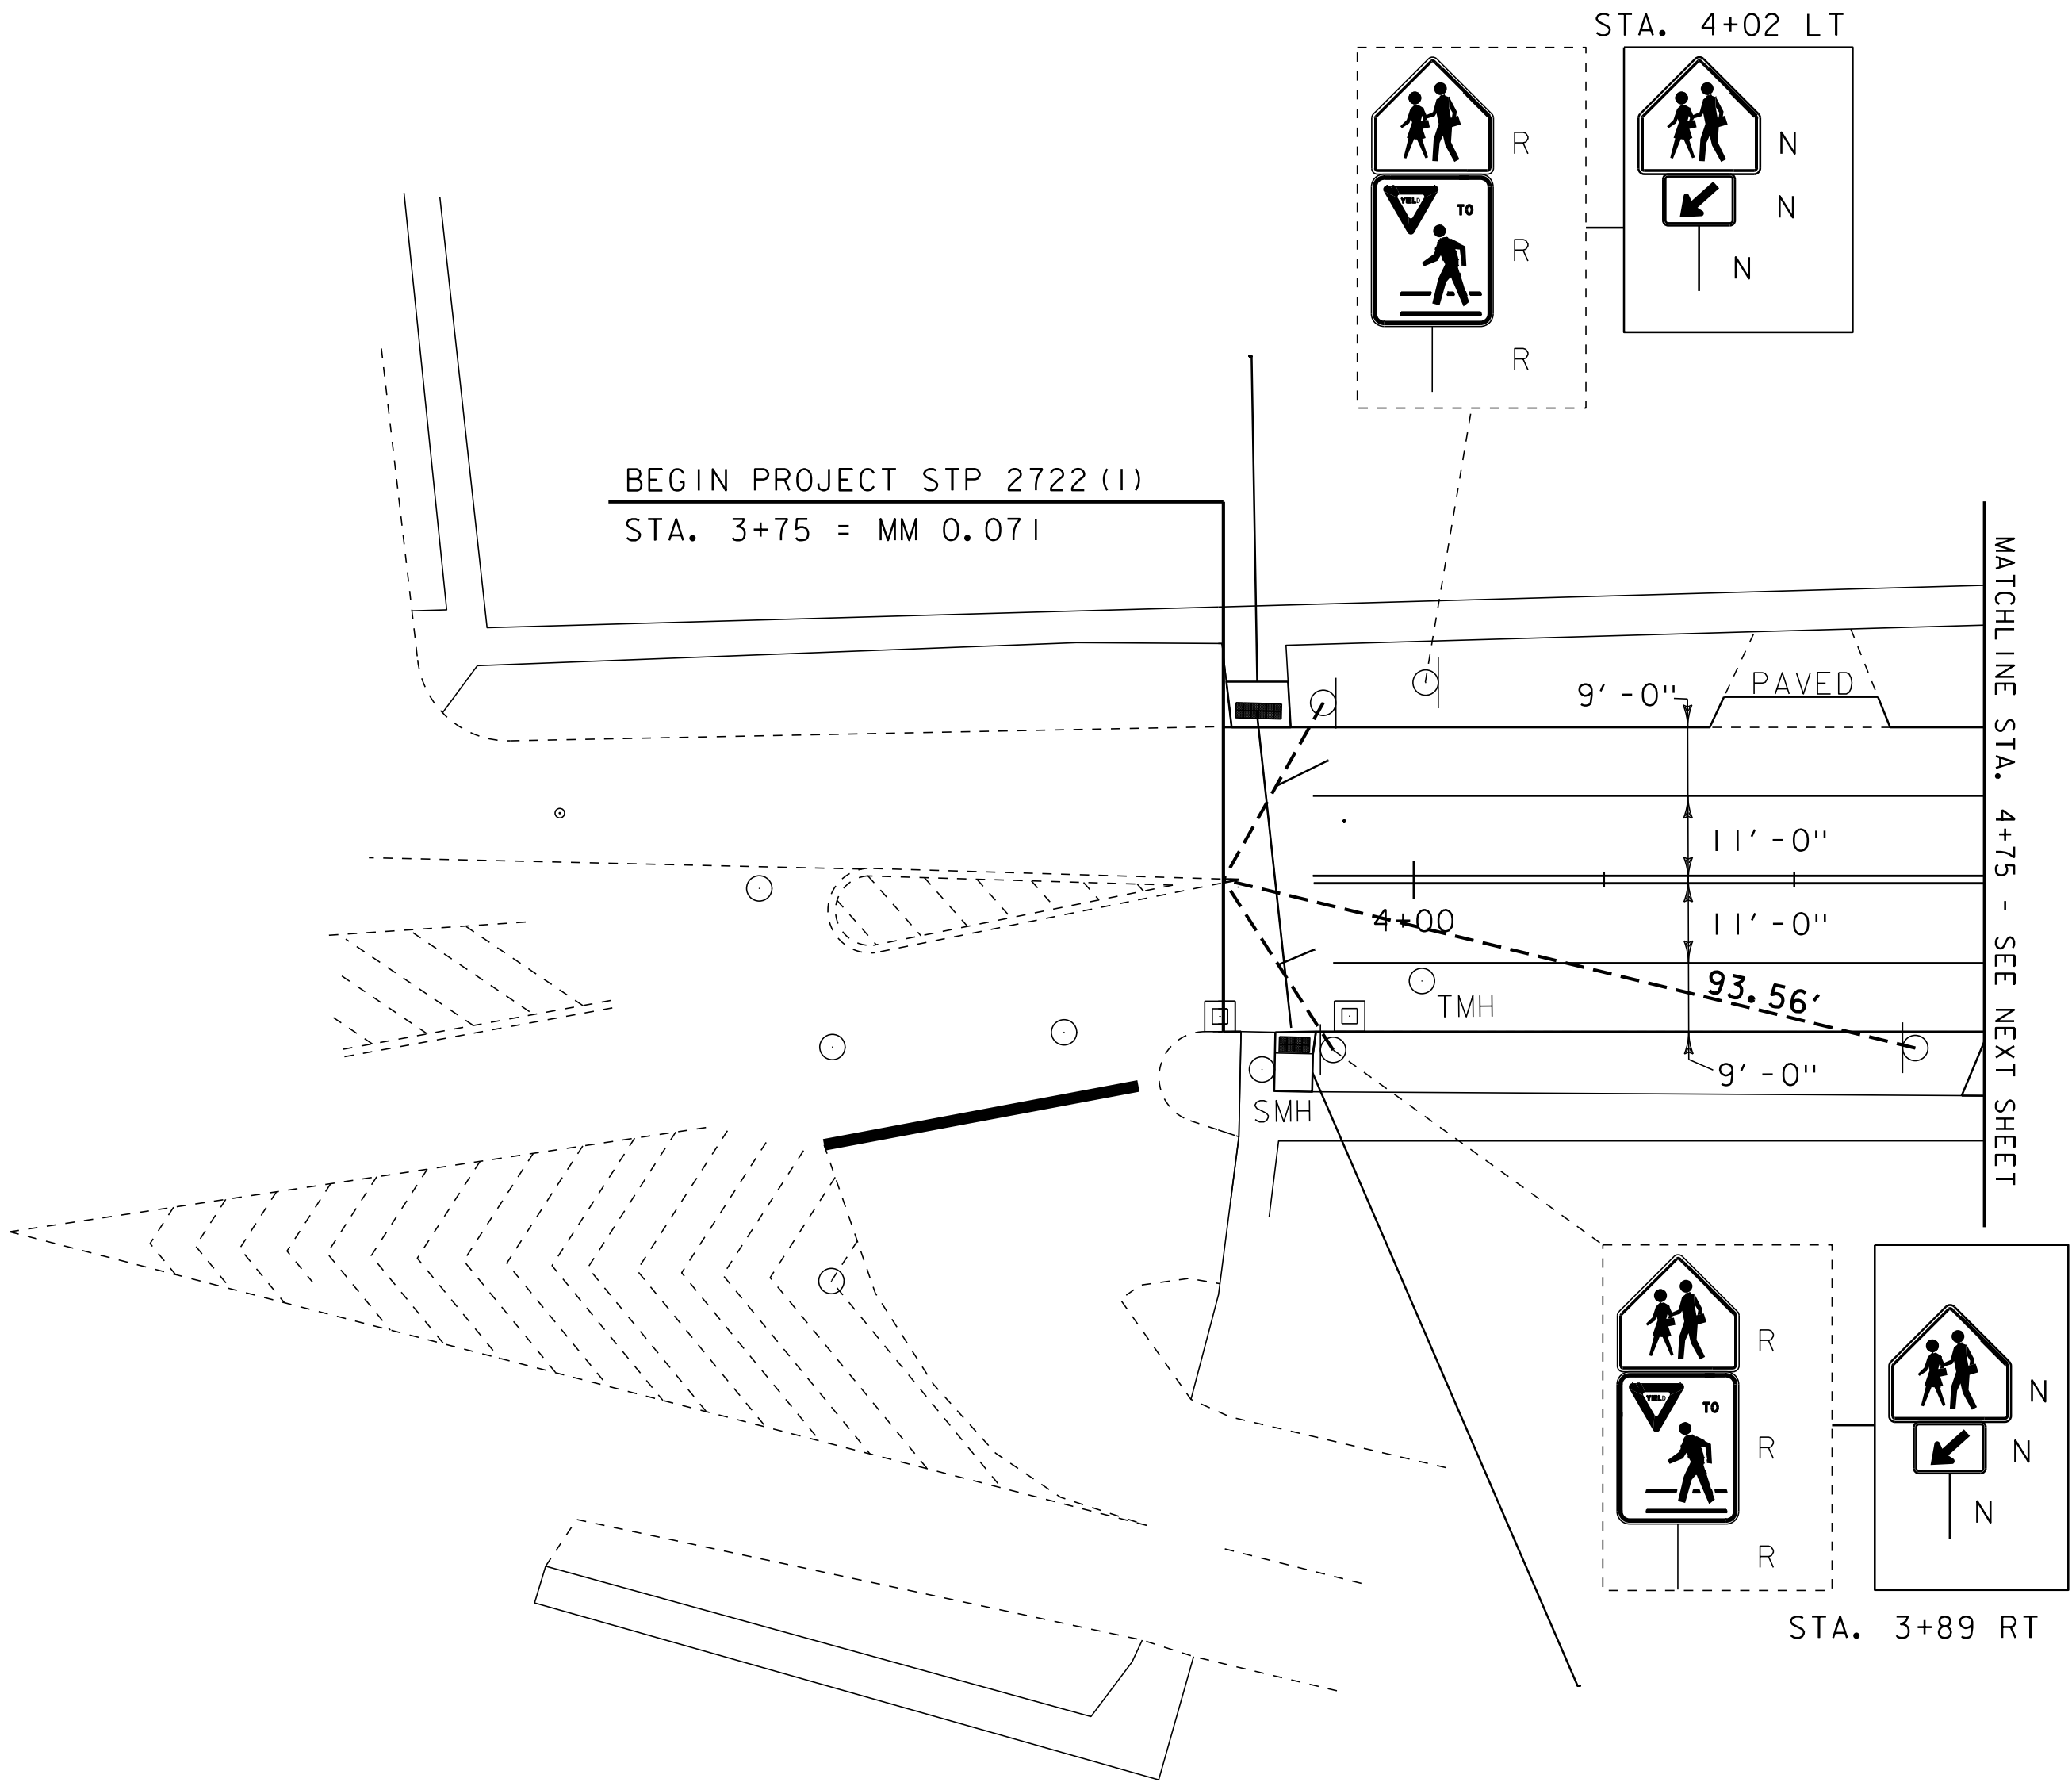

| LEGEND | | SIGN LEGEND | |
|--------|--------------------------|-------------|----------------------|
| ⊕ | HYDRANT | R | = REMOVE |
| ○ | MANHOLE | R&S | = REMOVE AND SALVAGE |
| ⊙ | VALVE | RET | = RETAIN |
| ⊙ | GAS PIPELINE MARKER | S | = SALVAGE |
| ⊠ | CATCH BASIN / DROP INLET | N | = NEW |
| — | CURB INLET | B-B | = BACK TO BACK |
| ⊠ | TRAFFIC CONTROL BOX | | |
| ⊕ | PARKING METER | | |
| VDZ | VIDEO DETECTION ZONE | | |
| → | VIDEO CAMERA | | |

NOT TO SCALE

| | | |
|---------------------------------------|------------------------------------|------------------------------|
| PROJECT LAYOUT SHEET 1 | PROJECT NAME: BURLINGTON (CLASS I) | PLOT DATE: 05-JUN-2014 11:20 |
| | PROJECT NUMBER: STP 2722 (I) | DRAWN BY: SJL |
| | FILE NAME: 07d028.dgn | CHECKED BY: EPD |
| | PROJECT LEADER: EPD | SHEET 15 OF 61 |
| | DESIGNED BY: CDL | |
| | PLOT FILE: 07d028_15.1 | |