

203.16 SOLID ROCK EXCAVATION
 STA. 36+24 - STA. 36+36 LT
 STA. 36+27 - STA. 36+32 RT
 STA. 36+32 - STA. 36+37 RT
 STA. 36+66 - STA. 36+82 LT
 STA. 36+68 - STA. 36+81 RT

604.42 CHANGING ELEVATION
 OF SEWER MANHOLES
 STA. 36+55 LT
 STA. 38+63 LT

629.20 ADJUST ELEVATION OF VALVE BOX
 STA. 36+24 RT (WSV) STA. 36+52 LT (WSV)
 STA. 36+26 RT (WSV) STA. 36+83 RT (WSV)
 STA. 36+46 RT (WSV)



646.491 DURABLE LETTER OR SYMBOL, TYPE I TAPE
 STA. 35+78 LT ARROW STA. 36+96 LT & RT "STOP"
 STA. 35+90 LT BIKE STA. 37+00 RT BIKE
 STA. 36+43 LT "STOP" STA. 37+12 RT ARROW
 STA. 36+60 RT "STOP"

646.692 TEMPORARY LETTER OR SYMBOL, PAINT
 STA. 35+78 LT ARROW STA. 36+96 LT & RT "STOP"
 STA. 35+90 LT BIKE STA. 37+00 RT BIKE
 STA. 36+43 LT "STOP" STA. 37+12 RT ARROW
 STA. 36+60 RT "STOP"

646.426 DURABLE 6" WHITE LINE, RECESSED POLYUREA
 STA. 34+75 - STA. 36+25 (SOLID LT)
 STA. 36+85 - STA. 40+75 (SOLID LT)

646.622 TEMPORARY 6" WHITE LINE, PAINT
 STA. 34+75 - STA. 36+25 (SOLID LT)
 STA. 36+85 - STA. 40+75 (SOLID LT)

STA. 36+34 LT

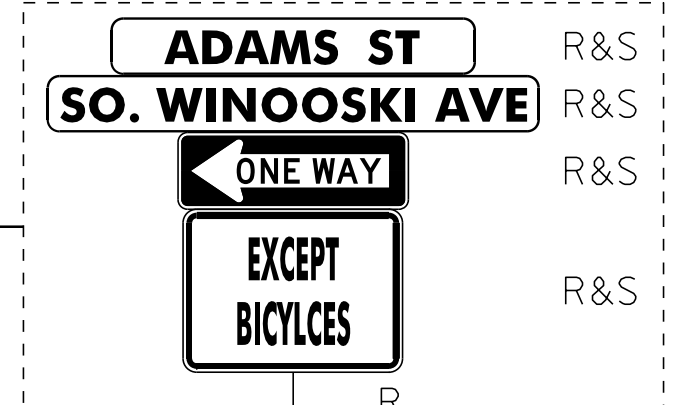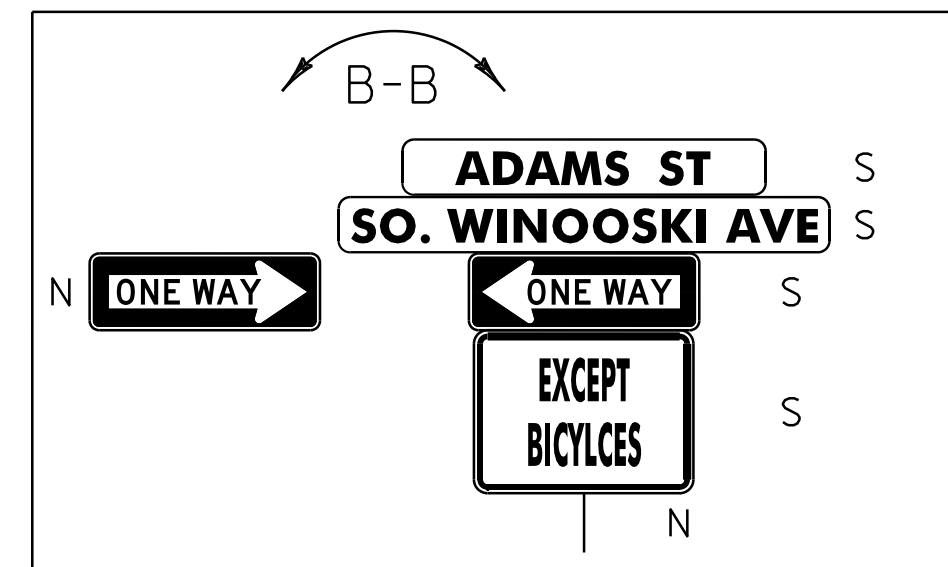

604.412, 604.415, 604.418 REHAB, DROP
 INLETS, CATCH BASINS, OR MANHOLES, CLASS I,
 CLASS II OR CLASS III
 STA. 36+37 RT "TYPE B GRATE"
 STA. 36+69 RT "TYPE D GRATE"
 STA. 36+84 LT "TYPE D GRATE"




646.406 DURABLE 4" WHITE LINE, RECESSED POLYUREA
 STA. 34+75 - STA. 36+15 (SOLID LT)
 STA. 36+90 - STA. 40+75 (SOLID LT)

646.436 DURABLE 6" YELLOW LINE, RECESSED POLYUREA
 STA. 34+75 - STA. 36+26 (CENTERLINE RT)
 STA. 36+87 - STA. 40+75 (CENTERLINE RT)

646.602 TEMPORARY 4" WHITE LINE, PAINT
 STA. 34+75 - STA. 36+15 (SOLID LT)
 STA. 36+90 - STA. 40+75 (SOLID LT)

646.632 TEMPORARY 6" YELLOW LINE, PAINT
 STA. 34+75 - STA. 36+26 (CENTERLINE RT)
 STA. 36+87 - STA. 40+75 (CENTERLINE RT)

STA. 36+18 LT

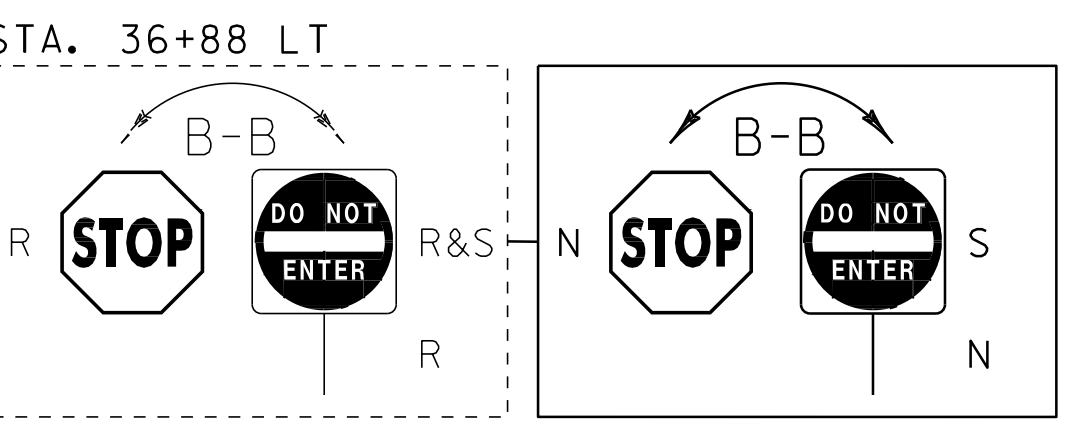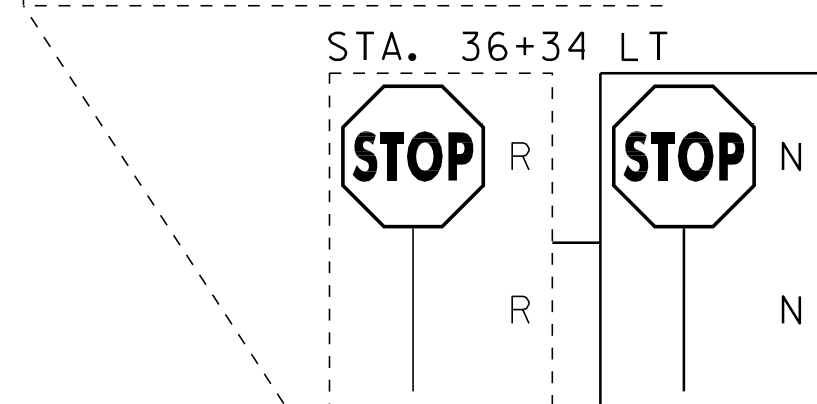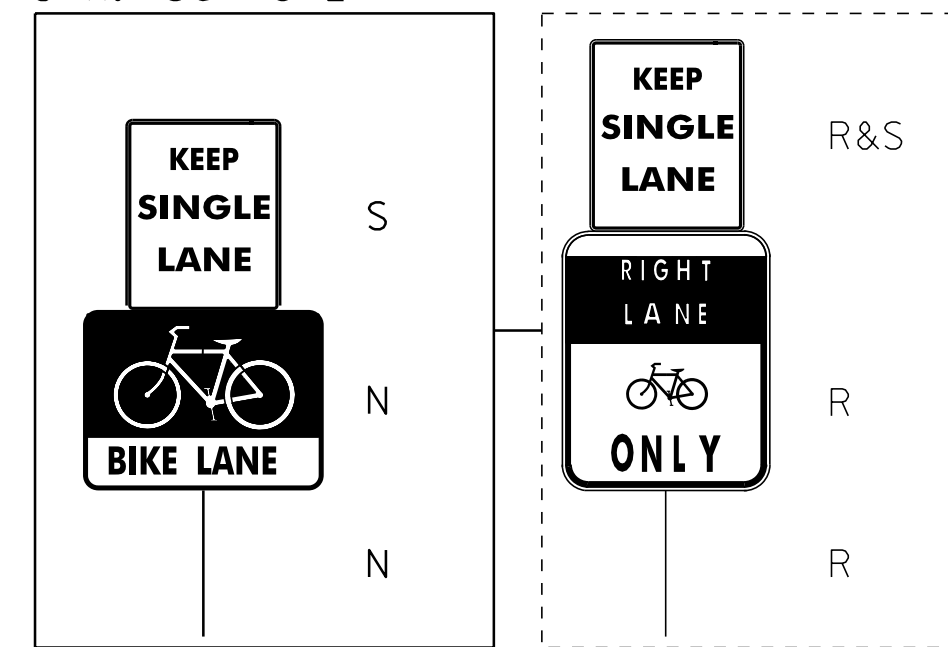



646.416 DURABLE 4" YELLOW LINE, RECESSED POLYUREA
 STA. 36+52 LT (CENTERLINE ADAMS ST.)
 STA. 36+52 RT (CENTERLINE ADAMS ST.)

675.50 REMOVING SIGNS
 AS SHOWN - 19

646.612 TEMPORARY 4" YELLOW LINE, PAINT
 STA. 36+52 LT (CENTERLINE ADAMS ST.)
 STA. 36+52 RT (CENTERLINE ADAMS ST.)



675.60 ERECTING SALVAGED SIGNS
 AS SHOWN - 12

REMOVE AND RECONSTRUCT
 SIDEWALK RAMP TYPE 6, EXAMPLE 3
 FROM STANDARD DRAWING C-3B

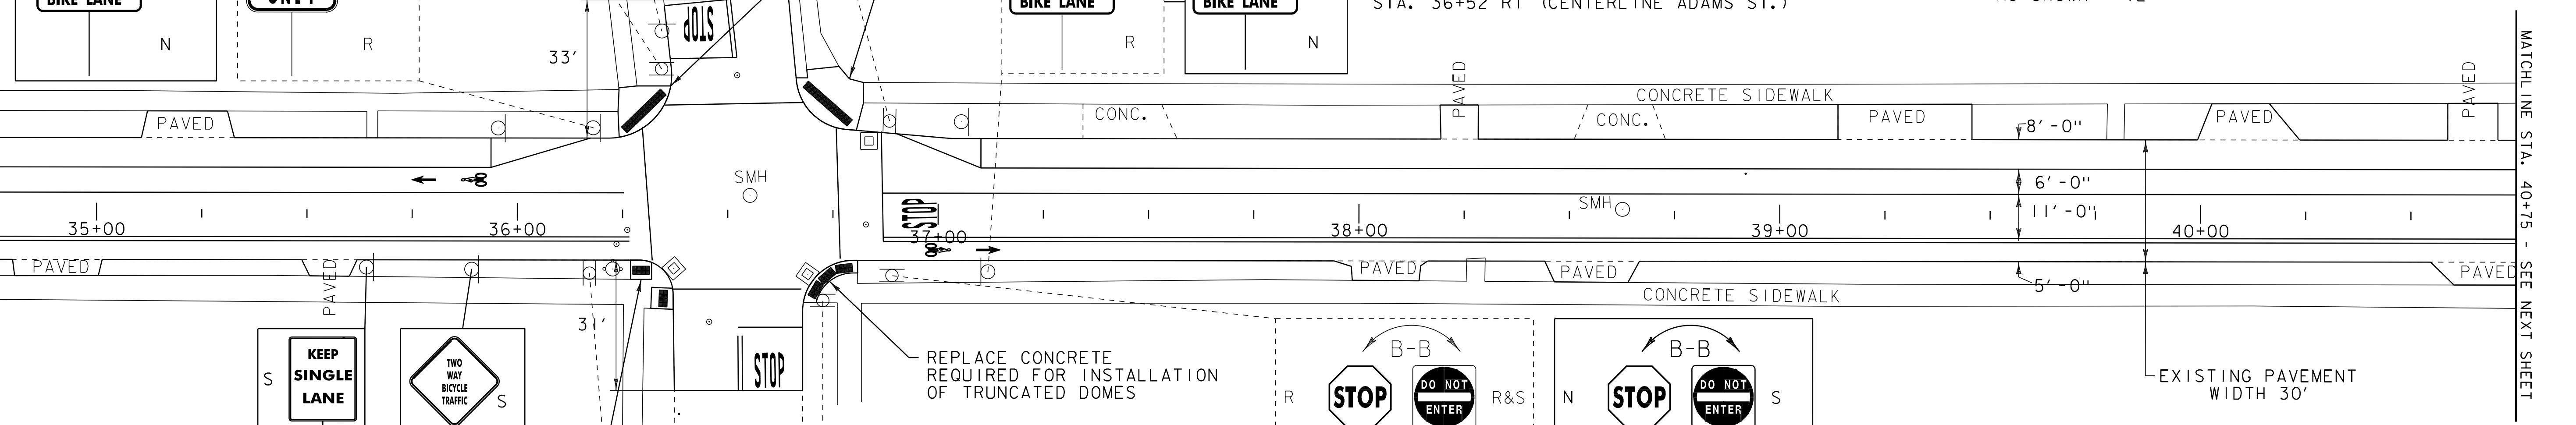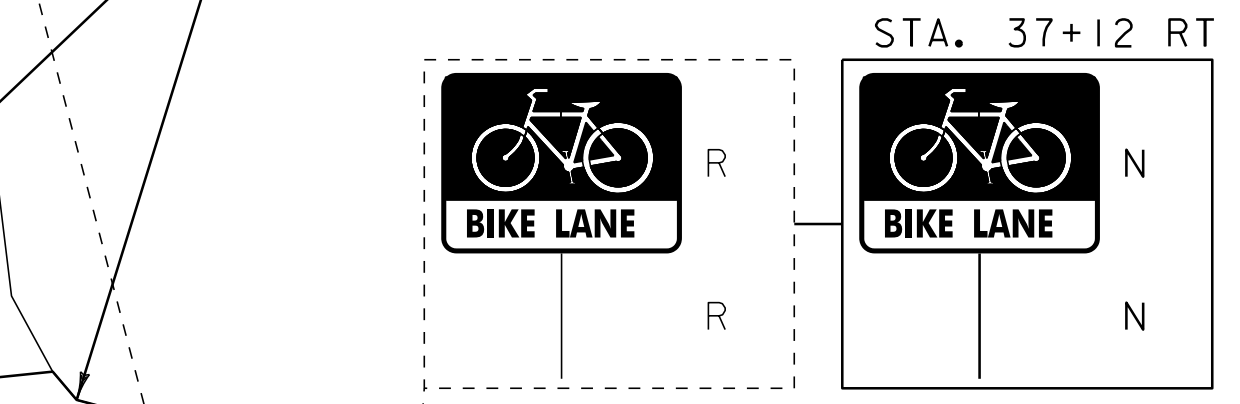

REPLACE CONCRETE
 REQUIRED FOR INSTALLATION
 OF TRUNCATED DOMES

REMOVE AND RECONSTRUCT
 SIDEWALK RAMP TYPE 6, EXAMPLE 3
 FROM STANDARD DRAWING C-3B

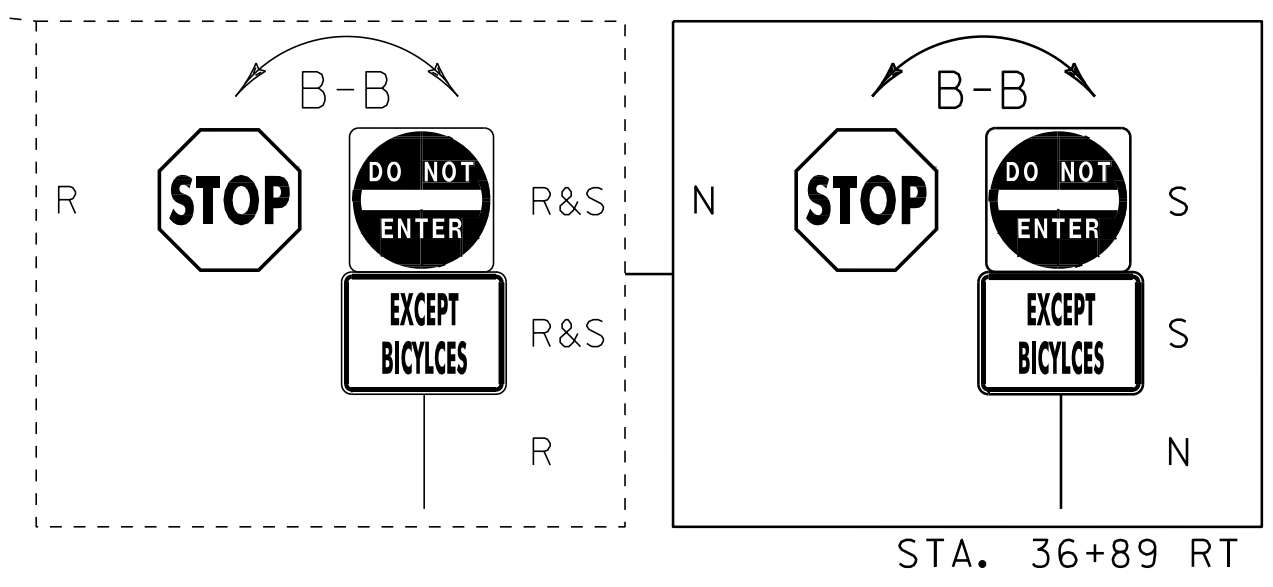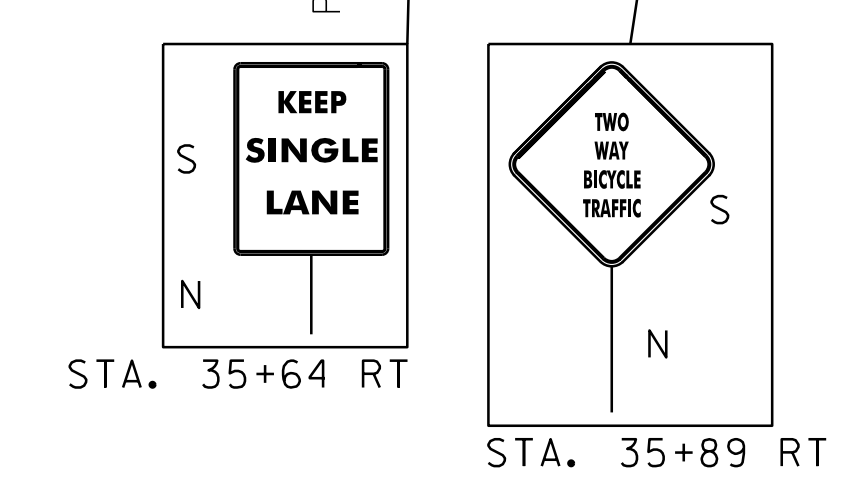

618.10 PORTLAND CEMENT
 CONCRETE SIDEWALK, 5 INCH
 STA. 36+24 - STA. 36+36 LT
 STA. 36+27 - STA. 36+32 RT
 STA. 36+32 - STA. 36+37 RT
 STA. 36+66 - STA. 36+82 LT
 STA. 36+68 - STA. 36+81 RT

618.30 DETECTABLE WARNING SURFACE
 STA. 36+27 LT STA. 36+70 LT
 STA. 36+29 RT STA. 36+71 RT
 STA. 36+32 LT STA. 36+73 RT
 STA. 36+35 RT STA. 36+77 LT
 STA. 36+78 RT

LEGEND

- HYDRANT
- MANHOLE
- VALVE
- GAS PIPELINE MARKER
- CATCH BASIN / DROP INLET
- CURB INLET
- ⊠ TRAFFIC CONTROL BOX
- ⊕ PARKING METER
- VDZ VIDEO DETECTION ZONE
- ➔ VIDEO CAMERA

SIGN LEGEND

- R = REMOVE
- R&S = REMOVE AND SALVAGE
- RET = RETAIN
- S = SALVAGE
- N = NEW
- B-B = BACK TO BACK

646.501 DURABLE CROSSWALK MARKING, TYPE I TAPE
 STA. 36+31 LT & RT
 STA. 36+35 - STA. 36+68 LT
 STA. 36+37 - STA. 36+67 RT
 STA. 36+76 LT & RT

646.486 DURABLE 24" STOP BAR, RECESSED POLYUREA
 STA. 36+37 - STA. 36+52 LT
 STA. 36+52 - STA. 36+68 RT
 STA. 36+86 LT & RT

646.702 TEMPORARY CROSSWALK MARKING, PAINT
 STA. 36+31 LT & RT
 STA. 36+35 - STA. 36+68 LT
 STA. 36+37 - STA. 36+67 RT
 STA. 36+76 LT & RT

646.682 TEMPORARY 24" STOP BAR, PAINT
 STA. 36+37 - STA. 36+52 LT
 STA. 36+52 - STA. 36+68 RT
 STA. 36+86 LT & RT

PROJECT LAYOUT SHEET 7

PROJECT NAME: BURLINGTON (CLASS I)
 PROJECT NUMBER: STP 2722 (I)

FILE NAME: 07d028.dgn PLOT DATE: 05-JUN-2014 11:20
 PROJECT LEADER: EPD DRAWN BY: SJL
 DESIGNED BY: CDL CHECKED BY: EPD
 PLOT FILE: 07d028.21.i SHEET 21 OF 61

NOT TO SCALE