

203.16 SOLID ROCK EXCAVATION
 STA. 41+95 - STA. 42+11 LT
 STA. 41+95 - STA. 42+12 RT
 STA. 42+41 - STA. 42+53 RT
 STA. 42+41 - STA. 42+54 LT
 STA. 45+77 - STA. 45+85 RT
 STA. 45+81 - STA. 45+93 LT
 STA. 46+15 - STA. 46+25 RT
 STA. 46+21 - STA. 46+32 LT

618.10 PORTLAND CEMENT CONCRETE SIDEWALK, 5 INCH
 STA. 41+95 - STA. 42+11 LT
 STA. 41+95 - STA. 42+12 RT
 STA. 42+41 - STA. 42+53 RT
 STA. 42+41 - STA. 42+54 LT
 STA. 45+77 - STA. 45+85 RT
 STA. 45+81 - STA. 45+93 LT
 STA. 46+15 - STA. 46+25 RT
 STA. 46+21 - STA. 46+32 LT

618.30 DETECTABLE WARNING SURFACE
 STA. 41+99 RT STA. 42+50 RT
 STA. 42+00 LT STA. 45+80 RT
 STA. 42+04 RT STA. 45+83 RT
 STA. 42+05 LT STA. 45+84 LT
 STA. 42+08 LT STA. 45+89 LT
 STA. 42+09 RT STA. 46+19 RT
 STA. 42+43 LT STA. 46+23 LT
 STA. 42+44 RT STA. 46+23 RT
 STA. 42+49 LT STA. 46+28 LT

629.20 ADJUST ELEVATION OF VALVE BOX
 STA. 41+90 RT (WSV) STA. 45+73 RT (WSV)
 STA. 41+92 LT (WSV) STA. 45+74 RT (WSV)
 STA. 42+32 LT (WSV) STA. 45+87 RT (GSV)
 STA. 42+35 RT (WSV) STA. 45+97 LT (GSV)
 STA. 42+58 RT (WSV) STA. 45+99 LT (GSV)
 STA. 43+75 LT (WSV) STA. 46+11 RT (WSV)
 STA. 45+21 RT (WSV) STA. 46+29 RT (WSV)

646.682 TEMPORARY 24" STOP BAR, PAINT
 STA. 42+11 - 42+26 LT STA. 45+94 - 46+07 LT
 STA. 42+26 - 42+41 RT STA. 45+99 - 46+14 RT
 STA. 42+59 LT STA. 46+36 LT
 STA. 45+71 RT

INTERIM COMPLETION @ STA 45+90 IN 2010

604.42 CHANGING ELEVATION OF SEWER MANHOLES
 STA. 41+31 LT STA. 46+07 CL
 STA. 42+26 LT STA. 46+17 RT
 STA. 46+07 LT STA. 46+43 CL

646.486 DURABLE 24" STOP BAR, RECESSED POLYUREA
 STA. 42+11 - 42+26 LT STA. 45+94 - 46+07 LT
 STA. 42+26 - 42+41 RT STA. 45+99 - 46+14 RT
 STA. 42+59 LT STA. 46+36 LT
 STA. 45+71 RT


604.412, 604.415, 604.418 REHAB, DROP INLETS, CATCH BASINS, OR MANHOLES, CLASS I, CLASS II OR CLASS III
 STA. 42+11 RT "TYPE D GRATE"
 STA. 42+39 RT "TYPE D GRATE"
 STA. 45+77 LT "TYPE D GRATE"
 STA. 45+83 RT "TYPE D GRATE"
 STA. 46+24 RT "TYPE D GRATE"
 STA. 46+35 LT "TYPE D GRATE"

646.426 DURABLE 6" WHITE LINE, RECESSED POLYUREA
 STA. 40+75 - STA. 41+94 (SOLID LT)

646.622 TEMPORARY 6" WHITE LINE, PAINT
 STA. 40+75 - STA. 41+94 (SOLID LT)

604.40 CHANGING ELEVATION OF DROP INLETS, CATCH BASINS, OR MANHOLES
 STA. 45+98 RT (TEL.)

900.620 SPECIAL PROVISION (REMOVE PARKING METER)
 STA. 46+57 RT

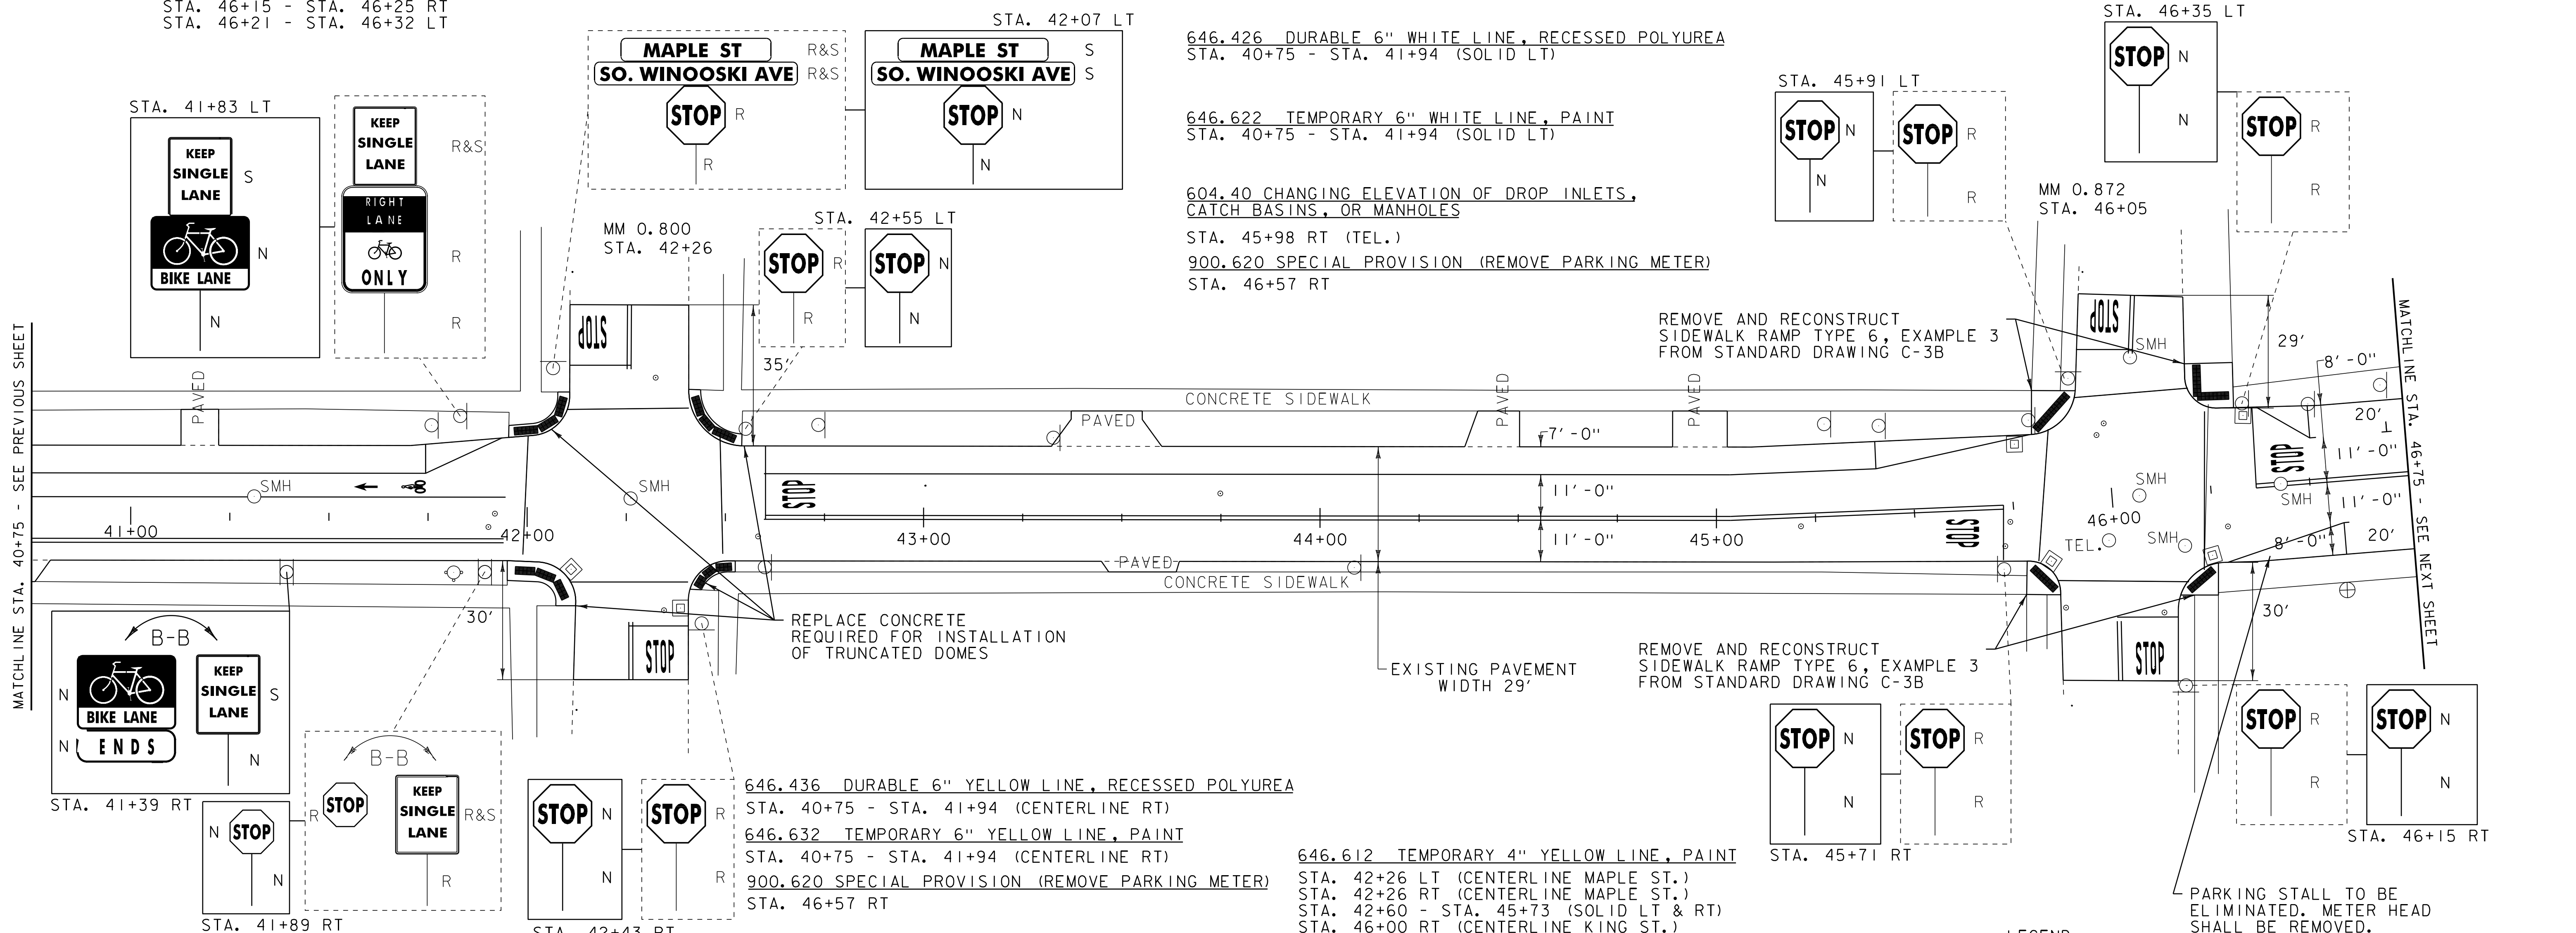

MATCHLINE STA. 40+75 - SEE PREVIOUS SHEET

MATCHLINE STA. 46+75 - SEE NEXT SHEET

646.491 DURABLE LETTER OR SYMBOL, TYPE I TAPE
 STA. 41+59 LT ARROW STA. 45+62 RT "STOP"
 STA. 41+71 LT BIKE STA. 46+02 LT "STOP"
 STA. 42+16 LT "STOP" STA. 46+06 RT "STOP"
 STA. 42+34 RT "STOP" STA. 46+45 LT "STOP"
 STA. 42+69 LT "STOP"

646.692 TEMPORARY LETTER OR SYMBOL, PAINT
 STA. 41+59 LT ARROW STA. 45+62 RT "STOP"
 STA. 41+71 LT BIKE STA. 46+02 LT "STOP"
 STA. 42+16 LT "STOP" STA. 46+06 RT "STOP"
 STA. 42+34 RT "STOP" STA. 46+45 LT "STOP"
 STA. 42+69 LT "STOP"

646.436 DURABLE 6" YELLOW LINE, RECESSED POLYUREA
 STA. 40+75 - STA. 41+94 (CENTERLINE RT)

646.632 TEMPORARY 6" YELLOW LINE, PAINT
 STA. 40+75 - STA. 41+94 (CENTERLINE RT)

900.620 SPECIAL PROVISION (REMOVE PARKING METER)
 STA. 46+57 RT

646.406 DURABLE 4" WHITE LINE, RECESSED POLYUREA
 STA. 40+75 - STA. 41+94 (SOLID LT)
 STA. 42+60 - STA. 45+79 (SOLID LT)
 STA. 46+36 - STA. 46+75 LT (PARKING STALLS)
 STA. 46+27 - STA. 46+75 RT (PARKING STALLS)

646.602 TEMPORARY 4" WHITE LINE, PAINT
 STA. 40+75 - STA. 41+94 (SOLID LT)
 STA. 42+60 - STA. 45+79 (SOLID LT)
 STA. 46+36 - STA. 46+75 LT (PARKING STALLS)
 STA. 46+27 - STA. 46+75 RT (PARKING STALLS)

646.416 DURABLE 4" YELLOW LINE, RECESSED POLYUREA
 STA. 42+26 LT (CENTERLINE MAPLE ST.)
 STA. 42+26 RT (CENTERLINE MAPLE ST.)
 STA. 42+60 - STA. 45+73 (SOLID LT & RT)
 STA. 46+00 RT (CENTERLINE KING ST.)
 STA. 46+07 LT (CENTERLINE KING ST.)
 STA. 46+36 - STA. 46+75 (SOLID LT & RT)

646.612 TEMPORARY 4" YELLOW LINE, PAINT
 STA. 42+26 LT (CENTERLINE MAPLE ST.)
 STA. 42+26 RT (CENTERLINE MAPLE ST.)
 STA. 42+60 - STA. 45+73 (SOLID LT & RT)
 STA. 46+00 RT (CENTERLINE KING ST.)
 STA. 46+07 LT (CENTERLINE KING ST.)
 STA. 46+36 - STA. 46+75 (SOLID LT & RT)

646.501 DURABLE CROSSWALK MARKING, TYPE I TAPE
 STA. 42+00 LT & RT STA. 45+83 LT & RT
 STA. 42+10 - STA. 42+41 LT STA. 45+85 - STA. 46+18 RT
 STA. 42+11 - STA. 42+41 RT STA. 45+92 - STA. 46+21 LT
 STA. 42+49 LT & RT STA. 46+24 LT & RT

646.702 TEMPORARY CROSSWALK MARKING, PAINT
 STA. 42+00 LT & RT STA. 45+83 LT & RT
 STA. 42+10 - STA. 42+41 LT STA. 45+85 - STA. 46+18 RT
 STA. 42+11 - STA. 42+41 RT STA. 45+92 - STA. 46+21 LT
 STA. 42+49 LT & RT STA. 46+24 LT & RT

675.50 REMOVING SIGNS
 AS SHOWN - 13

675.60 ERECTING SALVAGED SIGNS
 AS SHOWN - 4

LEGEND	
○	HYDRANT
○	MANHOLE
○	VALVE
○	GAS PIPELINE MARKER
□	CATCH BASIN / DROP INLET
—	CURB INLET
⊠	TRAFFIC CONTROL BOX
⊕	PARKING METER
VDZ	VIDEO DETECTION ZONE
→	VIDEO CAMERA
SIGN LEGEND	
R	= REMOVE
R&S	= REMOVE AND SALVAGE
RET	= RETAIN
S	= SALVAGE
N	= NEW
B-B	= BACK TO BACK

PROJECT LAYOUT SHEET 8

PROJECT NAME: BURLINGTON (CLASS I)
 PROJECT NUMBER: STP 2722 (I)
 FILE NAME: 07d028.dgn PLOT DATE: 05-JUN-2014 11:20
 PROJECT LEADER: EPD DRAWN BY: SJL
 DESIGNED BY: CDL CHECKED BY: EPD
 PLOT FILE: 07d028.22.i SHEET 22 OF 61

NOT TO SCALE